


1-15361-E

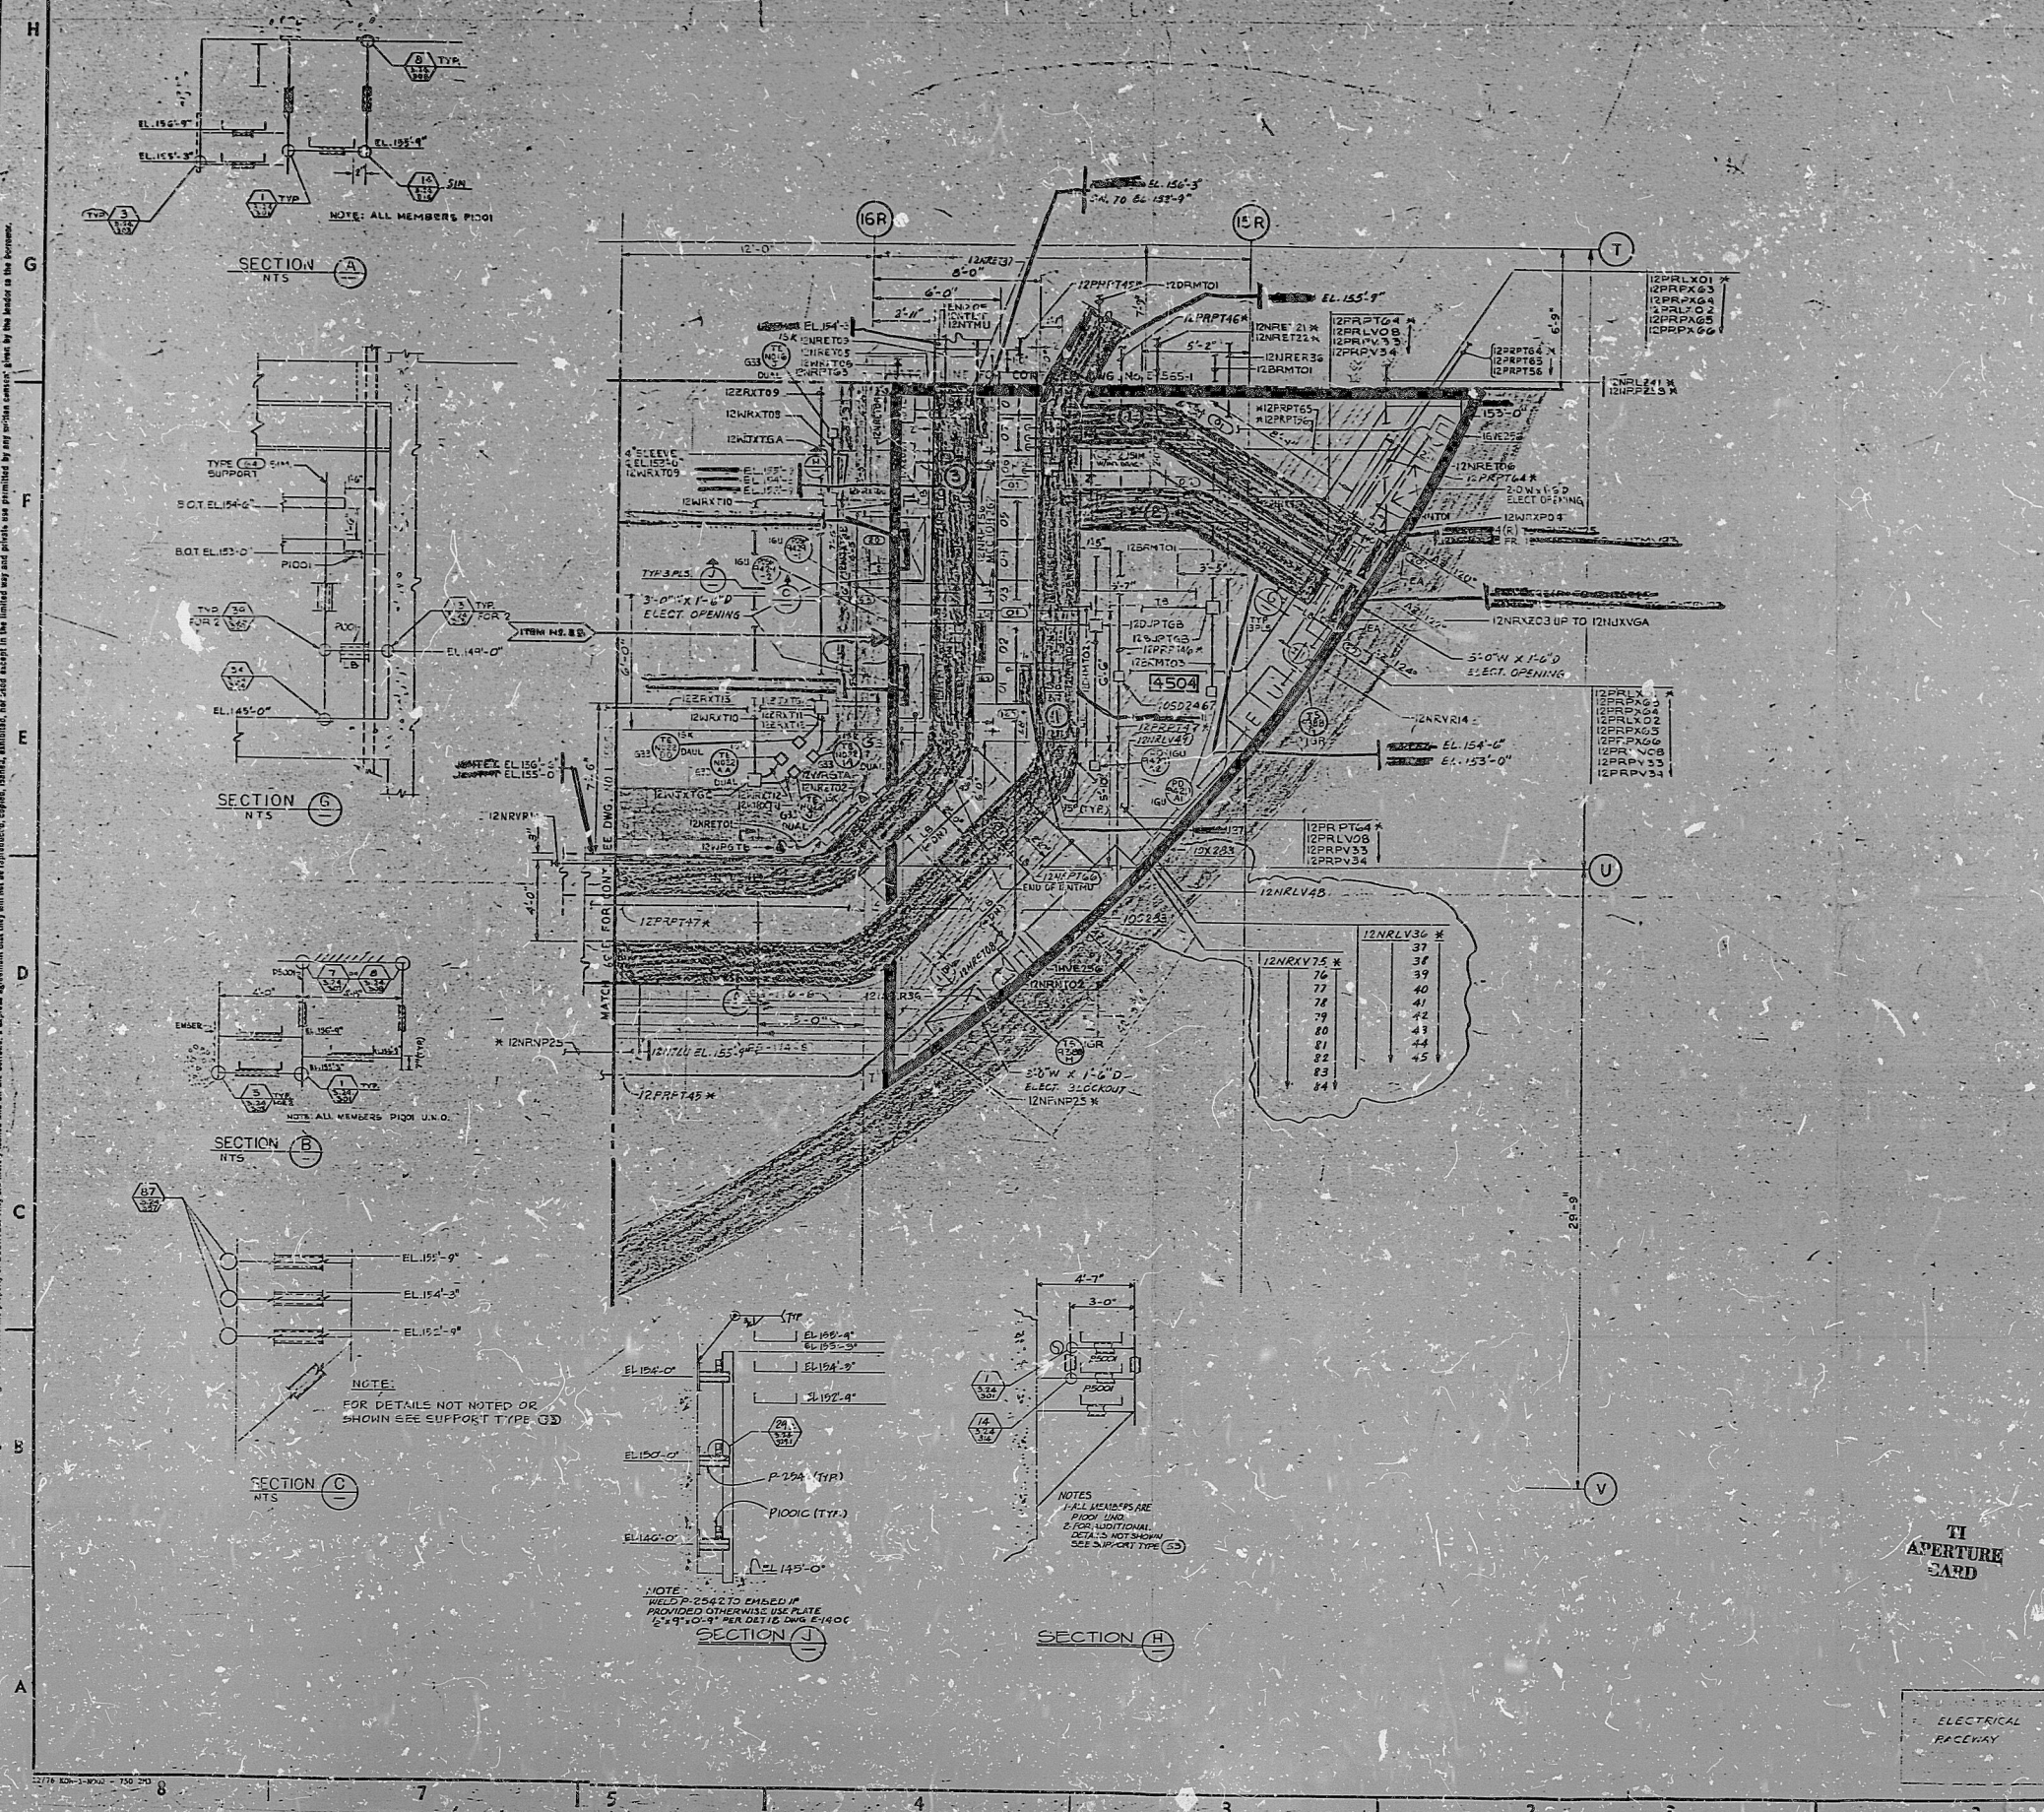

KEY PLAN

1	2	3	4	5	6	7	8
9	10	11	12	13	14	15	16
17	18	19	20	21	22	23	24
25	26	27	28	29	30	31	32
33	34	35	36	37	38	39	40
41	42	43	44	45	46	47	48
49	50	51	52	53	54	55	56
57	58	59	60	61	62	63	64
65	66	67	68	69	70	71	72
73	74	75	76	77	78	79	80
81	82	83	84	85	86	87	88
89	90	91	92	93	94	95	96
97	98	99	100	101	102	103	104

- NOTES
1. ALL CABLE TRAYS ARE 24" UNLESS SHOWN OTHERWISE.
 2. CABLE RACEWAY-TRAY & CONDUIT ETC. ARE IDENTIFIED FOR "Q" LISTED INSTALLATION BY LETTERS A, B, C, D, AND "Q" IN THE THIRD CHARACTER OF THE RACEWAY NUMBER.
 3. FOR INSTALLATION DETAIL OF NON-STANDARD ELBOWS FOR CABLE TRAYS, SEE FIG. E-H'16-C, SH. S. 54-355.
 4. ALL FIRE PROTECTORS ARE MOUNTED ON THE CEILING.

- REFERENCE DRAWINGS
- P-1905-1 - PIPING
 - C-0591-1 - CIVIL-STRUCTURAL
 - P-9194-1 - HEATING & VENTILATING
 - D-8155-1 - PLUMBING
 - S-1406-C - RACEWAY NOTES, SYMBOLS & DETAILS
 - C-0805-1 - STRUCTURAL STEEL FLOOR FRAMING PLAN



BECHTEL
SAN FRANCISCO

PUBLIC SERVICE ELECTRIC AND GAS COMPANY
HOPL CREEK GENERATING STATION

RACEWAY PLAN
REACTOR BLDG. AREA 19
PLAN AT EL. 155'

10855 E-15361-E

TI APERTURE CARD

ELECTRICAL RACEWAY

This drawing and the design it contains are the property of BECHTEL. They are hereby loaned to the borrower's project agreement that they may not be reproduced, copied, issued, published, or used in any way not permitted by the borrower in the borrower's project agreement.

8409040369

PDR RIDS

