


E-566-1  
SHEET 2 OF 3

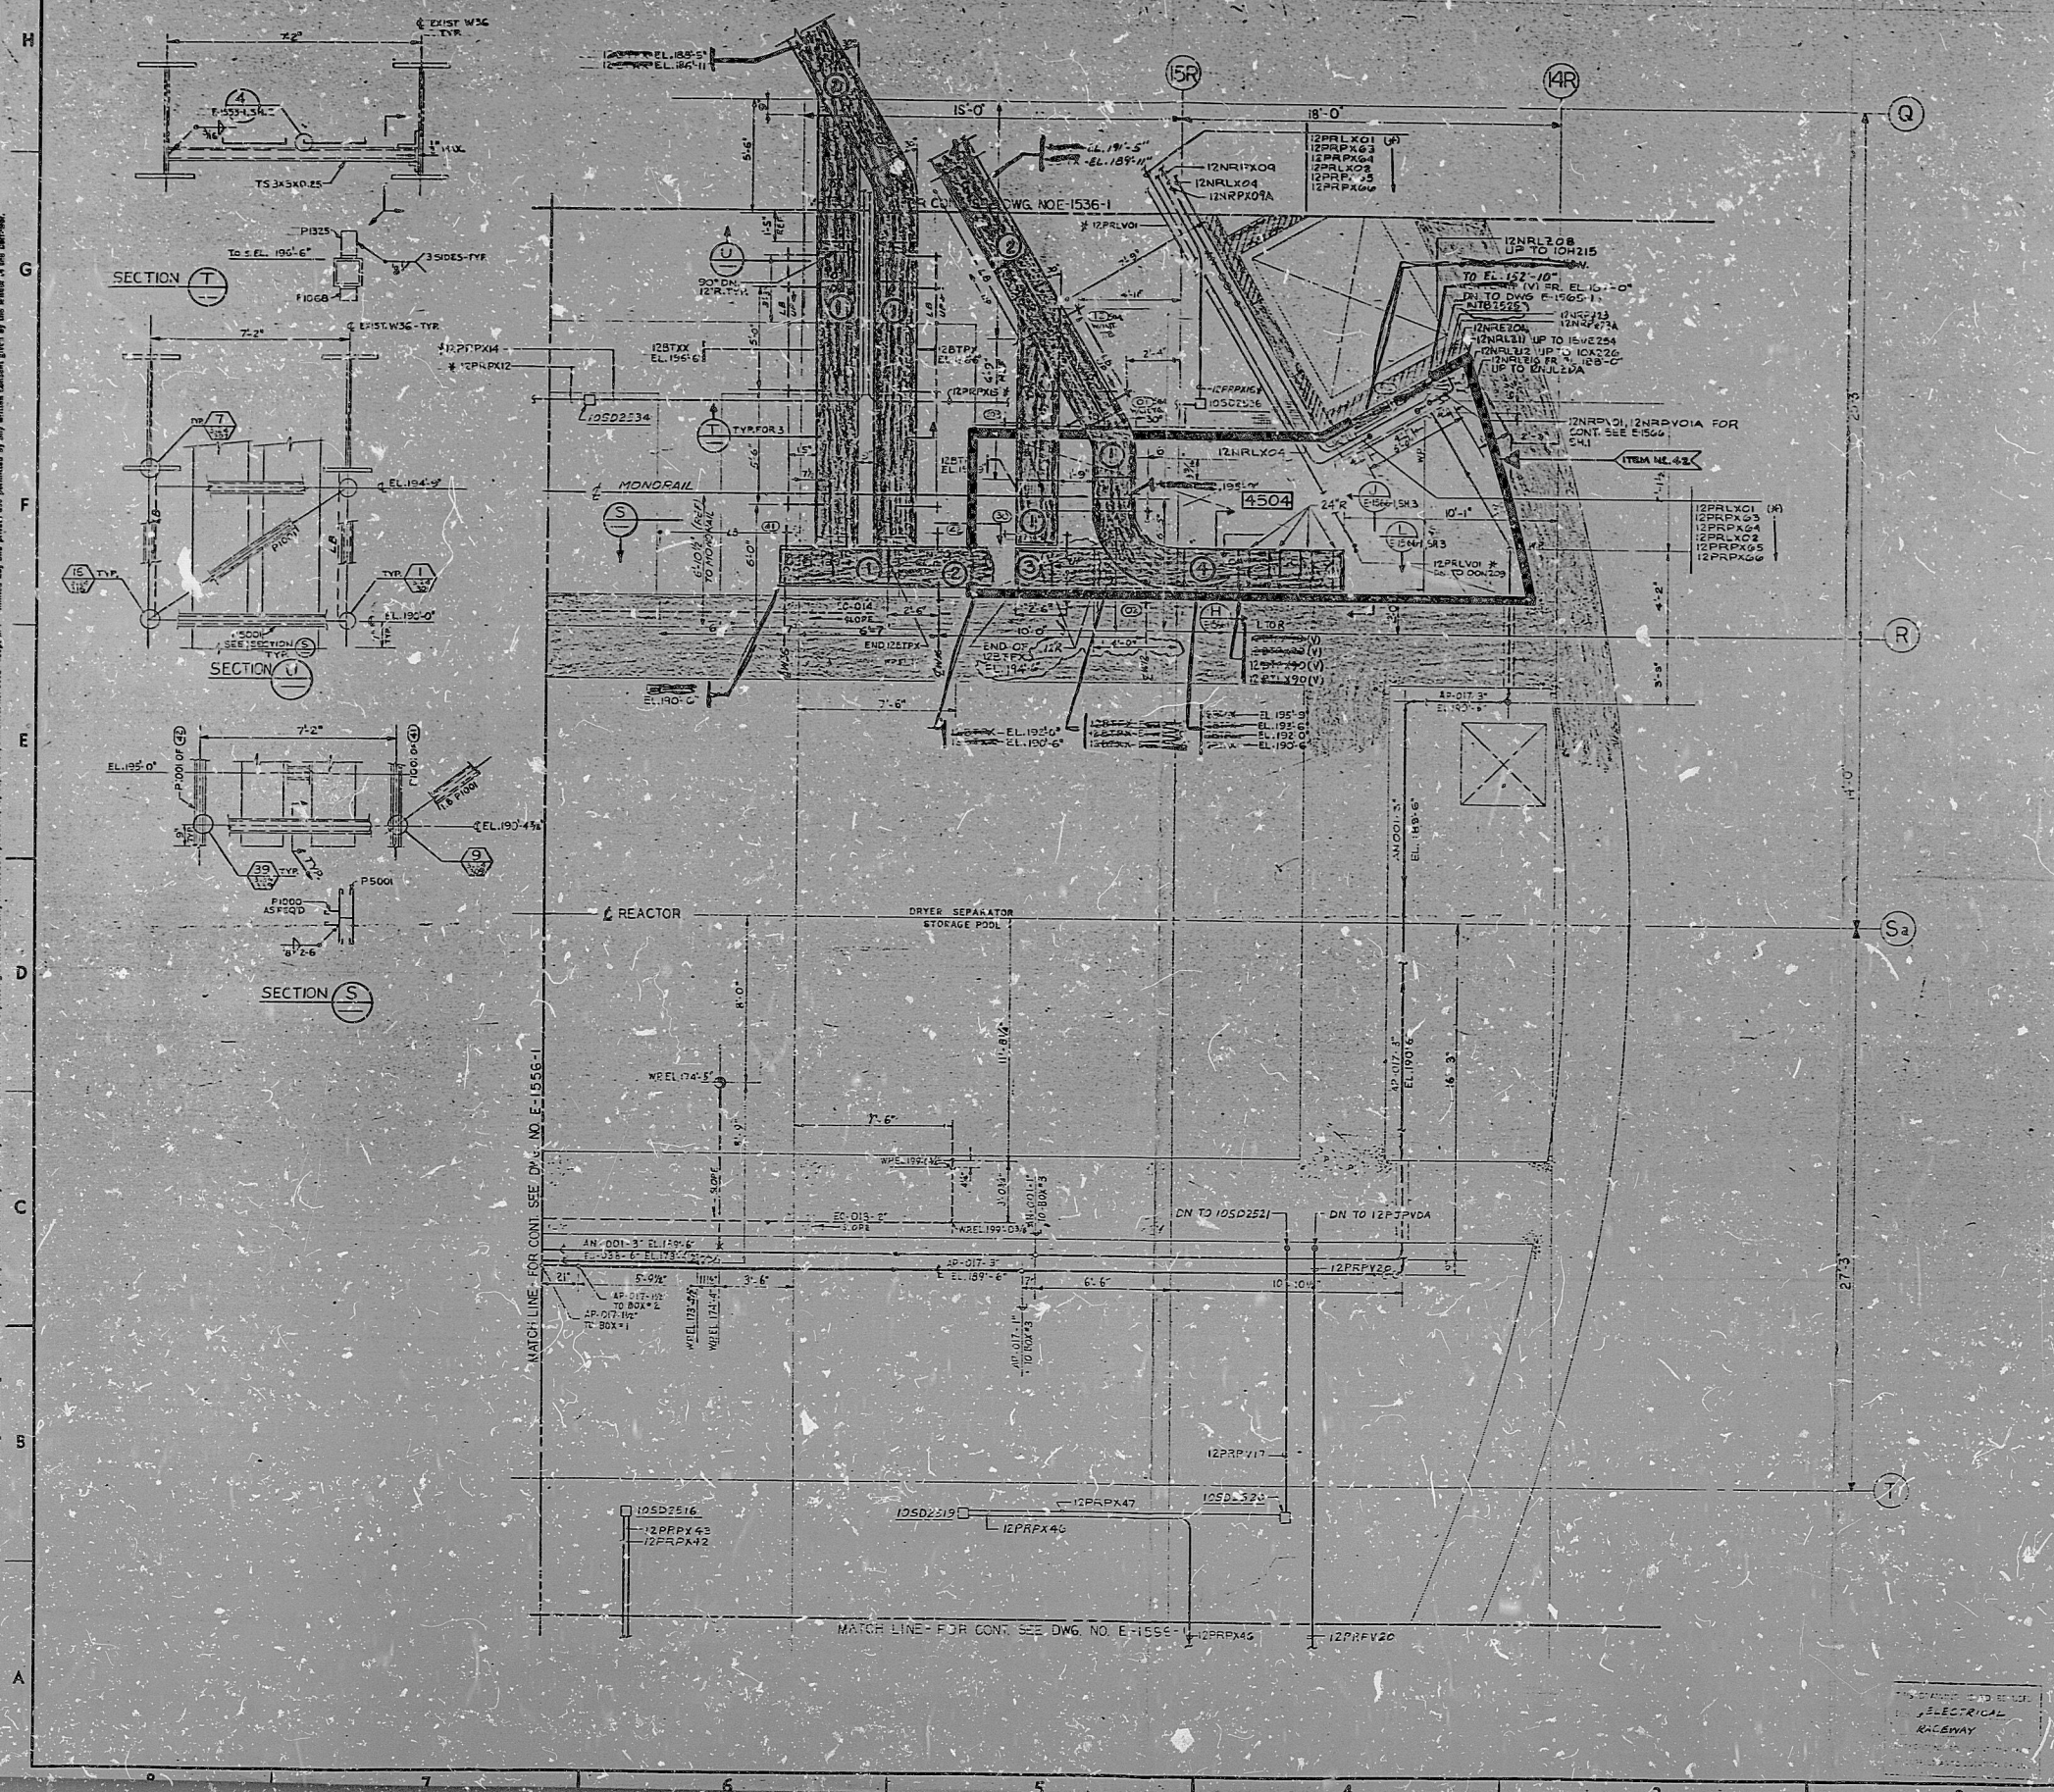

OUTDOOR


PLAN  
KEY PLAN

NOTES:

- ALL CABLE TRAYS ARE 24" UNLESS SHOWN OTHERWISE.
- CLASS 1E RACEWAY TRAY & CONDUIT, ETC., ARE IDENTIFIED FOR "Q" LISTED INSTALLATION BY LETTERS A, B, C, D, W, X, Y OR Z, IN THE THIRD CHARACTER OF THE RACEWAY NUMBER.
- ALL FIRE DETECTORS ARE MOUNTED ON THE CEILING.

REFERENCE DRAWINGS

- P-1507-1 — PIPING
- C-0630-1 — CIVIL-STRUCTURAL
- P-9167-1 — HEATING & VENTILATING
- P-8167-1 — PLUMBING
- E-1405-0 — RACEWAY NOTES, SYMBOLS & DETAILS
- C-0813-1 — STRUCTURAL STEEL FLOOR FRAMING PLAN

TI APERTURE CARD

1	REVISIONS	DATE	BY
1	ISSUED FOR CONSTRUCTION	10/15/74	...

BECHTEL  
SAN FRANCISCO

PUBLIC SERVICE ELECTRIC & GAS COMPANY  
HOPE CREEK GENERATING STATION

RACEWAY PLAN  
REACTOR BLDG AREA 16  
PLAN AT EL. 79'-6"

10355 E-566-1 1510  
SHEET 2 OF 3  
1 FEB 74

22"  
17"  
11"  
8.5"  
8.5"  
11"  
8.5"  
11"  
17"  
22"




8409040403

PDR RIDS

