



No. 10080-RE-42C

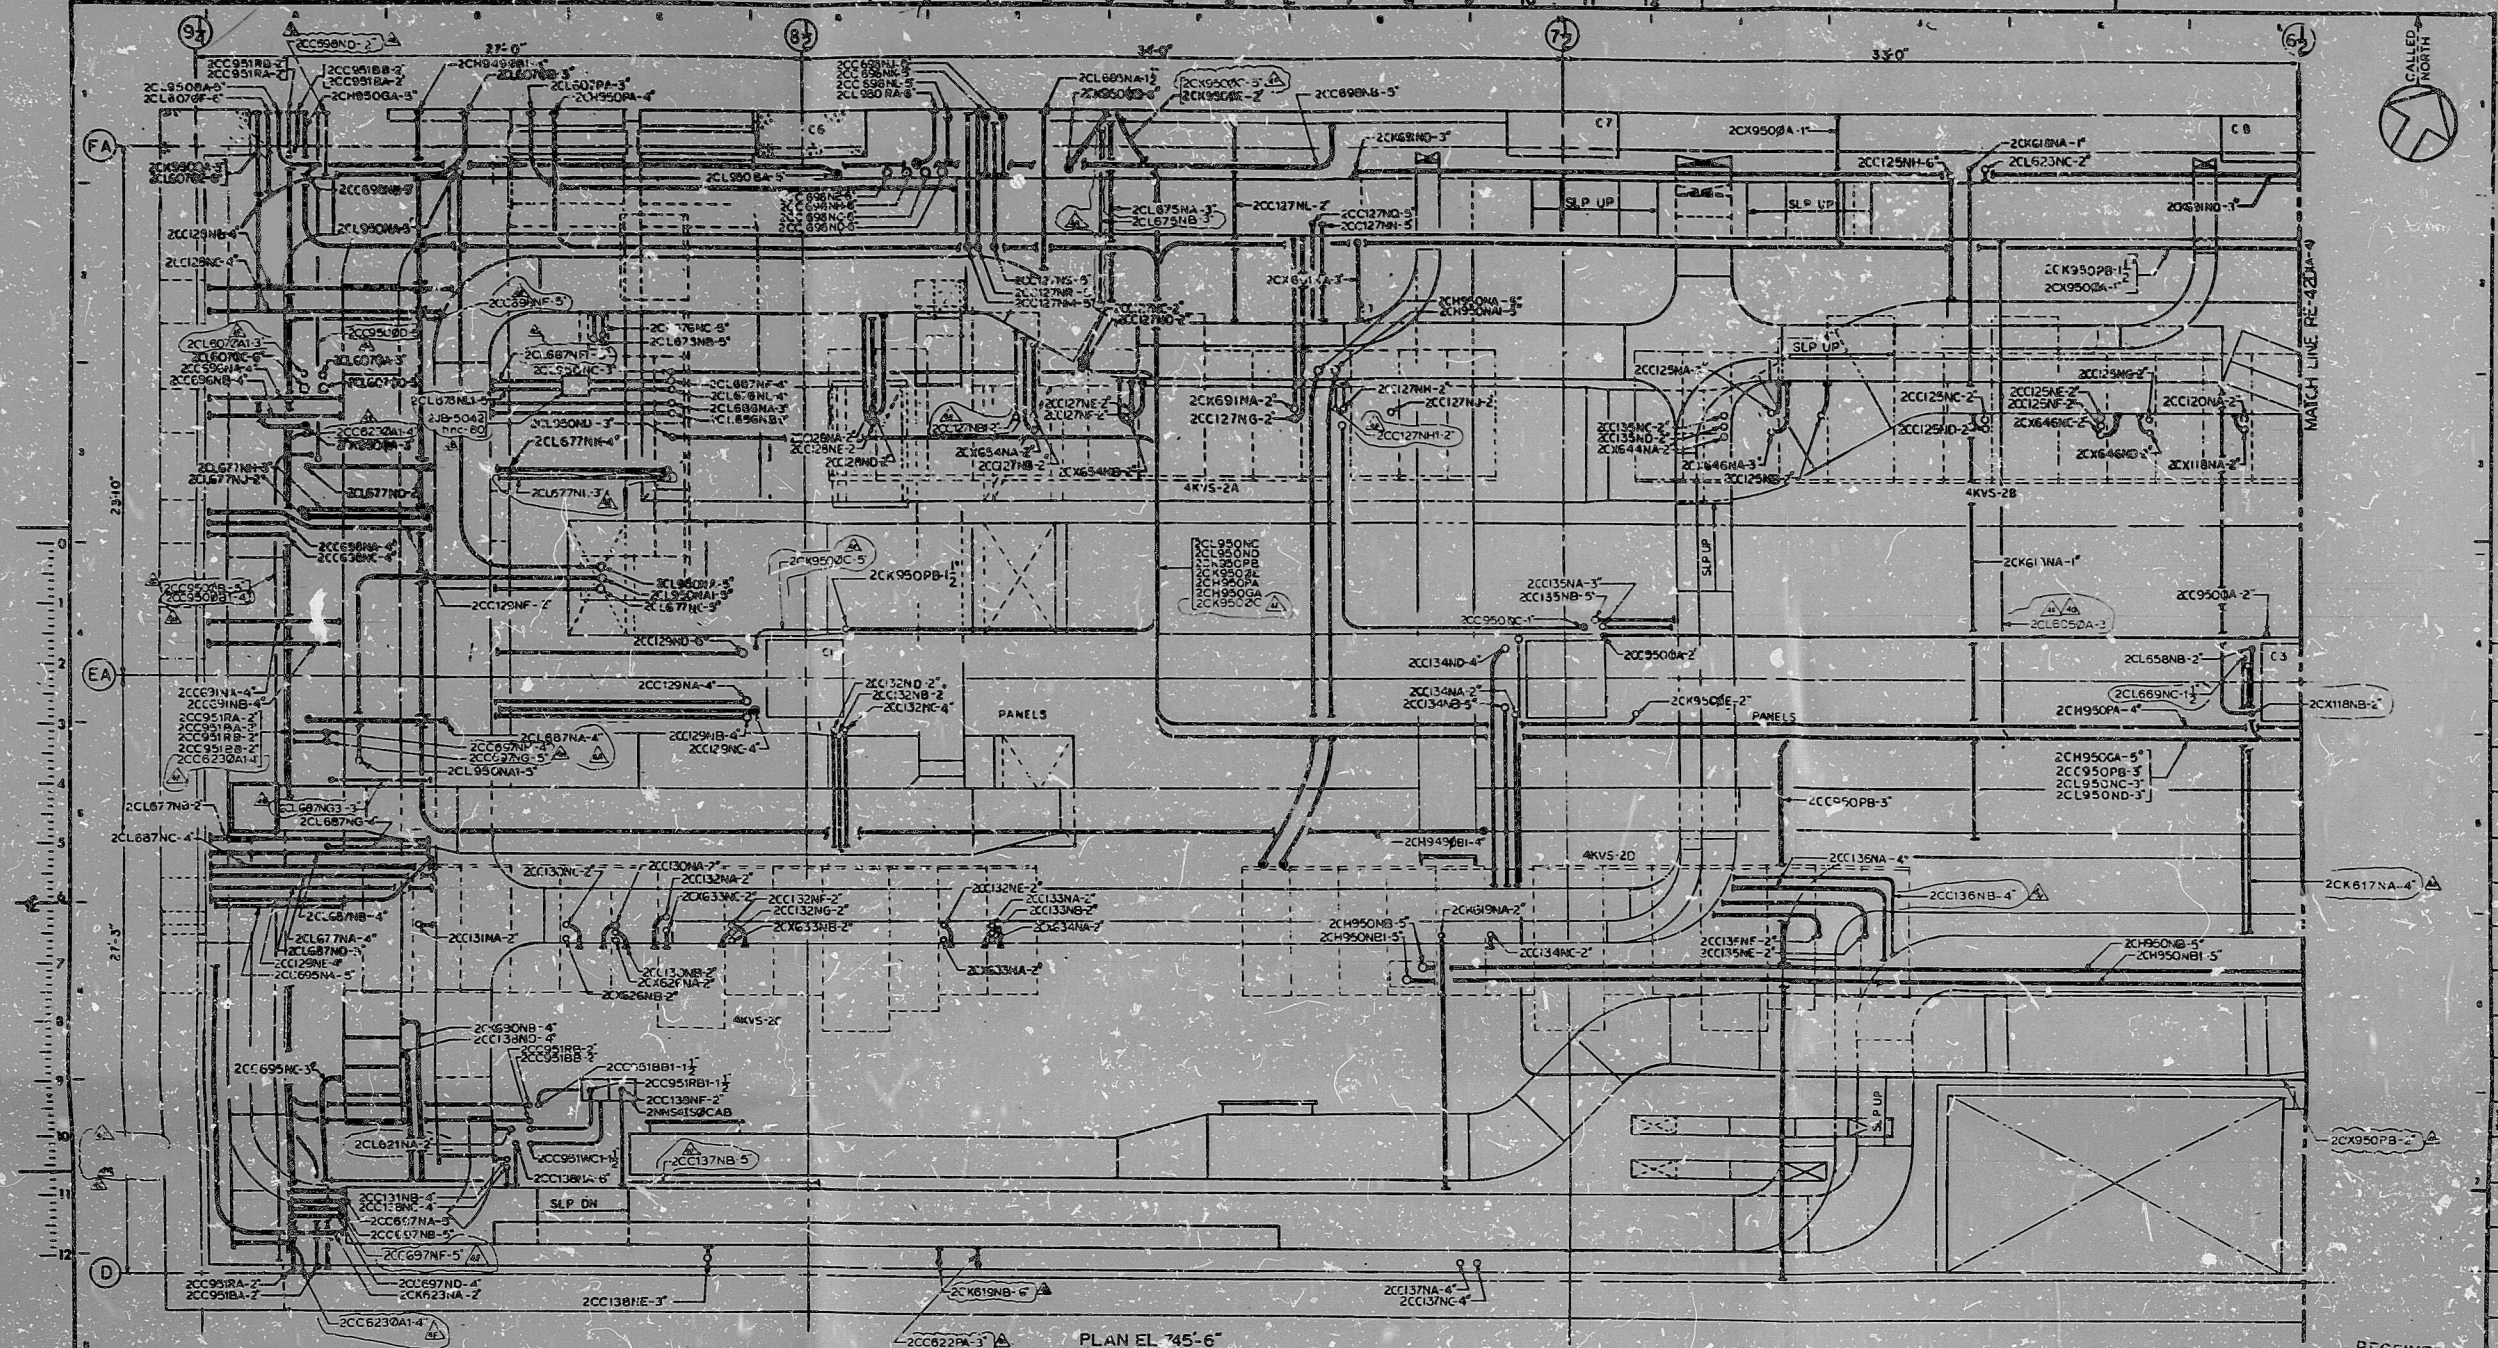

PLAN EL. 745'-6"

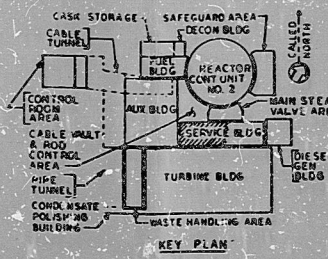

Control Level

- NOTES:
1. GENERAL NOTES AND REFERENCE DRAWINGS, RE-42A, RE-42B, RE-42C.
 2. CABLE TRAY AREA.
 3. CABLE TRAY SUPPORT LOCATIONS-SVCE BLDG. RE-3400A, RE-3400B, RE-3400C.
 4. VENTILATION SVCE BLDG.

PORTIONS OF THIS DOCUMENT ARE NUCLEAR SAFETY RELATED



TI APERTURE CARD

4-25-63 FOR BILL OF MATERIAL NO. 10080-RE-42C


8409210255

PDR RIDS

8409210255

