


No. 10080-RE-42D

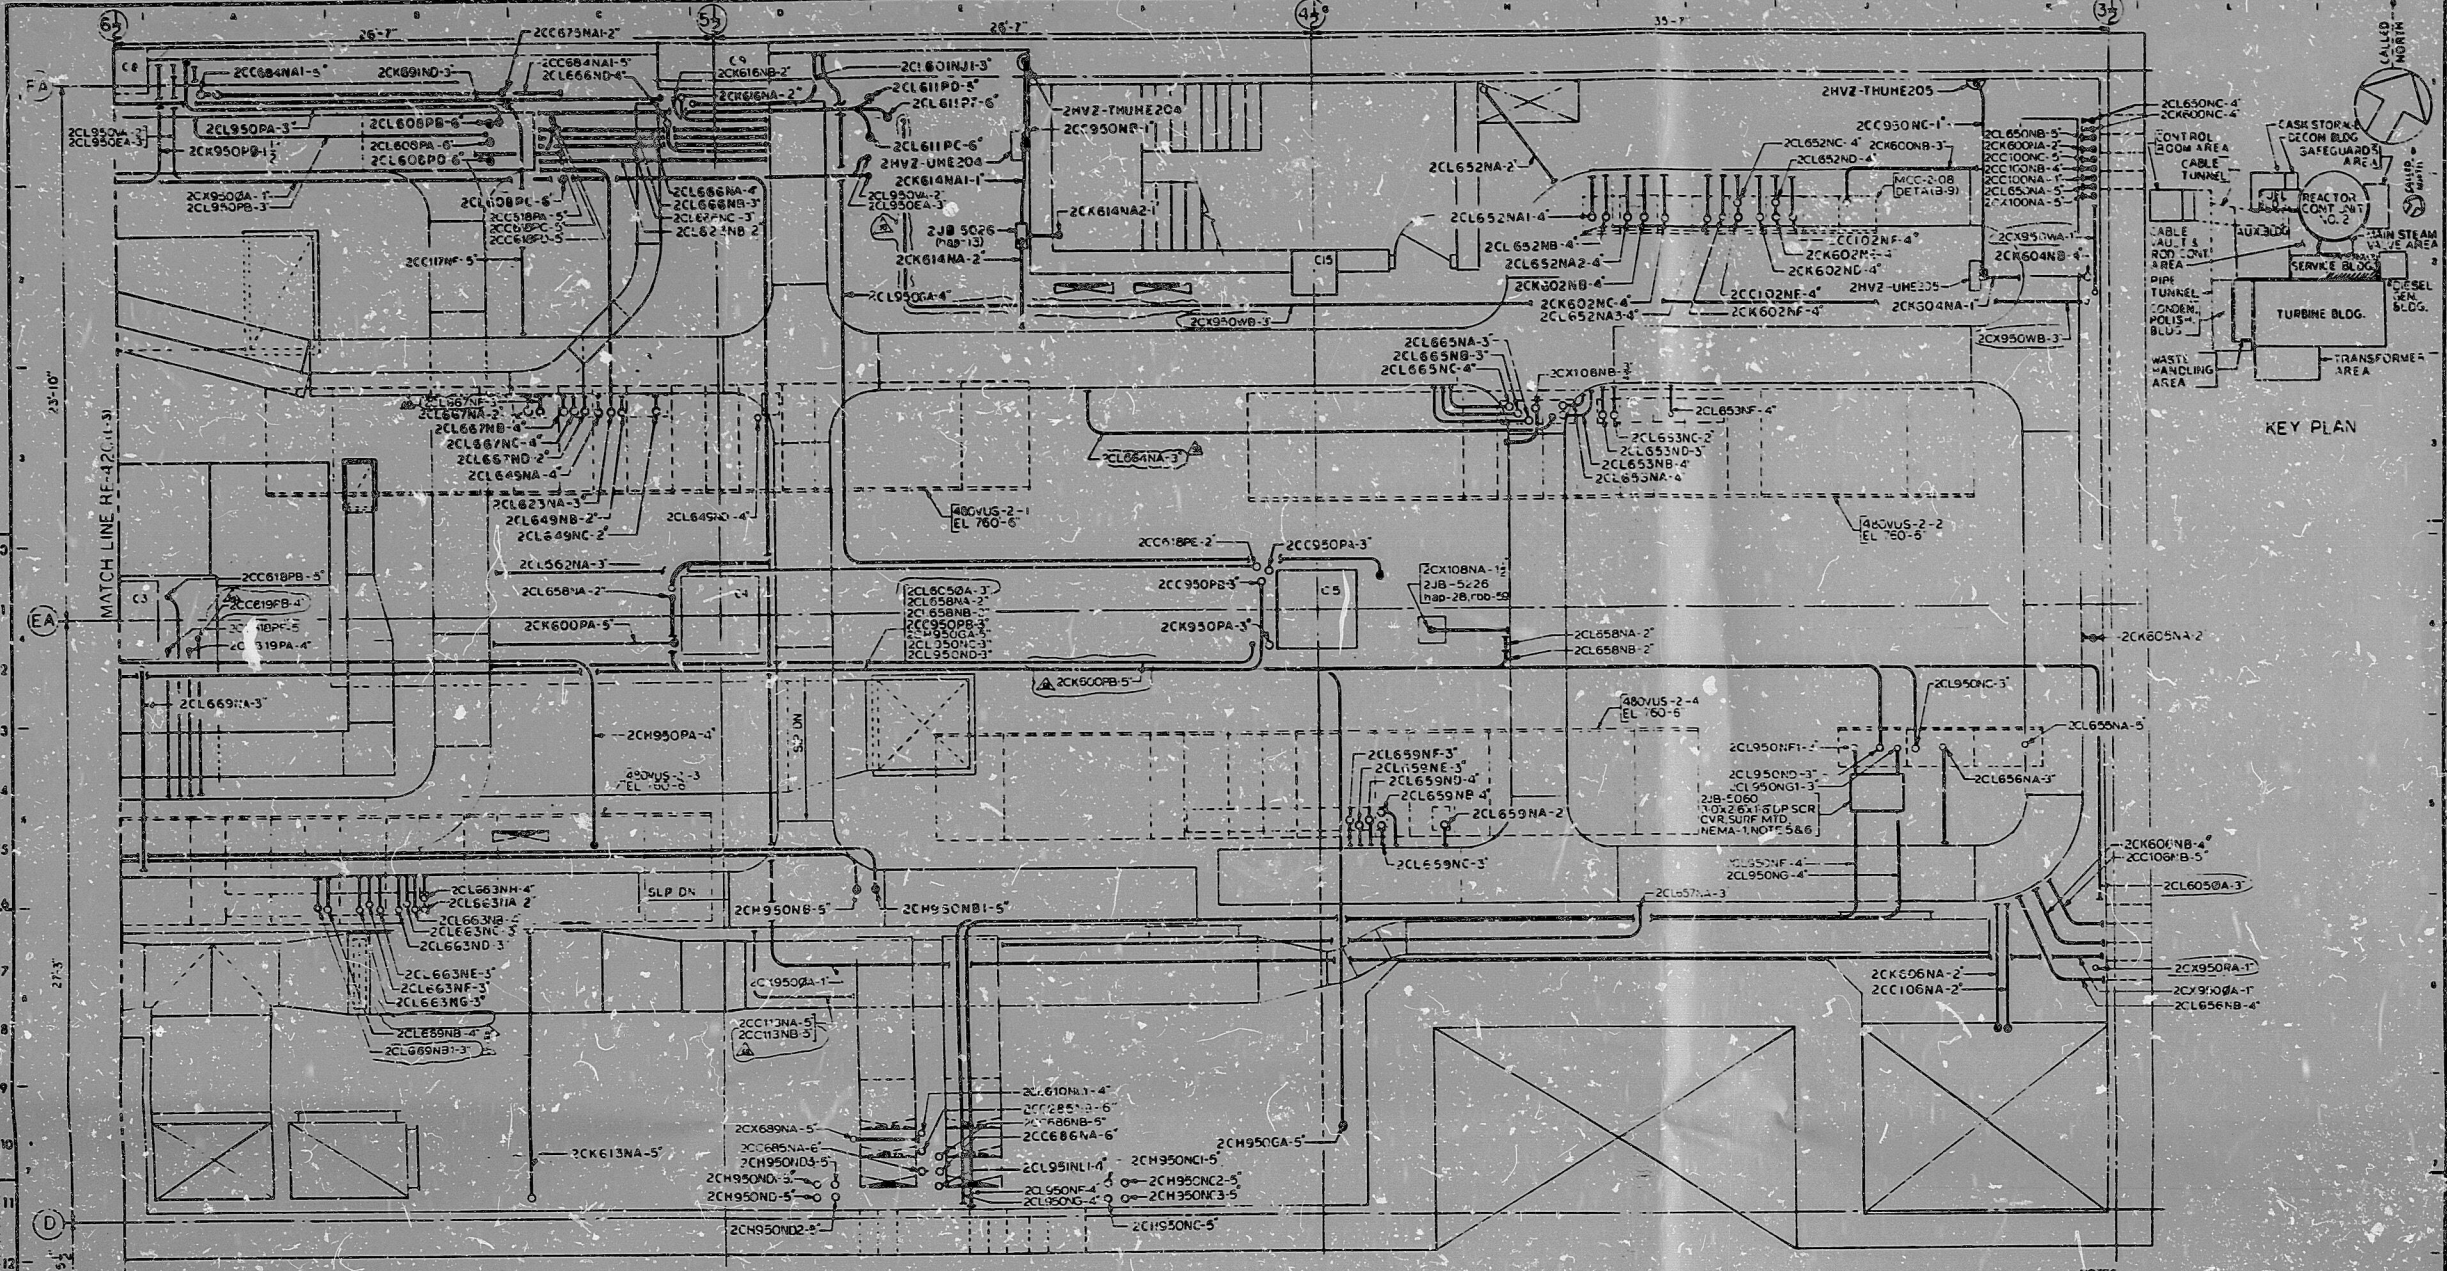

PLAN EL 745'-6'

NOTES:
 5. 15' MIN. WARNING SIGN ON OUTSIDE OF BOX.
 6. DANGER LINE EXPOSED BUS.
 7. FIELD TO INSTALL REMOVABLE MICARDIA BARRIER.
 MIN. 2" THK IN JAS BELOW COVER.

NOTES:
 1. GENERAL NOTES & REFERENCE DWGS. RE-42A.
 2. CABLE TRAY ARRANGEMENT - SVCE BLDG. RE-34X.
 3. CABLE TRAY SUPPORT LOCATIONS - SVCE BLDG. RE-34DM.
 4. VENTILATION - SVCE BLDG. RE-35B.

01	02	03	08	09	10	13	14	17	18	19	21	22	23	26
03	04	07	08	10	11	12	13	16	19	20	23	24	27	28

MCC-2-08
 RETAIL - A
 (3-2)
 SLEEVE DETAIL RE-38A(IG-1)

TABLE FOR MCC-2-08

LOC	IDENT	LOC	IDENT
01	2FL660N01	15	2FL660N15
02	2FL660N02	16	2FL660N16
03	2FL660N03	17	2FL660N17
04	2FL660N04	18	2FL660N18
05	2FL660N05	19	2FL660N19
06	2FL660N06	20	2FL660N20
07	2FL660N07	21	2FL660N21
08	2FL660N08	22	2FL660N22
09	2FL660N09	23	2FL660N23
10	2FL660N10	24	2FL660N24
11	2FL660N11	25	2FL660N25
12	2FL660N12	26	2FL660N26
13	2FL660N13	27	2FL660N27
14	2FL660N14	28	2FL660N28

Conduit Level 1

PORTIONS OF THIS DOCUMENT ARE NUCLEAR SAFETY RELATED

THE INFORMATION ON THIS DRAWING MAY NOT BE COPIED OR USED FOR OTHER THAN THE CONSTRUCTION MAINTENANCE OR REPAIR OF THE PLANT FACILITY INDICATED BY THE TITLE BLOCK.



APPROVED: [Signature] REGISTERED PROFESSIONAL ENGINEER No. 776, W.V. STATE OF WEST VIRGINIA

TI APERTURE CARD

FOR BILL OF MATERIAL NO 10060-84-420

1. APPROVED FOR CONSTRUCTION DATE 5-15-73 BRADLEY HARVEY ELECT. APP. SUPERVISOR	2. APPROVED FOR CONSTRUCTION DATE 5-15-73 STONE & WEBSTER ENGINEERING CORP. BOSTON, MASS.	3. APPROVED FOR CONSTRUCTION DATE 5-15-73 ARCH. APP. SUPERVISOR	4. APPROVED FOR CONSTRUCTION DATE 5-15-73 ELECTR. APP. SUPERVISOR
--	--	--	--

DUQUESNE LIGHT COMPANY
 ENGINEERING & CONSTRUCTION PITTSBURGH, PA.

CONDUIT PLAN - SERVICE BUILDING
 CABLE TRAY AREA SH 2 EL 745'-6'

BEAVER VALLEY POWER STATION UNIT NO. 2

DATE: 5-15-73
 C.O. NO. 10080-RE-42D

S&W DWG. NO. 12241-RE-42D-5D

8409210257

PDR RIDS

8409210257

