


No. 10080-RE-37V

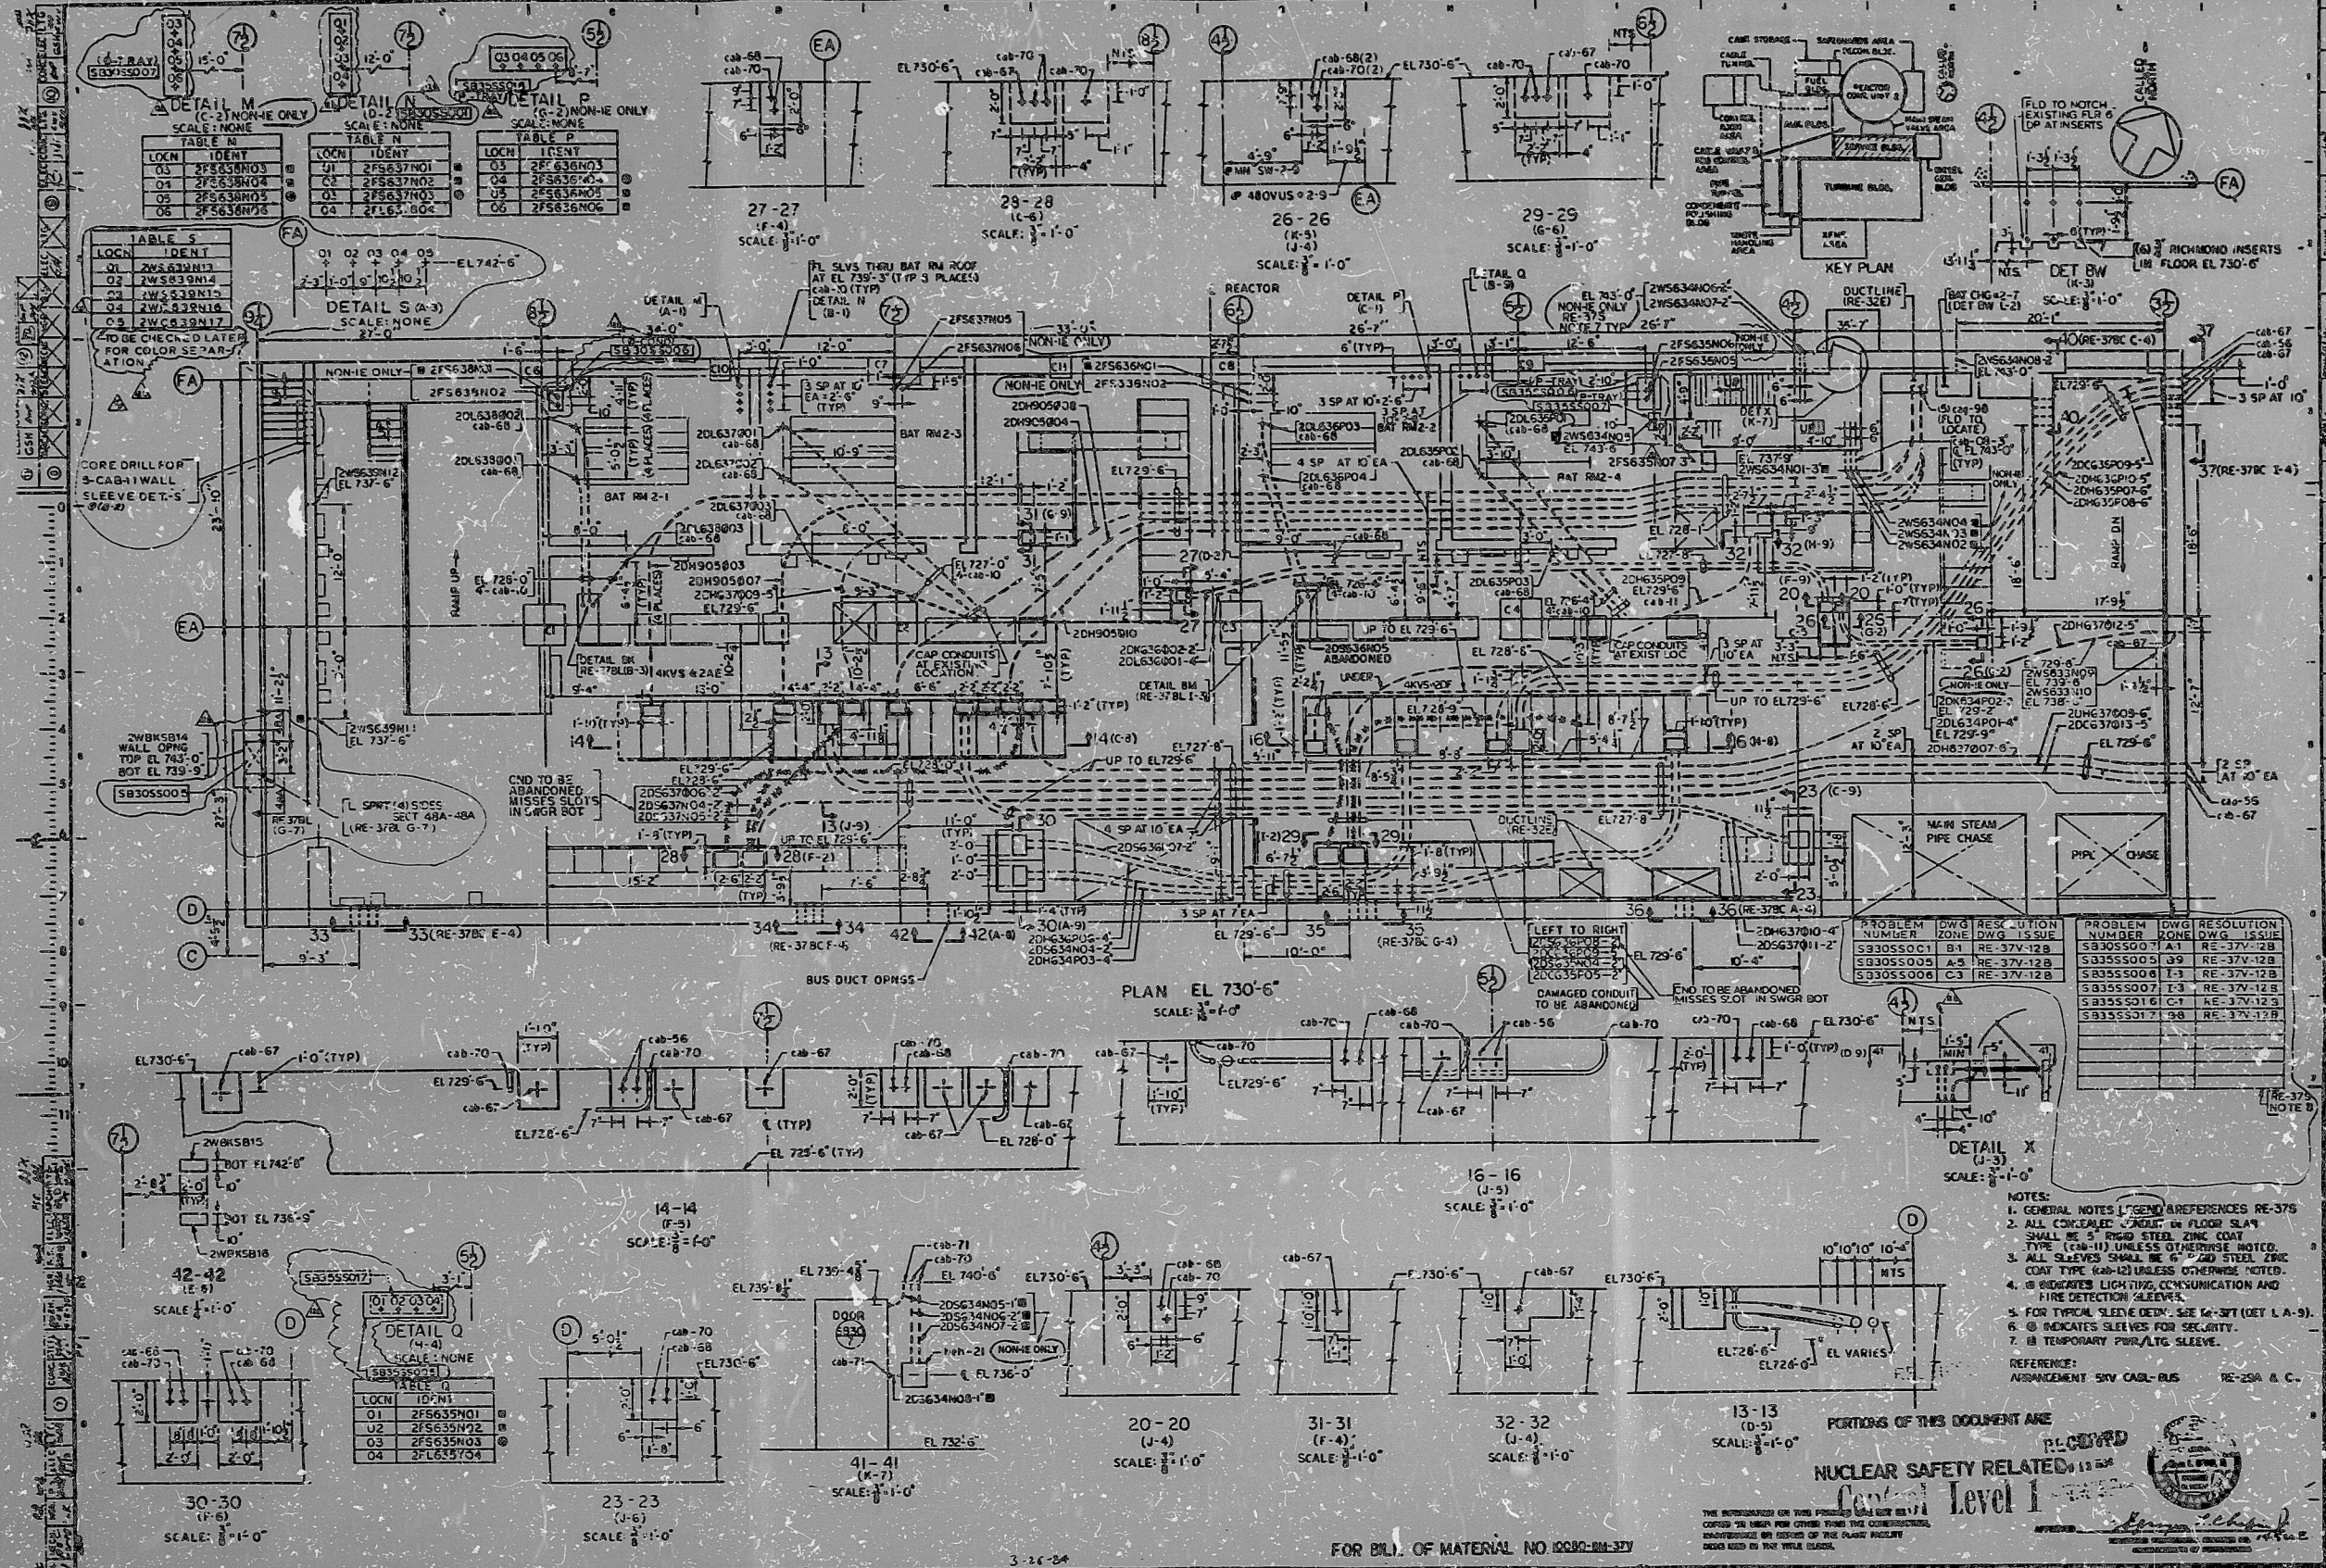

DETAIL M (C-2) NON-HE ONLY SCALE: NONE

LOCN	IDENT	LOCN	IDENT
01	2F5638N03	01	2F5637N01
02	2F5638N04	02	2F5637N02
03	2F5638N05	03	2F5637N03
04	2F5638N06	04	2F5637N04









PROBLEM NUMBER	DWG	RESOLUTION

- NOTES:
- GENERAL NOTES REFERENCED RE-37S
 - ALL CONCEALED CONDUIT ON FLOOR SLAB SHALL BE 3" RIGID STEEL ZINC COAT TYPE (C-11) UNLESS OTHERWISE NOTED.
 - ALL SLEEVES SHALL BE 6" COB STEEL ZINC COAT TYPE (C-12) UNLESS OTHERWISE NOTED.
 - INDICATES LIGHT TYPE, COMMUNICATION AND FIRE DETECTION SLEEVES.
 - FOR TYPICAL SLEEVE DETN. SEE RE-37T (DET. L.A.-3).
 - INDICATES SLEEVES FOR SECURITY.
 - TEMPORARY PIPING SLEEVE.
- REFERENCE: ARRANGEMENT SHV CAB-RUS RE-25A & C.

PORTIONS OF THIS DOCUMENT ARE PLACED
NUCLEAR SAFETY RELATED
 Level 1

FOR BILL OF MATERIAL NO. 10080-RE-37V

<p>DUQUESNE LIGHT COMPANY ENGINEERING & CONSTRUCTION PITTSBURGH, PA. DATE: 7-2-73 DRAWN BY: [Signature] CHECKED BY: [Signature] APPROVED BY: [Signature]</p>	<p>CONCEALED CONDUIT & SLEEVES SERVICE BUILDING-SH4 BEAVER VALLEY POWER STATION UNIT NO. 2 SHEET NO. AA No. 10080-RE-37V S&W DWG. NO. 10241-RE-37V-12B</p>
---	--

8409210288

PDR RIDS

8409210288

