


(01) OF 520-14

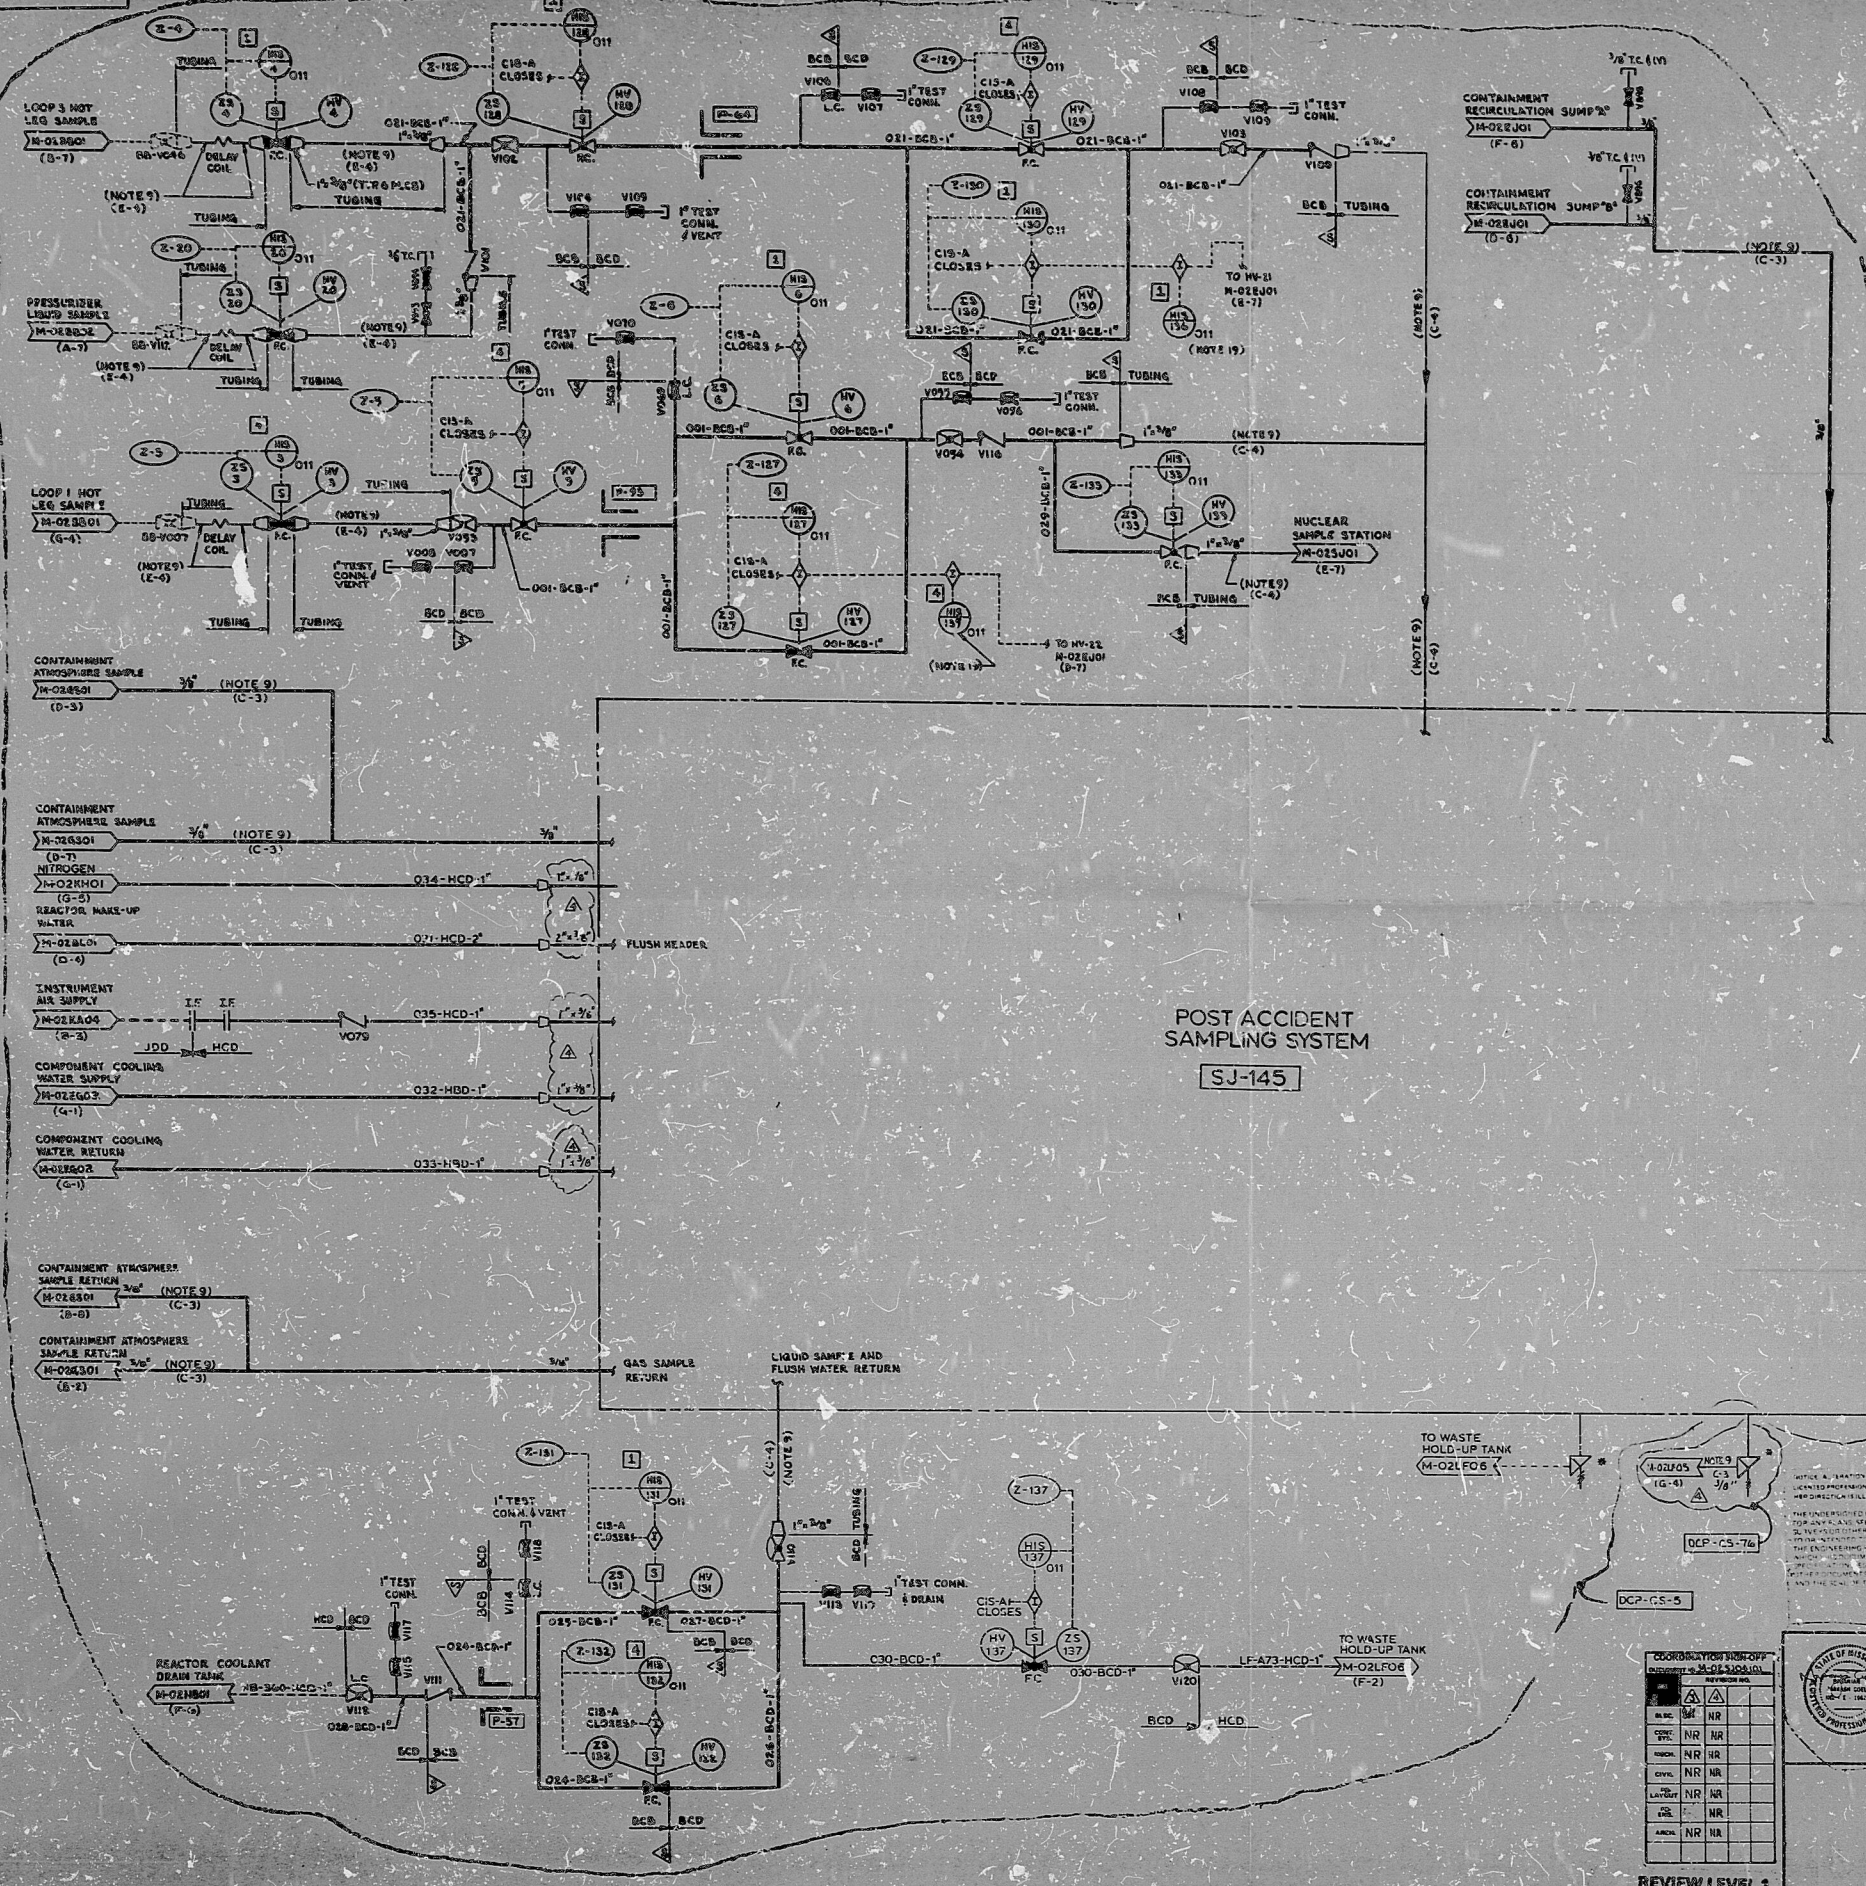

NOTES:
1. SEE DRAWING M-025J04 FOR NOTES.

TH
ATURE
CARD

NO.	DATE	REVISIONS
1		
2		
3		
4		
5		
6		
7		
8		
9		
10		

NO.	DATE	REVISIONS
1		
2		
3		
4		
5		
6		
7		
8		
9		
10		

BECHTEL	
SNUPPS	
PIPING AND INSTRUMENTATION DIAGRAM	
NUCLEAR SAMPLING SYSTEM	
10466	M-025J04(Q) 4

PDR RDS

DEL 8409270344

