


This drawing and the design it contains are the property of the utilities which are participating in the SNUPPS Project. It is loaned to the borrower's office for their use only and shall not be reproduced, copied, loaned, exhibited, or used except in the limited way and under the permission of the utilities which are participating in the SNUPPS Project.

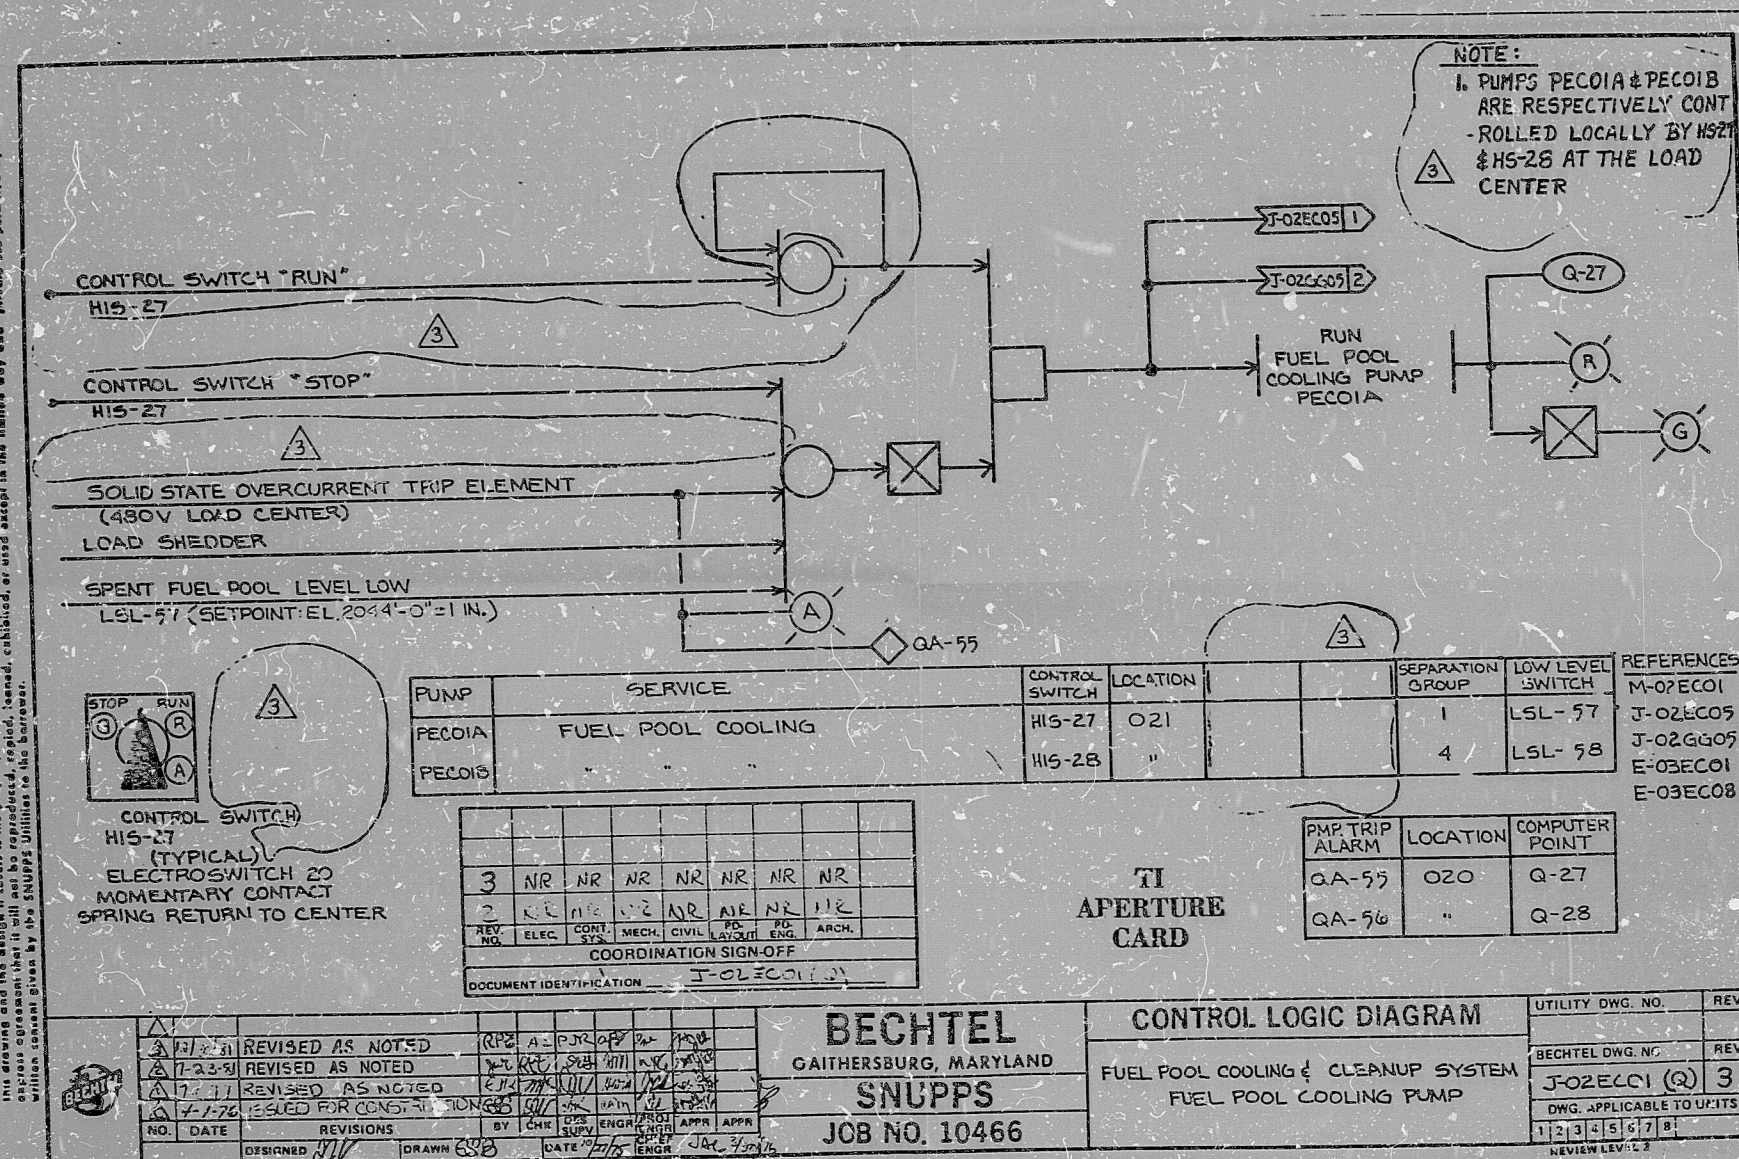

I certify that the image contained on this frame was made in the normal and regular course of business, on the date stated below and that it is an accurate reproduction of the document(s) submitted to Micrographics.
DATE 1-13-83 OPERATOR J. E. Seng SUPERVISOR J. E. Seng

16X

PDR RIDS

8409270518

