


This drawing and the design it covers is the property of the Utility which is participating in the SNUPPS Project. It is loaned to the borrower's use only and is not to be reproduced, stored in a retrieval system, or used in any way without the express written permission of the Utility.

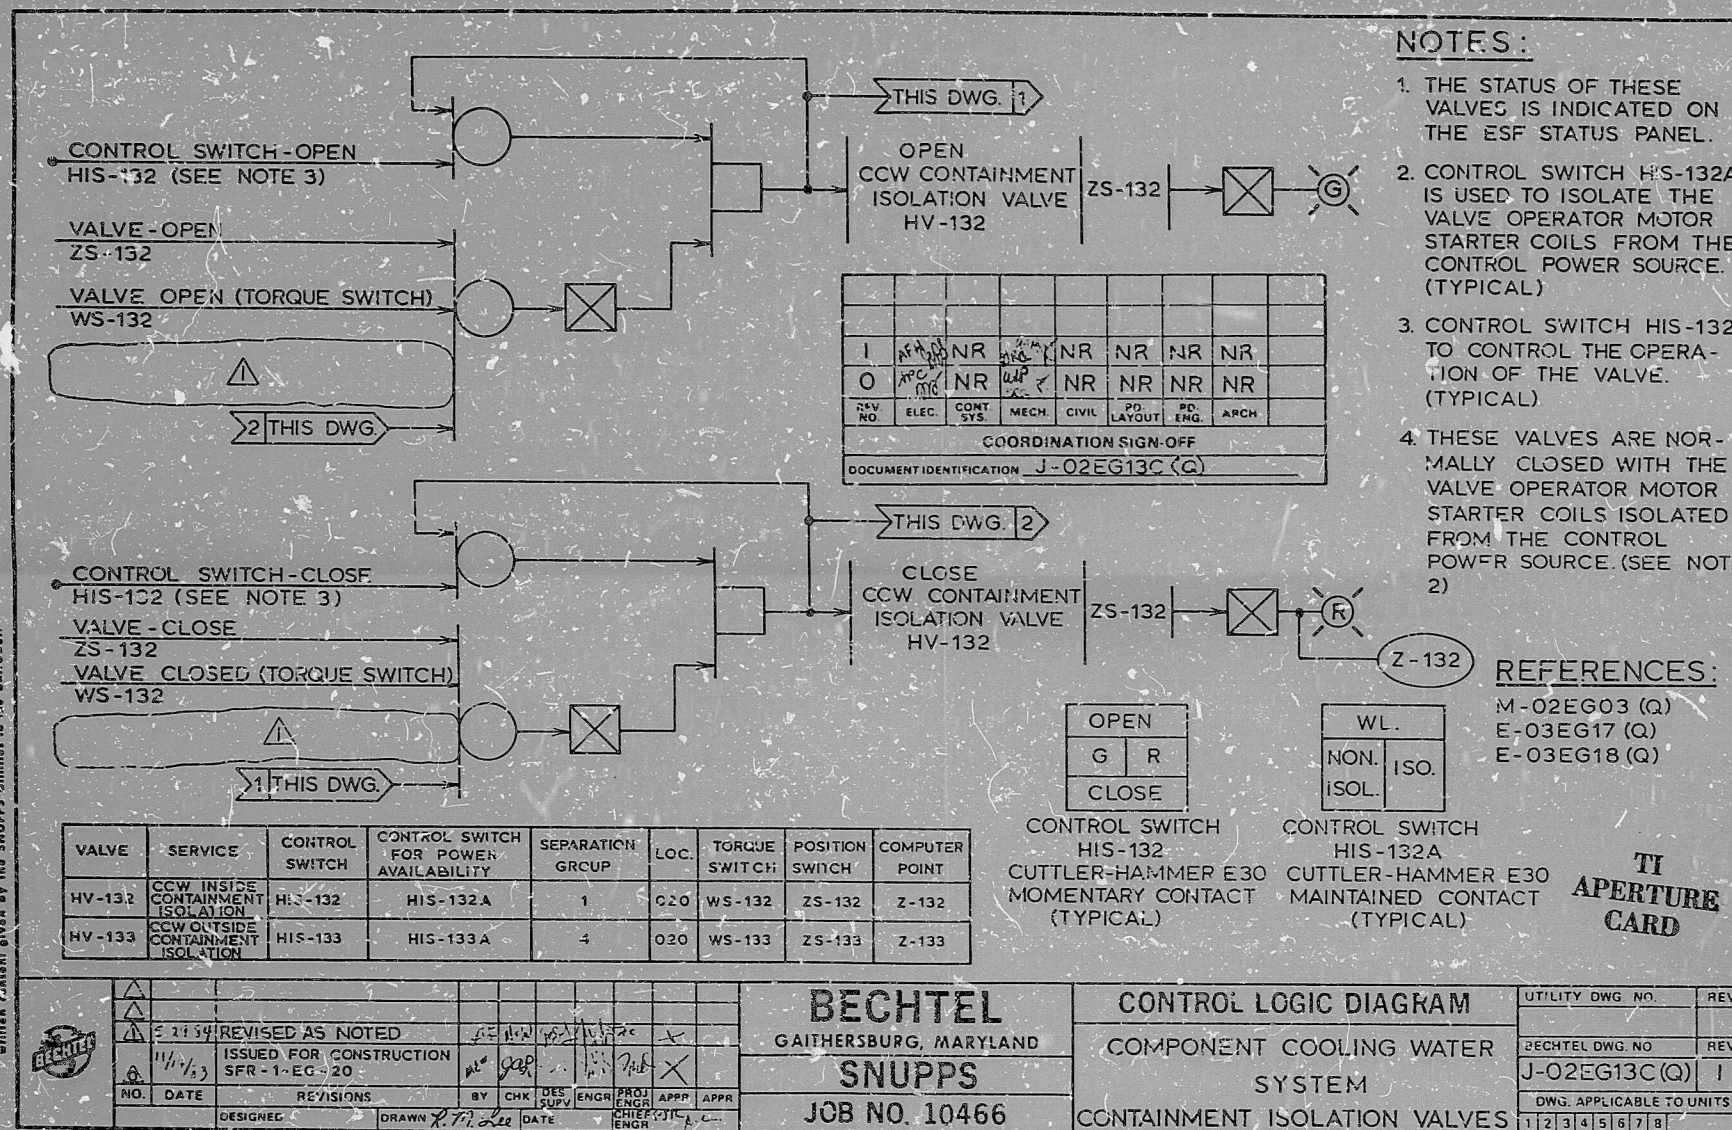

I certify that the image contained on this frame was made in the normal and regular course of business, on the date stated below and that it is an accurate reproduction of the document(s) submitted to micrographics.
DATE 6-14-84 OPERATOR [Signature]

16X

8409270636

PDR RIDS

