


This drawing and the design it covers is the property of the utilities which are participating in the SNUPPS Project. It is loaned to the borrower's company for use only and is not to be reproduced, copied, loaned, exhibited, or used except in the limited way and private use permitted by written consent given by the SNUPPS Utilities to the borrower.

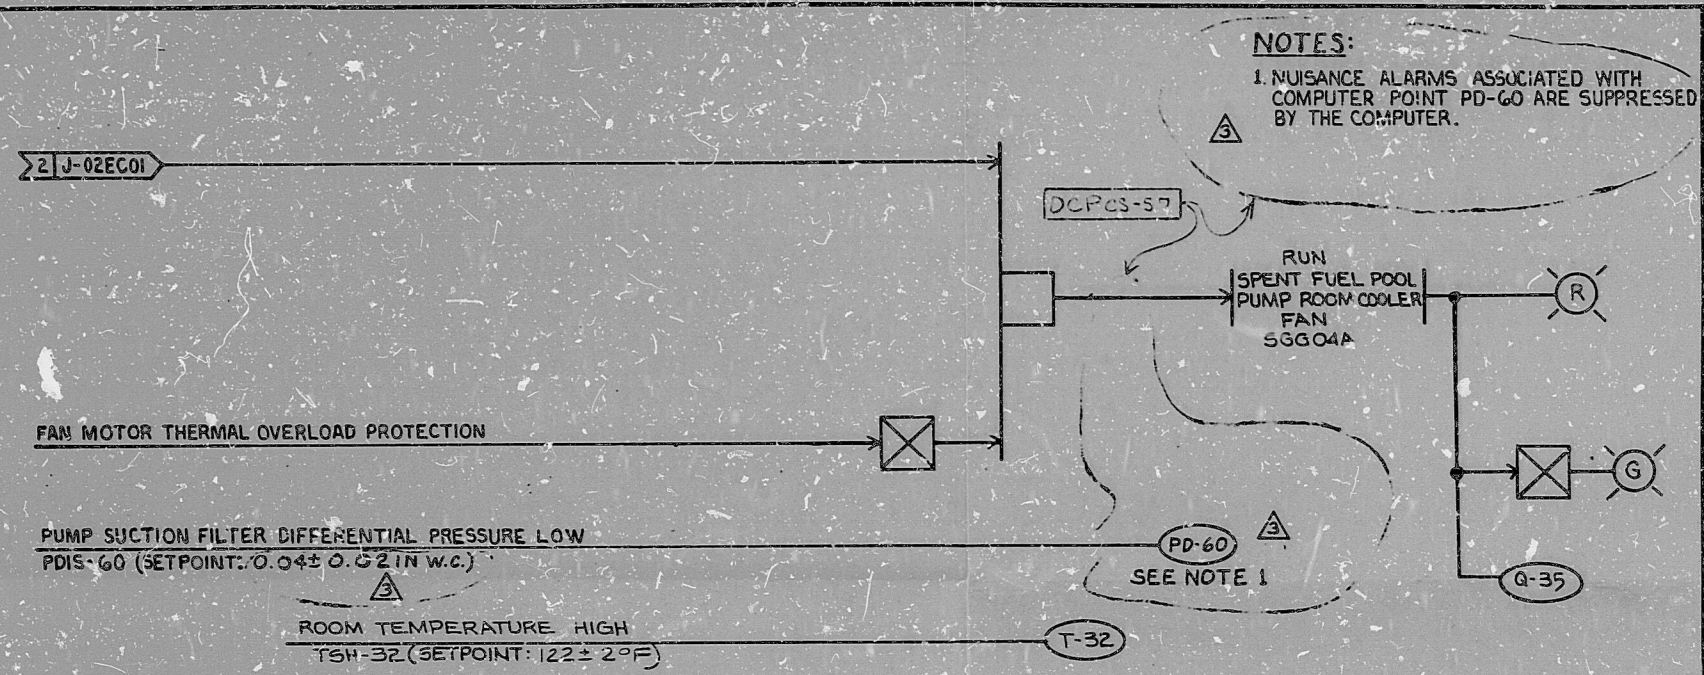

FAN	SERVICE	COMPUTER POINT	PRESSURE SWITCH	COMPUTER POINT	TEMP SWITCH	COMPUTER POINT	SEPARATION GROUP
SGG04A	SPENT FUEL POOL PUMP ROOM COOLER	Q-35	FDIS-60	PD-60	TSH-32	T-32	1
SGG04B	" " " " " " " "	Q-34	PDIS-61	PD-61	TSH-33	T-33	4

REV. NO.	ELEC.	CONT. S/S	MECH.	CIVIL	PD LAYOUT	PD ENCL.	ARCH.
1							
2							
3							
4							
5							
6							
7							
8							
9							
10							

NO.	DATE	DESIGNED	DRAWN	DATE	BY	CHK	APP	ENGR	ENCL	SPR	APPR
1	4-1-73	SFR-2-GG-011A, SFR-2-GG-015A	JA	5-21-73	REVIS	AS	NOTED				
2	7-1-73	REVIS	AS	NOTED							
3	8-3-73	REVIS	FOR	CONSTRUCTION							

**BECHTEL**  
GAITHERSBURG, MARYLAND  
**SNUPPS**  
JOB NO. 10466

**CONTROL LOGIC DIAGRAM**  
FUEL BUILDING HVAC  
SPENT FUEL POOL ROOM COOLERS

UTILITY DWG. NO.	REV.
M-02GG02 (Q)	
E-03GG02 (Q)	
J-02EC01 (Q)	
E-03GG12 (Q)	
BECHTEL DWG. NO.	REV.
J-02GG05 (Q)	3
DWG. APPLICABLE TO UNITS	
1 2 3 4 5 6 7 8	
REVIEW LEVEL 3	

I certify that the image contained on this frame was made in the normal and regular course of business, on the date stated below and that it is an accurate reproduction of the document(s) submitted to Micrographics.  
DATE 4-6-83 OPERATOR *Paul Hanger* SUPERVISOR *R. Conner*

16X

TI  
APERTURE  
CARD



8409270764

PDR RIDS

