



M-02DA02


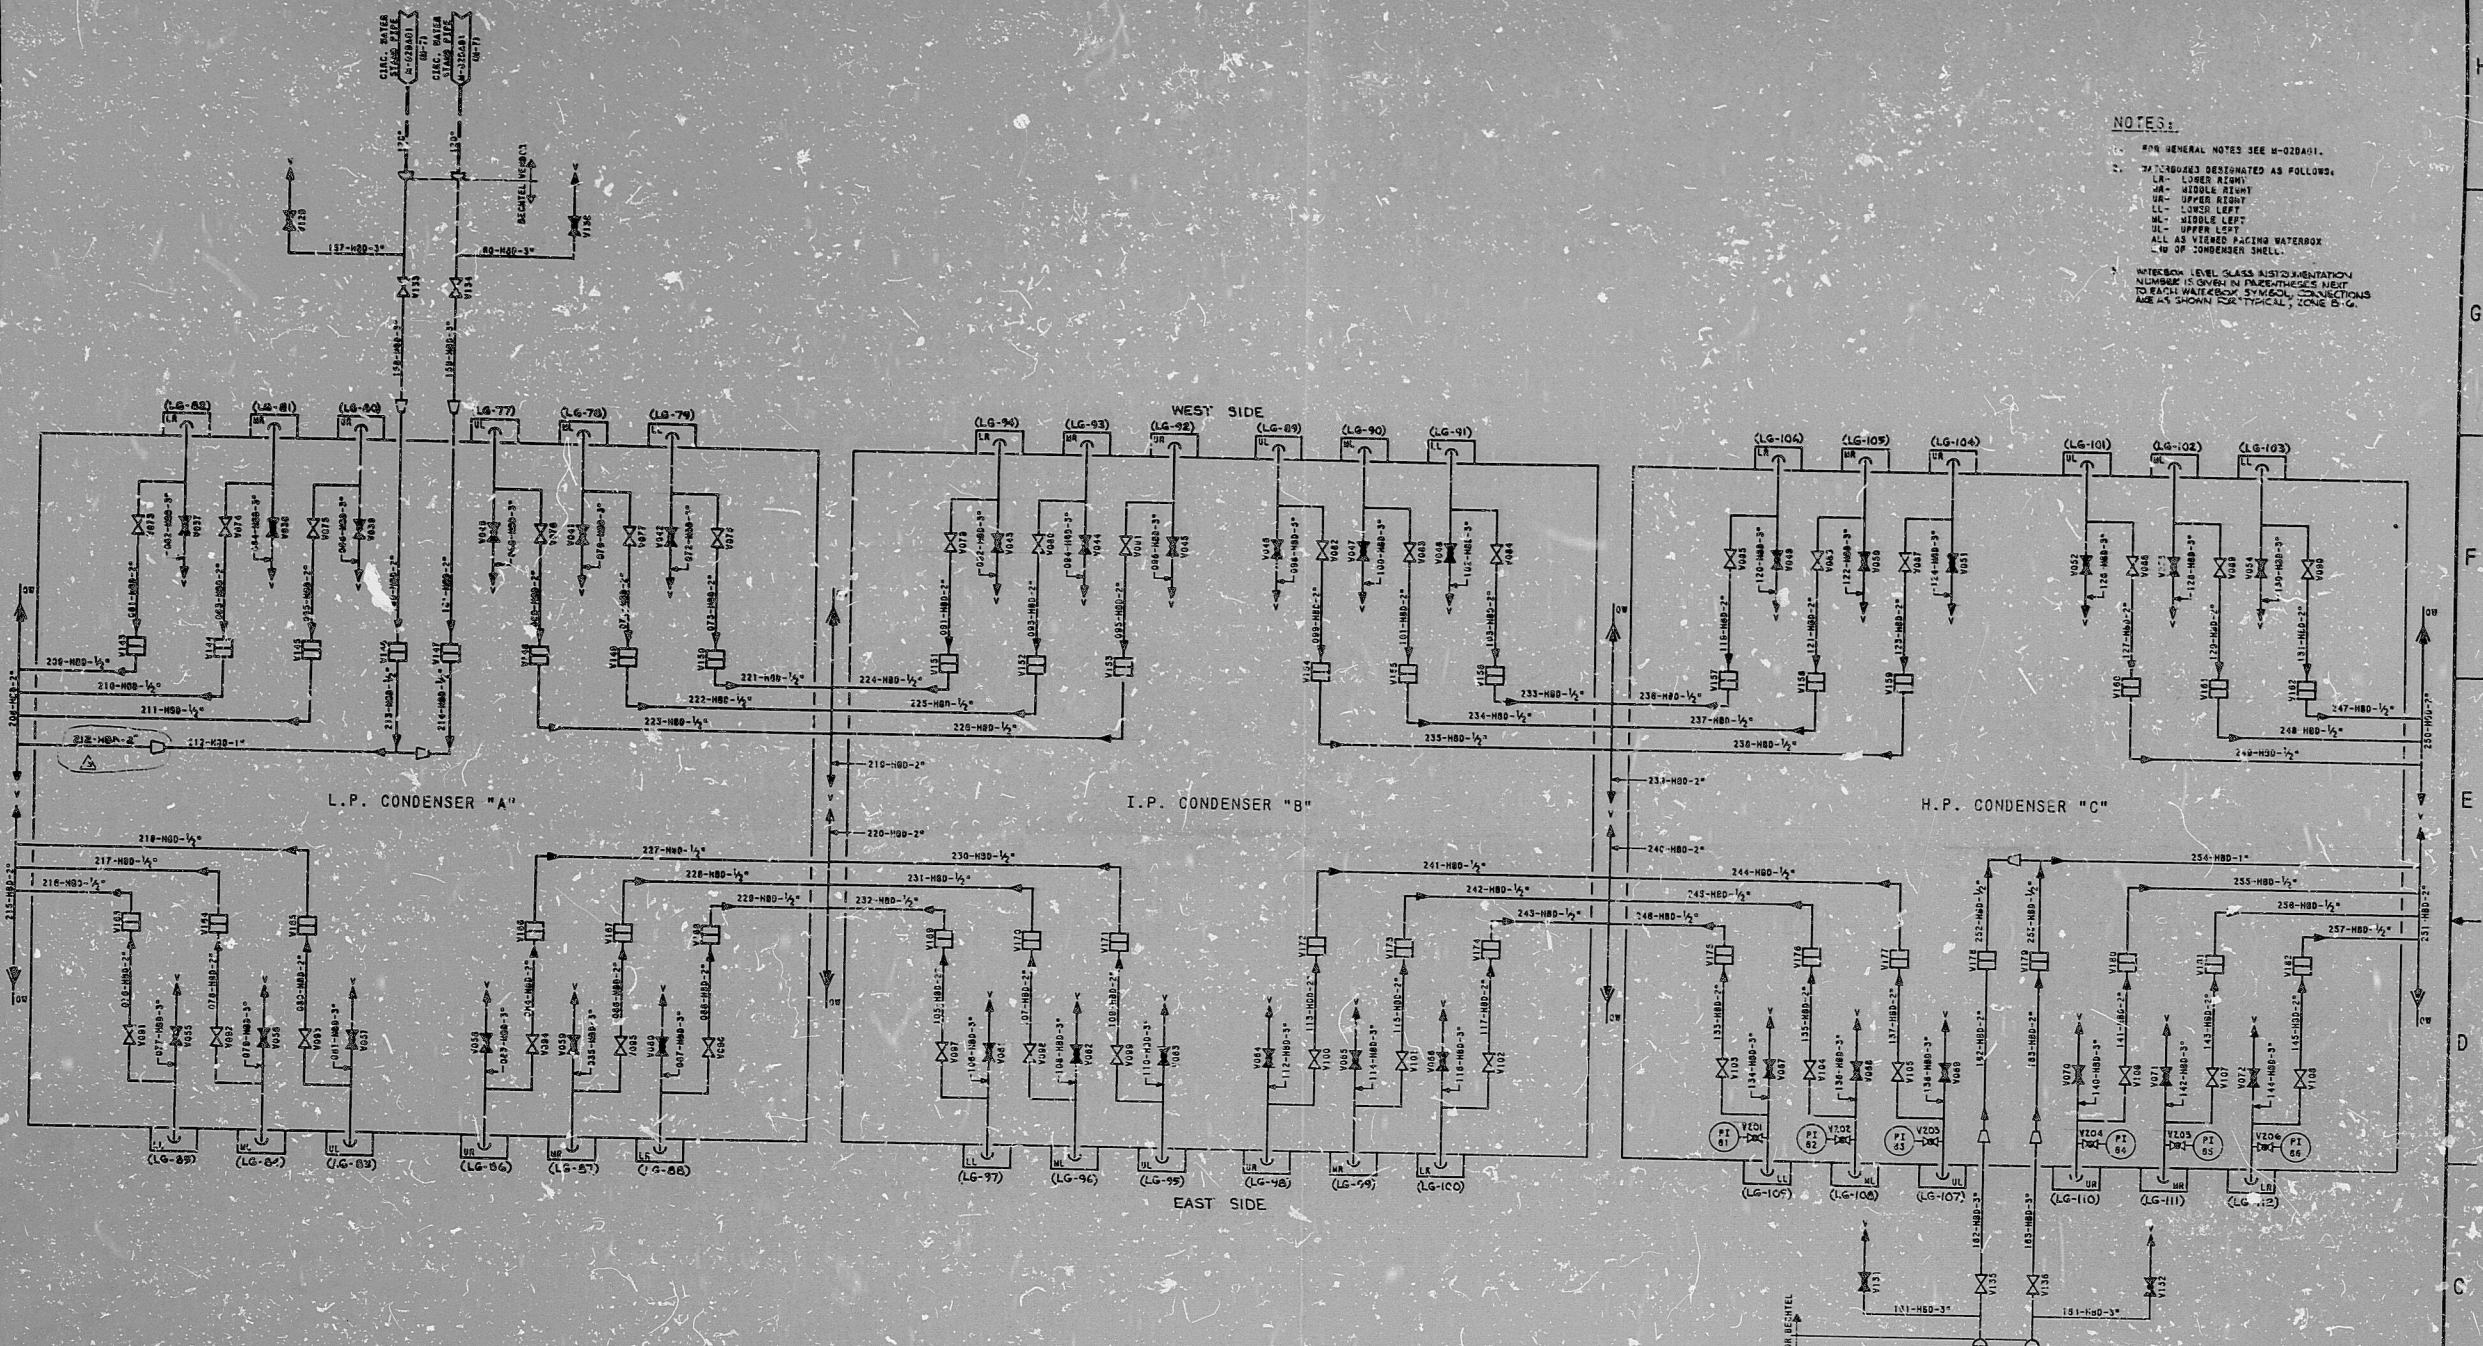

NOTES:
1. GENERAL NOTES SEE M-02DA01.
2. VALVES DESIGNATED AS FOLLOWS:
LR - LOWER RIGHT
UR - UPPER RIGHT
LL - LOWER LEFT
UL - UPPER LEFT
ALL AS VIEWED FACING WATERBOX
END OF CONDENSER SHELL.
3. WATERBOX LEVEL GLASS INSTRUMENTATION
NUMBER IS SHOWN IN PARENTHESIS NEXT
TO EACH WATERBOX SYMBOL. CONNECTIONS
ARE AS SHOWN FOR TYPICAL CASES.

CONDENSER	WATERBOX DESIGNATOR	VALVE NO.	LEVEL INSTRUMENT NO. (LG)	WATERBOX DESIGNATOR	VALVE NO.	LEVEL INSTRUMENT NO. (LG)

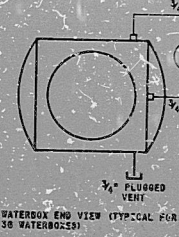


WATERBOX END VIEW (TYPICAL FOR
30 WATERBOXES)


TI
APERTURE
CARD

DECHTEL WATERBOX END VIEW					
SNUPPS					
PIPING AND INSTRUMENTATION DIAGRAM CIRCULATING WATER WATERBOX VENTING SYSTEM					
WATERBOX END VIEW NO.					
JOB NO.					
PROJECT NO.					
DRAWING NO.					
REVISIONS					
REVISION NO.					
DATE					
BY					
CHKD					

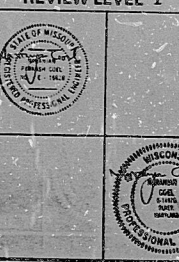



PDR RIDS

8409280194

