


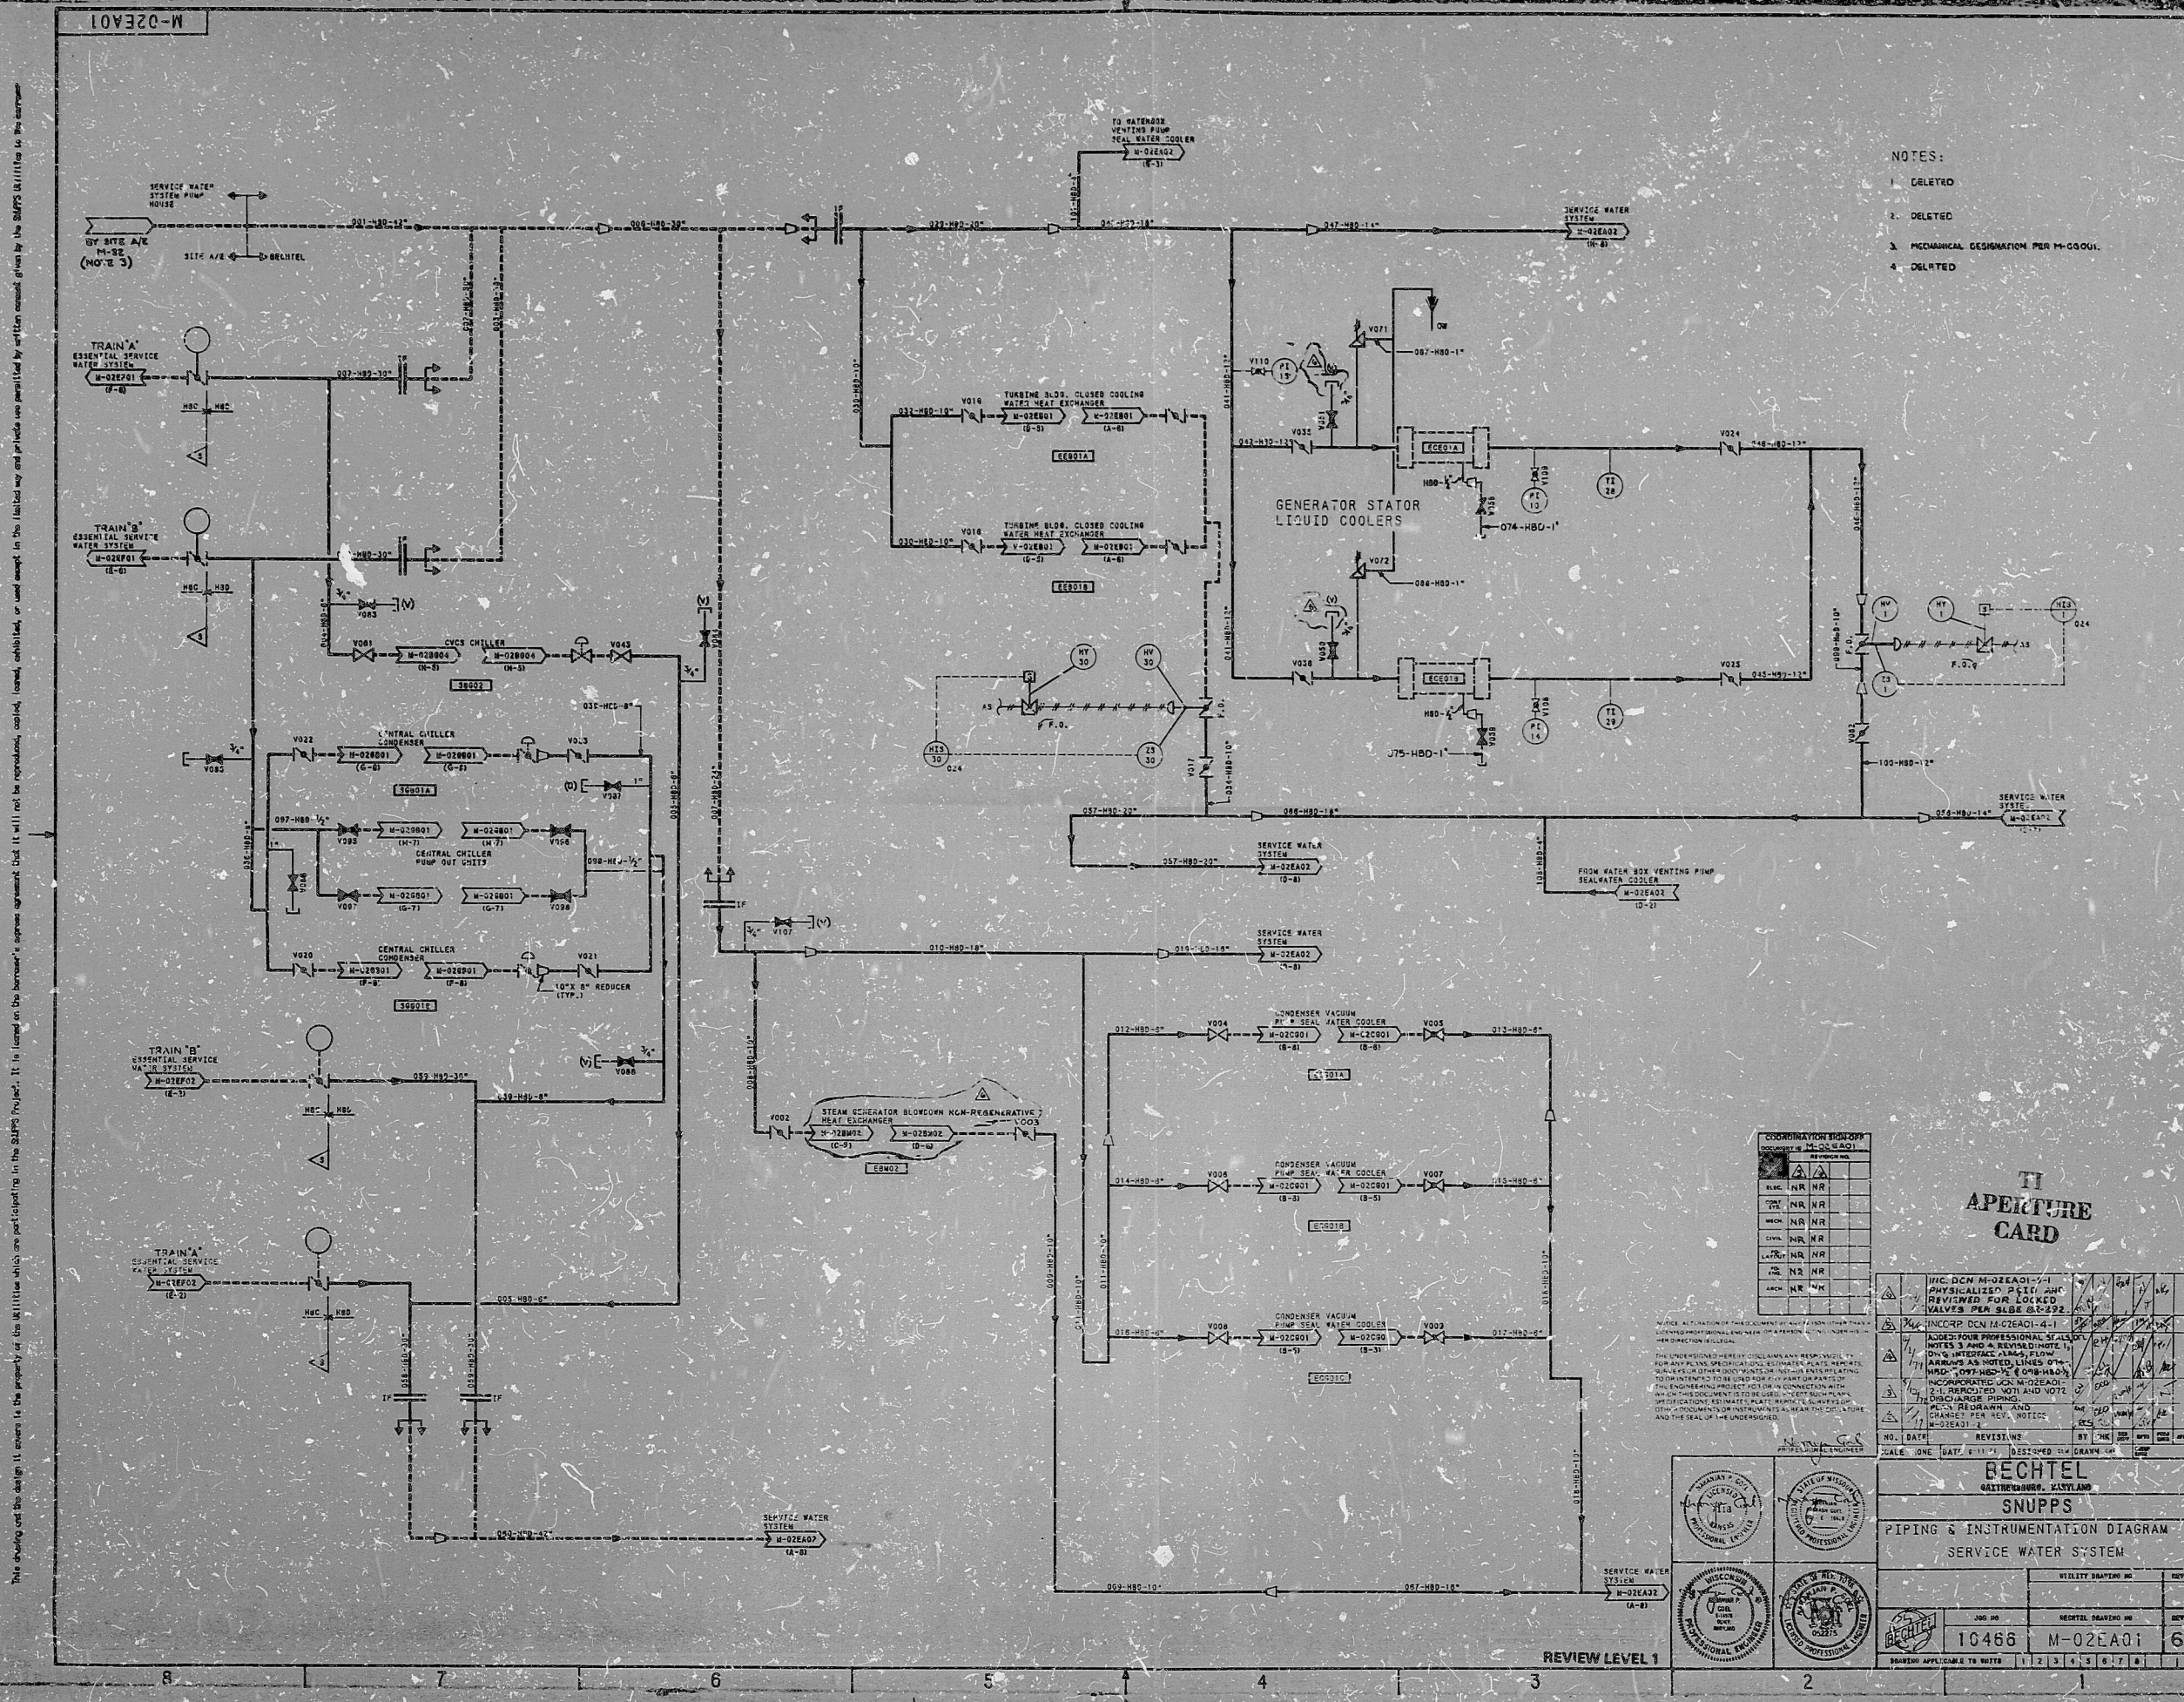


- NOTES:
- 1. DELETED
 - 2. DELETED
 - 3. MECHANICAL DESIGNATION PER M-0001
 - 4. DELETED

COORDINATION SIGN-OFF	REVISION
ELC	NR
MECH	NR
CIVIL	NR
ARCH	NR
INSTR	NR
GEN	NR

TI
APERTURE
CARD

NO.	DATE	REVISION	BY	CHK	APP

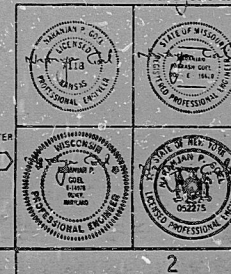

BECHTEL
SNUPPS
PIPING & INSTRUMENTATION DIAGRAM
SERVICE WATER SYSTEM



8409280208

PDR RIDS

