


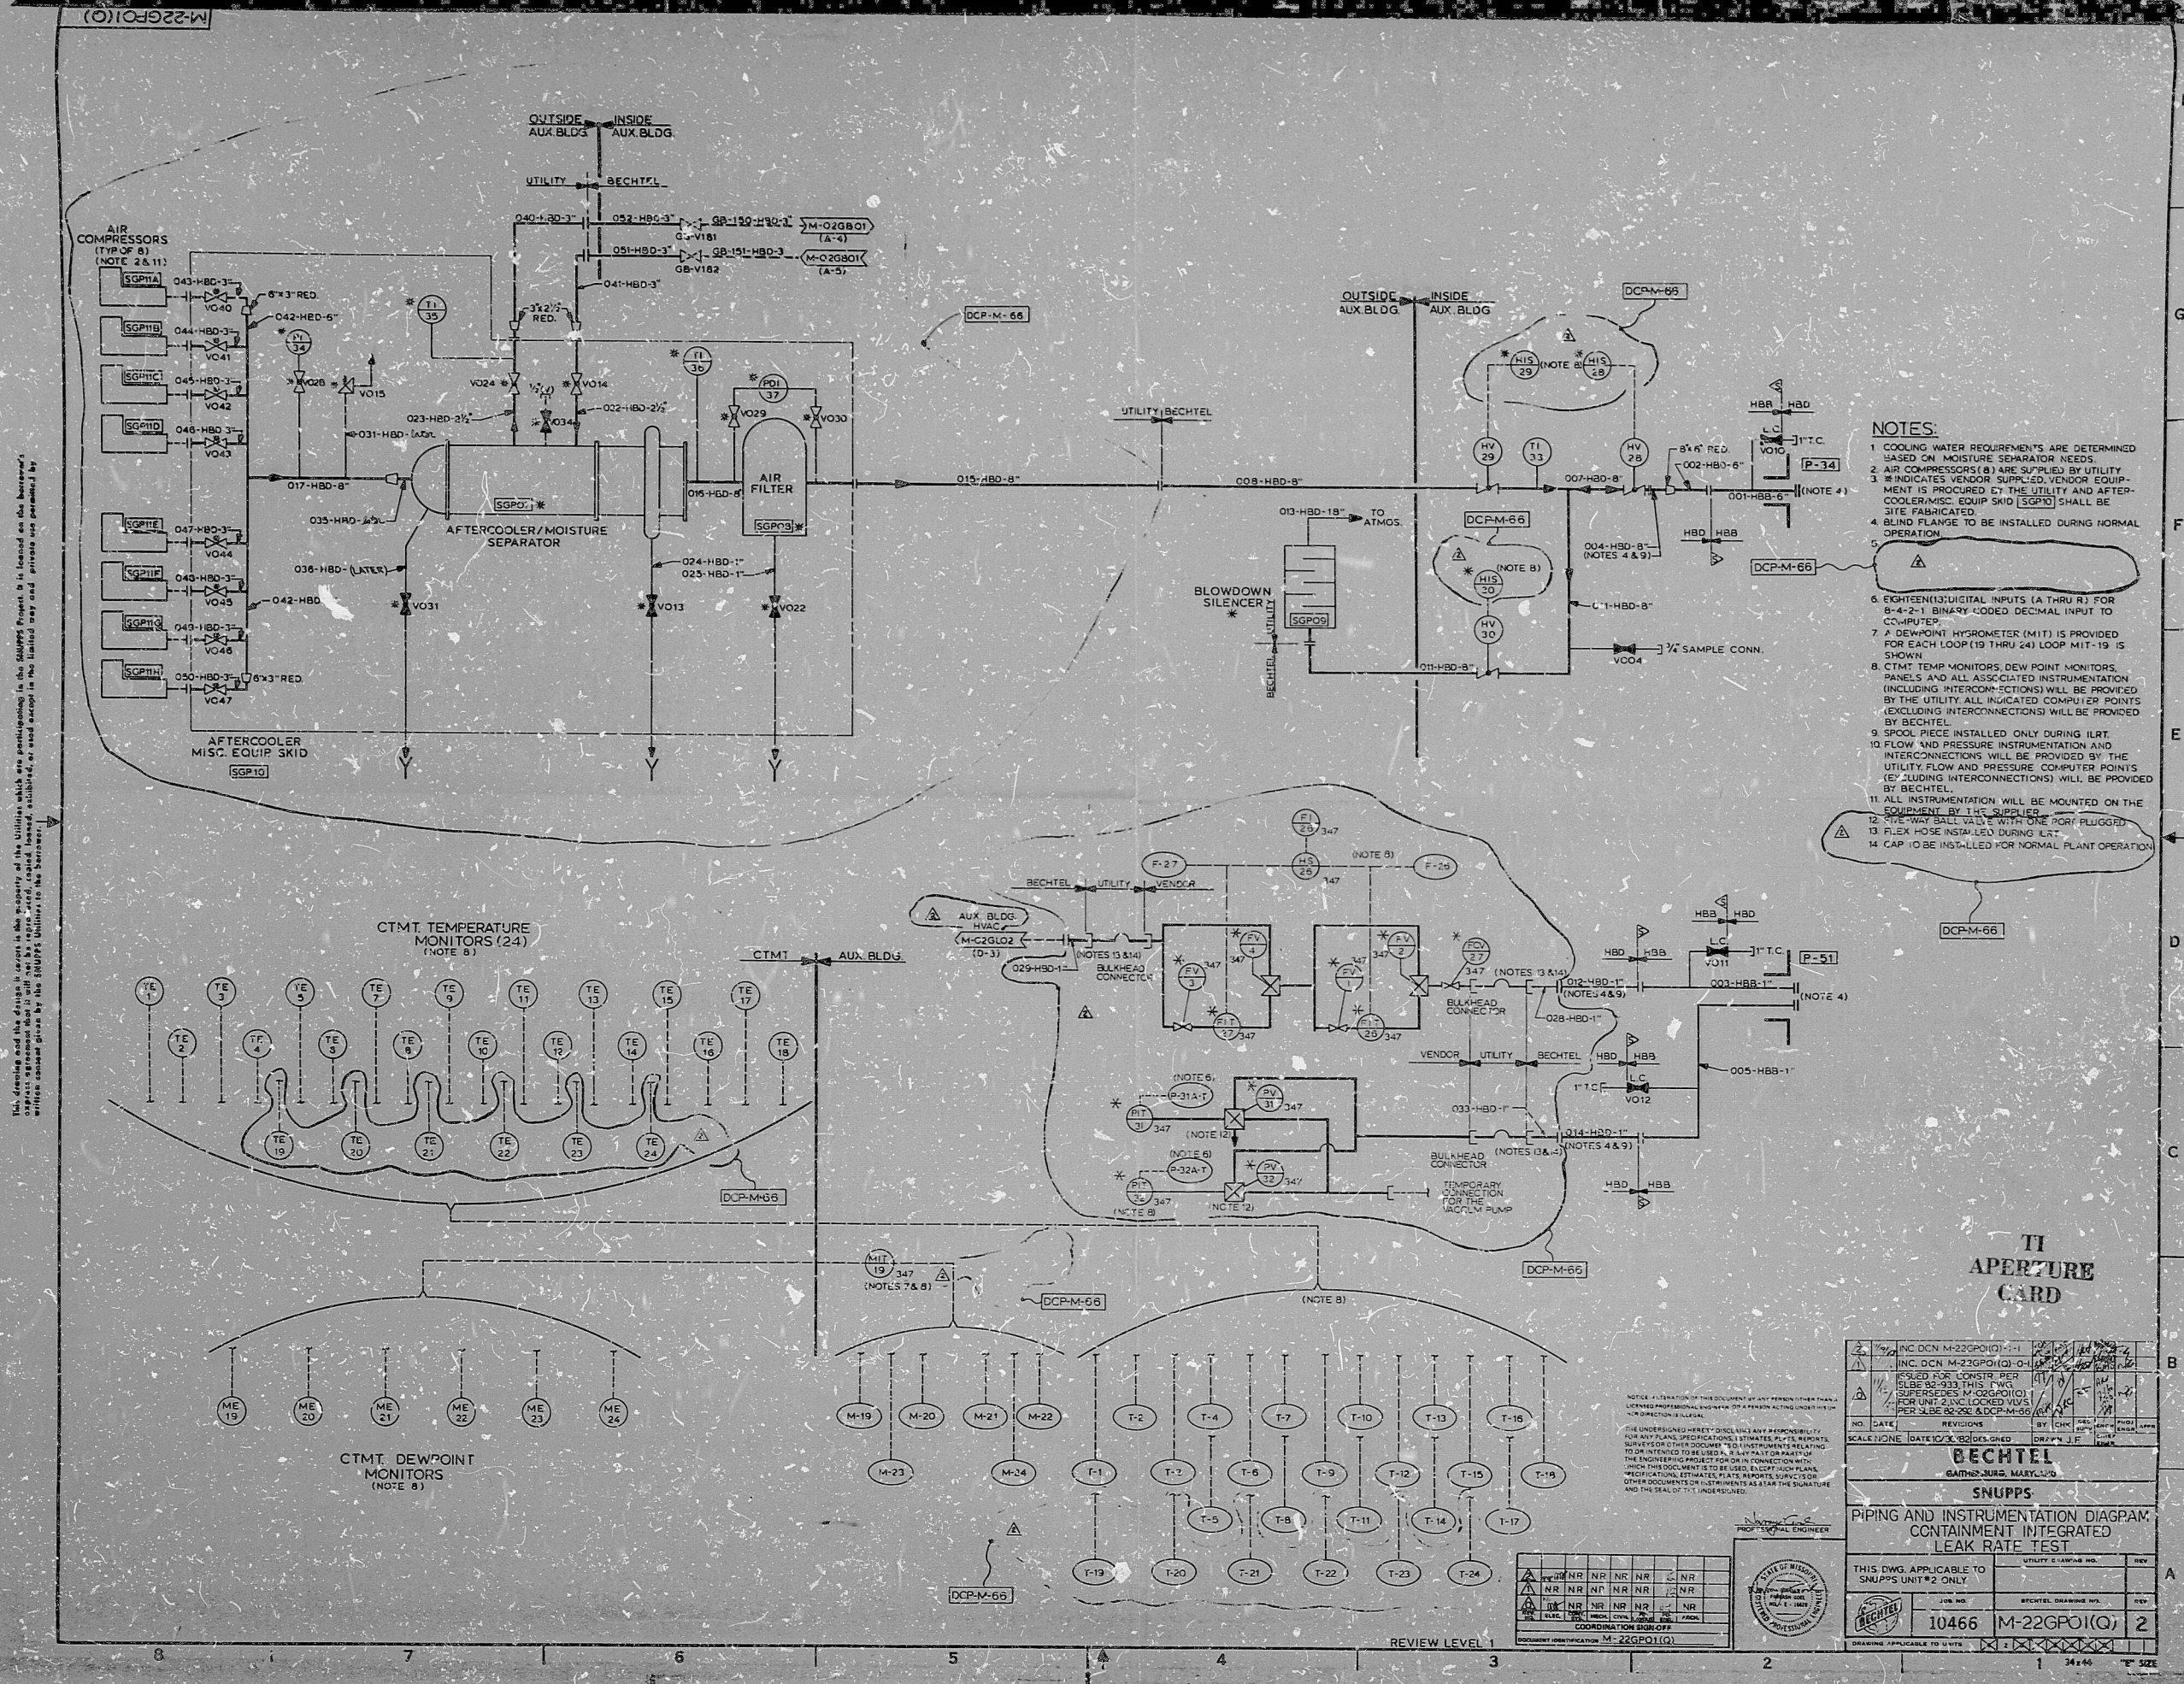

- NOTES:**
1. COOLING WATER REQUIREMENTS ARE DETERMINED BASED ON MOISTURE SEPARATOR NEEDS.
 2. AIR COMPRESSORS (8) ARE SUPPLIED BY UTILITY.
 3. IF INDICATES VENDOR SUPPLIED, VENDOR EQUIPMENT IS PROVIDED BY THE UTILITY AND AFTER-COOLER/MISC. EQUIP SKID (SGP10) SHALL BE SITE FABRICATED.
 4. BLIND FLANGE TO BE INSTALLED DURING NORMAL OPERATION.
 - 5.
 6. EIGHTEEN (18) DIGITAL INPUTS (A THRU R) FOR 8-4-2-1 BINARY CODED DECIMAL INPUT TO COMPUTER.
 7. A DEWPOINT HYGROMETER (MIT) IS PROVIDED FOR EACH LOOP (19 THRU 24) LOOP MIT-19 IS SHOWN.
 8. CTMT TEMP MONITORS, DEW POINT MONITORS, PANELS AND ALL ASSOCIATED INSTRUMENTATION (INCLUDING INTERCONNECTIONS) WILL BE PROVIDED BY THE UTILITY ALL INDICATED COMPUTER POINTS EXCLUDING INTERCONNECTIONS WILL BE PROVIDED BY BECHTEL.
 9. SPOOL PIECE INSTALLED ONLY DURING ILRT.
 10. FLOW AND PRESSURE INSTRUMENTATION AND INTERCONNECTIONS WILL BE PROVIDED BY THE UTILITY FLOW AND PRESSURE COMPUTER POINTS EXCLUDING INTERCONNECTIONS WILL BE PROVIDED BY BECHTEL.
 11. ALL INSTRUMENTATION WILL BE MOUNTED ON THE EQUIPMENT BY THE UTILITY.
 12. FIVE-WAY BALL VALVE WITH ONE PORT PLUGGED.
 13. FLEX HOSE INSTALLED DURING ILRT.
 14. CAP 10 TO BE INSTALLED FOR NORMAL PLANT OPERATION.

**II
APERTURE
CARD**

