


M-02HE02

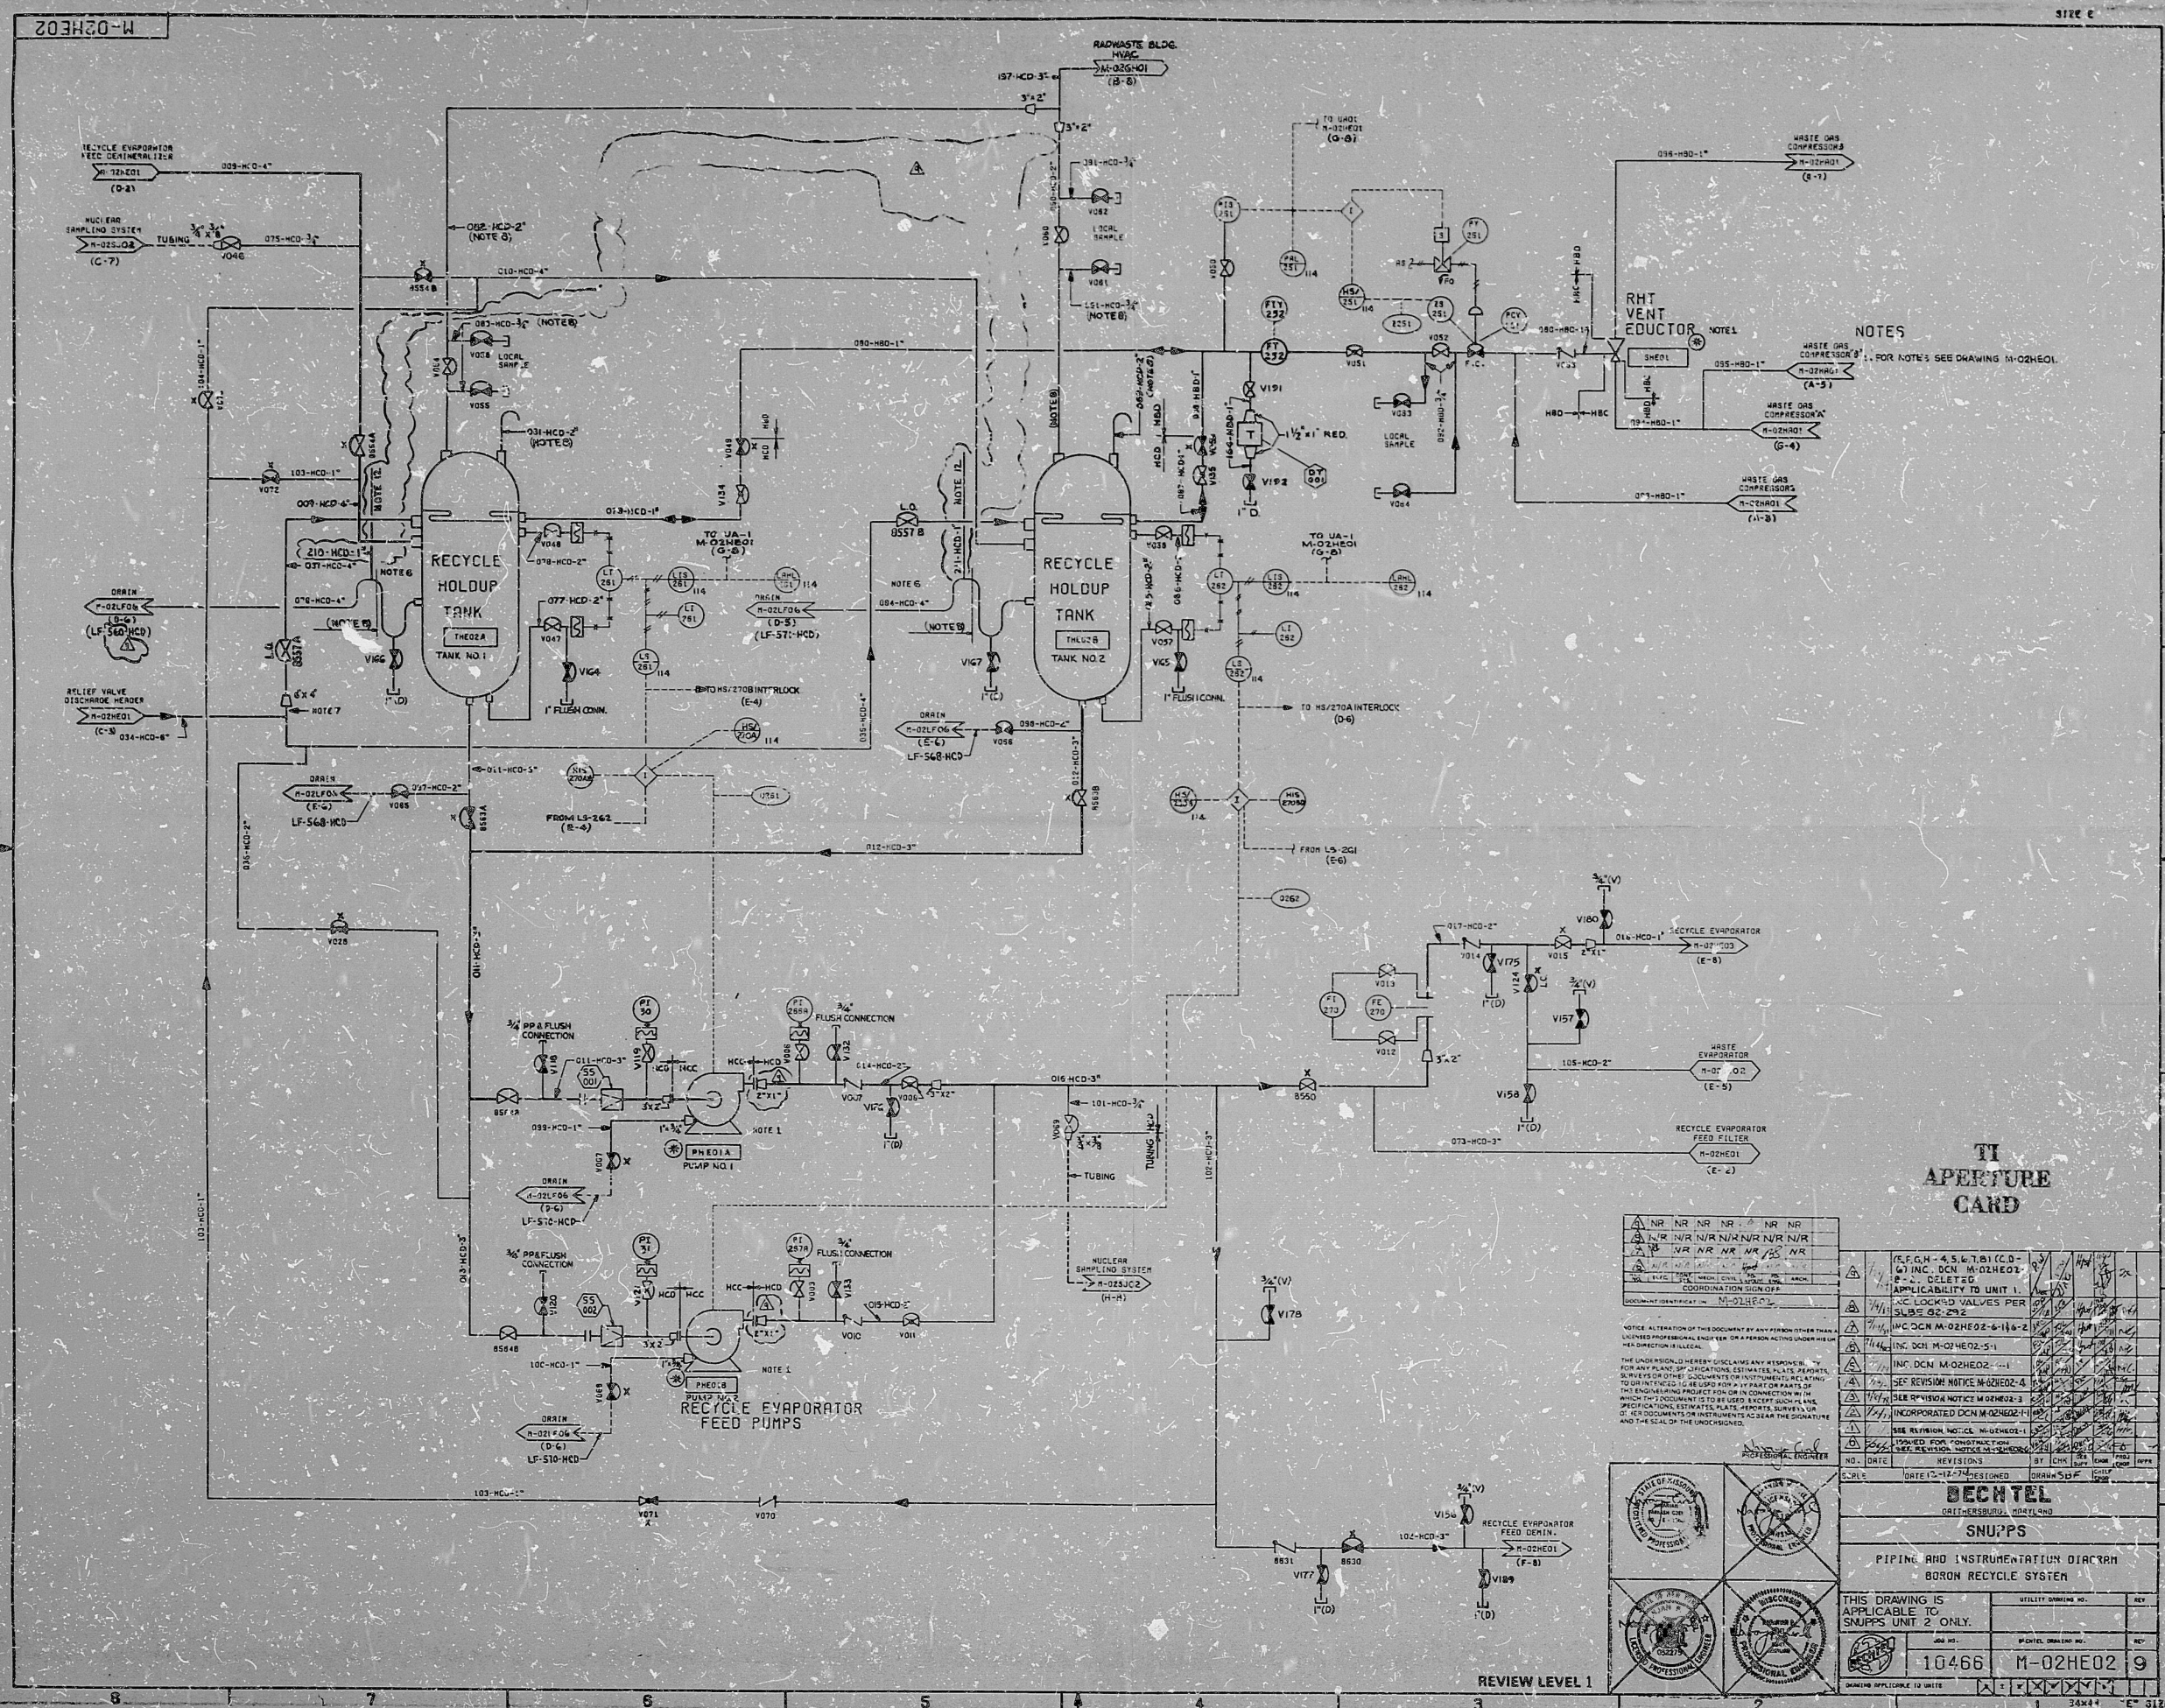

8409280526

PDR RIDS

