
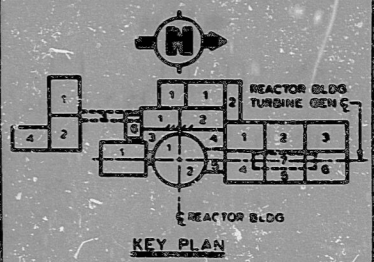




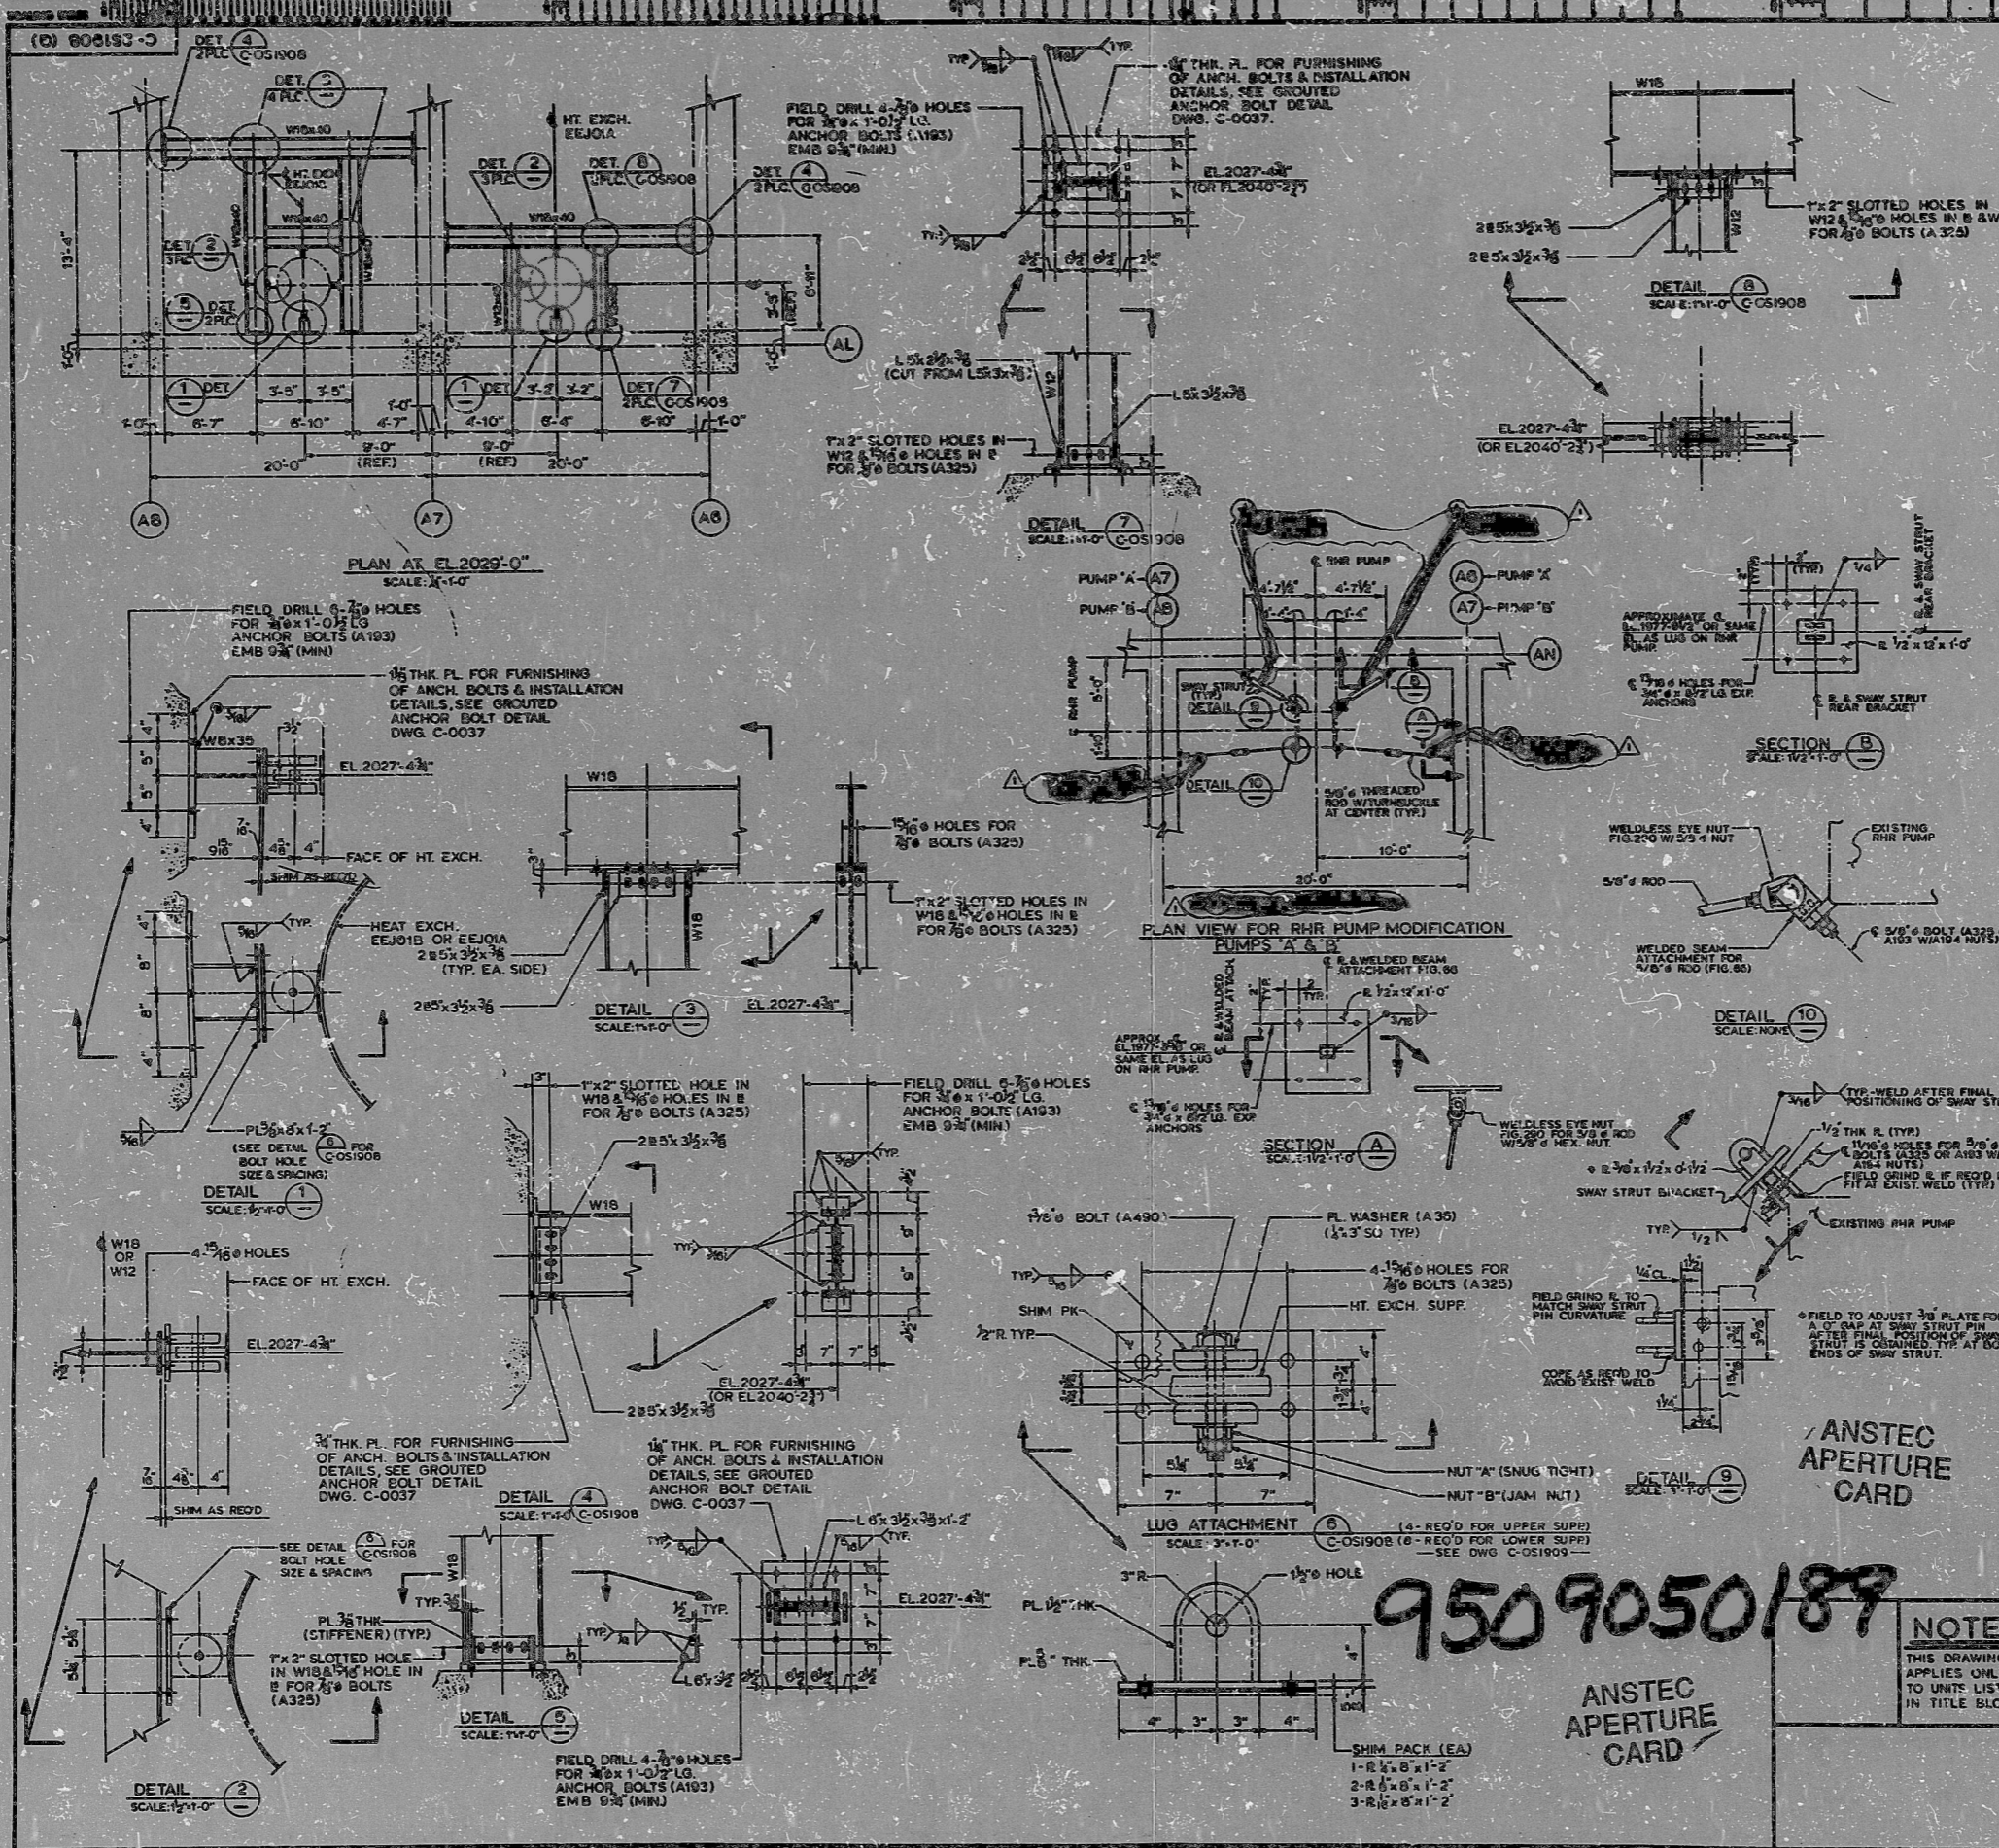

NOTES

- FOR GENERAL NOTES SEE DWG. C-0003.
- GENERAL INSTRUCTION FOR INSTALLATION OF RHR PUMP MODIFICATION:
 - A) INSTALL SWAY STRUTS WITHOUT PULLING THE MOTOR TO ITS ALIGNMENT.
 - B) INSTALL 3/8" THREADED RODS TO ACHIEVE A BALANCED SUPPORT CONFIGURATION WHILE MAINTAINING THE MOTOR ALIGNMENT.

REFERENCE DRAWINGS

- C-CC1411 AUXILIARY BLDG. - AREA 1 CONCRETE NEAT LINES PLAN-FLOOR EL.2026'-0"
- C-OC1421 AUXILIARY BLDG. - AREA 2 CONCRETE NEAT LINES PLAN-FLOOR E..2026'-0"
- C-OS1909 AUXILIARY BLDG MISC STEEL HEAT EXCHANGER SUPPORTS
- C-OS1904 AUXILIARY BLDG-STRUCTURAL STEEL PUMP PEDESTAL S-ANS AND DETAILS

MATERIAL RESPONSIBILITY

- MISCELLANEOUS STEEL TO BE SUPPLIED UNDER SPEC. 10466-C-131
- ALL MATERIALS SHOWN FOR THE PUMP MODIFICATION SHALL BE PROVIDED BY THE OWNER. SWAY STRUTS, WELDED BEAM ATTACHMENT, WELDED EYE NUTS & THREADED RODS SHALL BE PROVIDED BY THE CONTRACTOR. ALL MATERIAL SHALL BE PROVIDED BY THE CONTRACTOR.

INFORMATION ONLY

<p>NOTE: THIS DRAWING APPLIES ONLY TO UNITS LISTED IN TITLE BLOCK</p>	<p>ANSTEC APERTURE CARD</p>
<p>BECHTEL COURTESY, BECHTEL</p>	<p>SNUPPS AUXILIARY BLDG. MISCELLANEOUS STEEL HEAT EXCHANGER SUPPORTS</p>

9509050189

ANSTEC APERTURE CARD

601850 808

PDR RIDS

9509050189

