


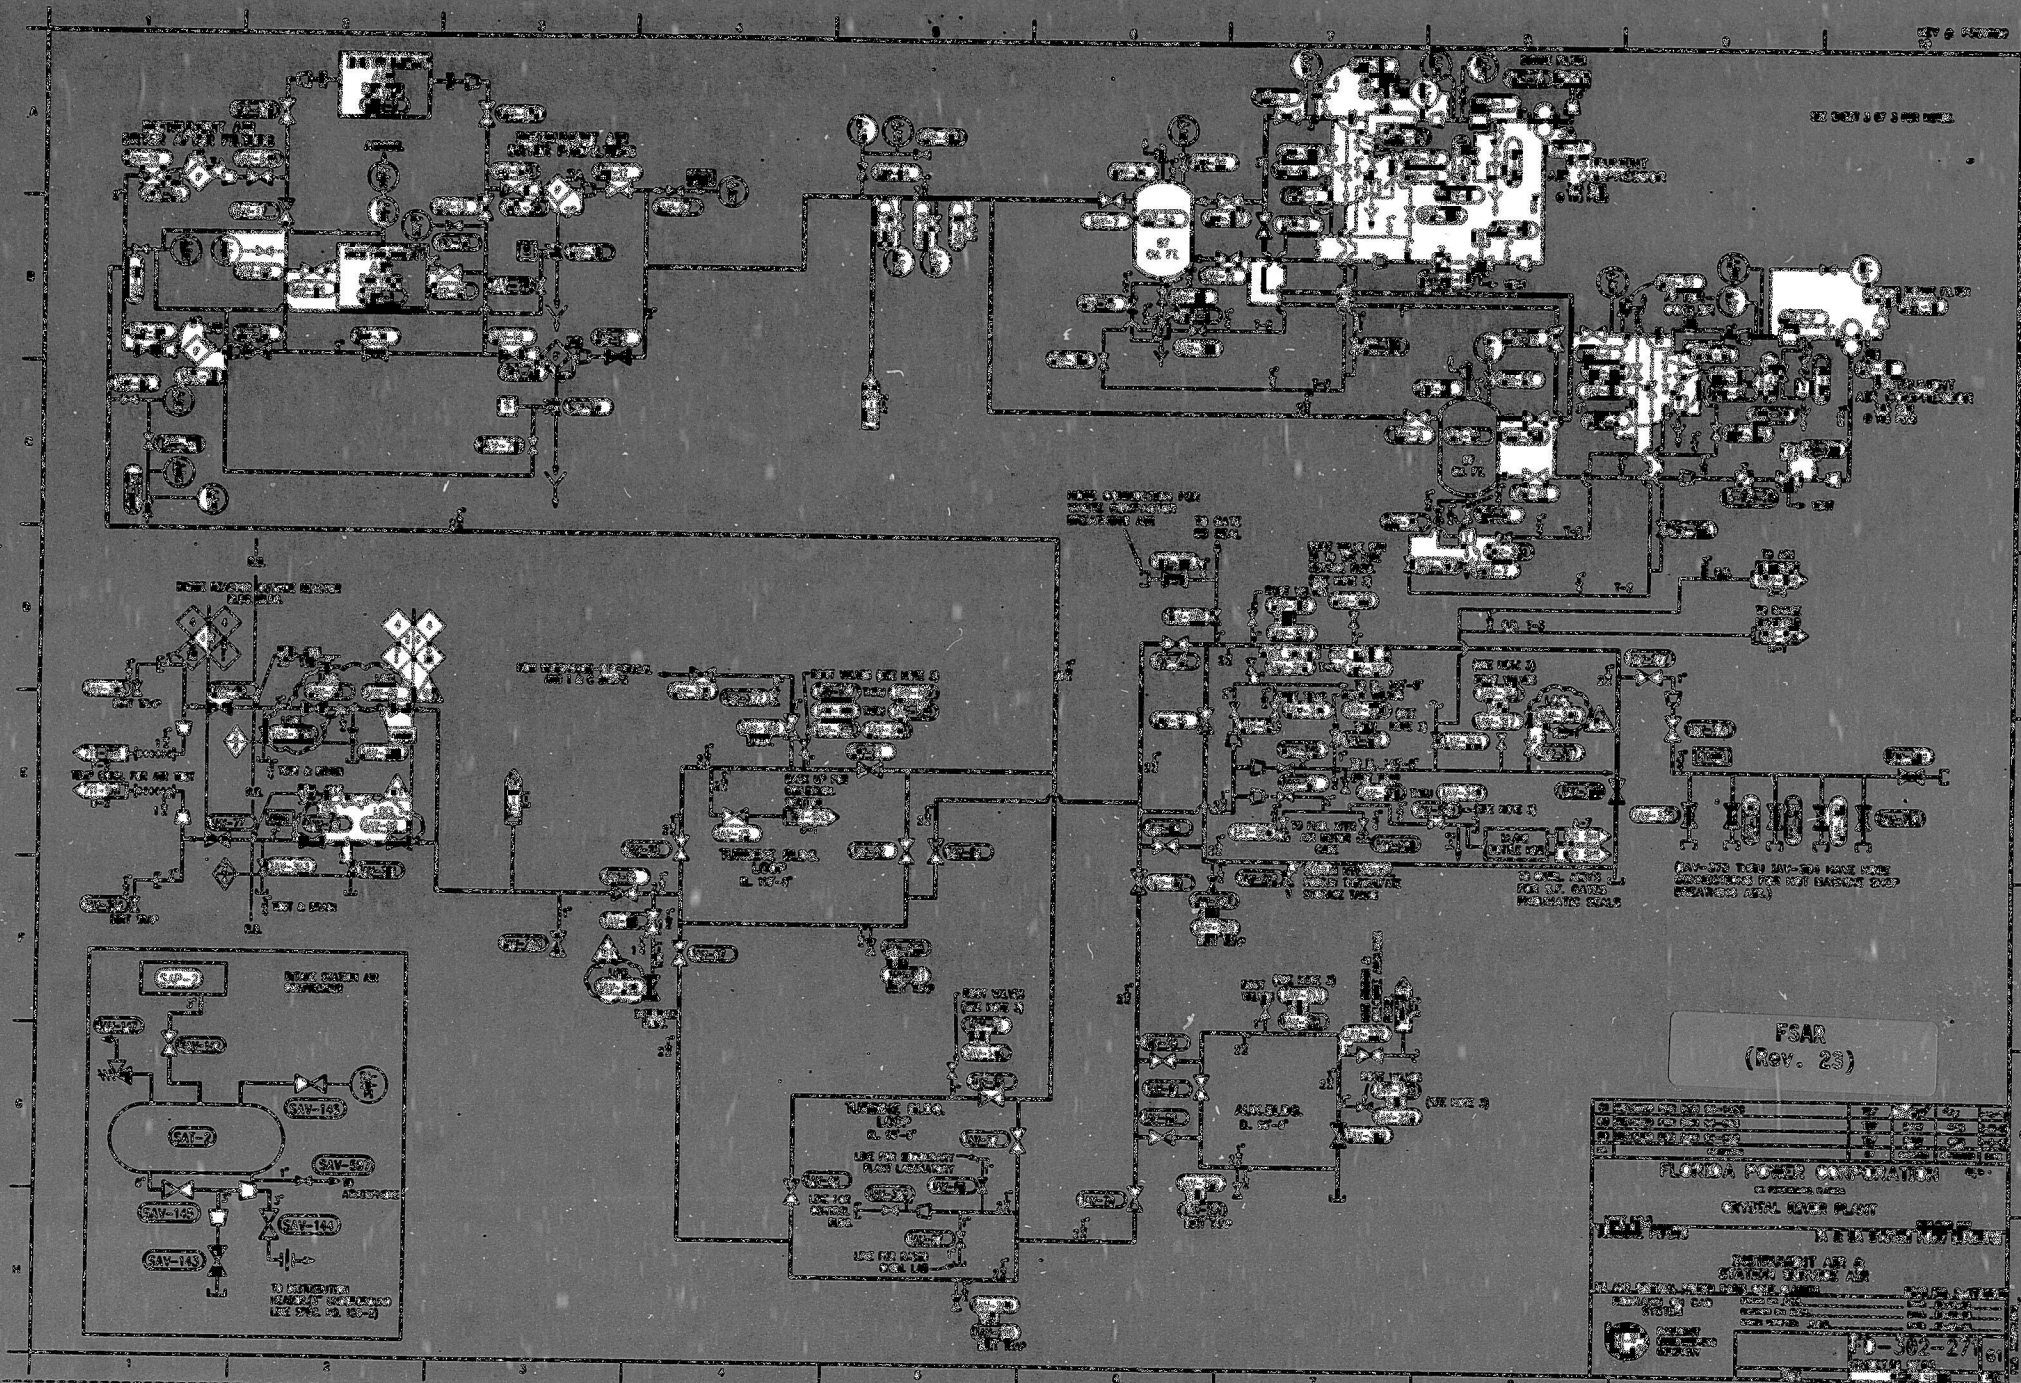

FSAR
(REV. 23)

FLORIDA POWER CORPORATION	
DATE	
BY	
CHECKED BY	
APPROVED BY	

ANSTEC
APERTURE
CARD

9611290319

PDR RIDS

9611290319

