


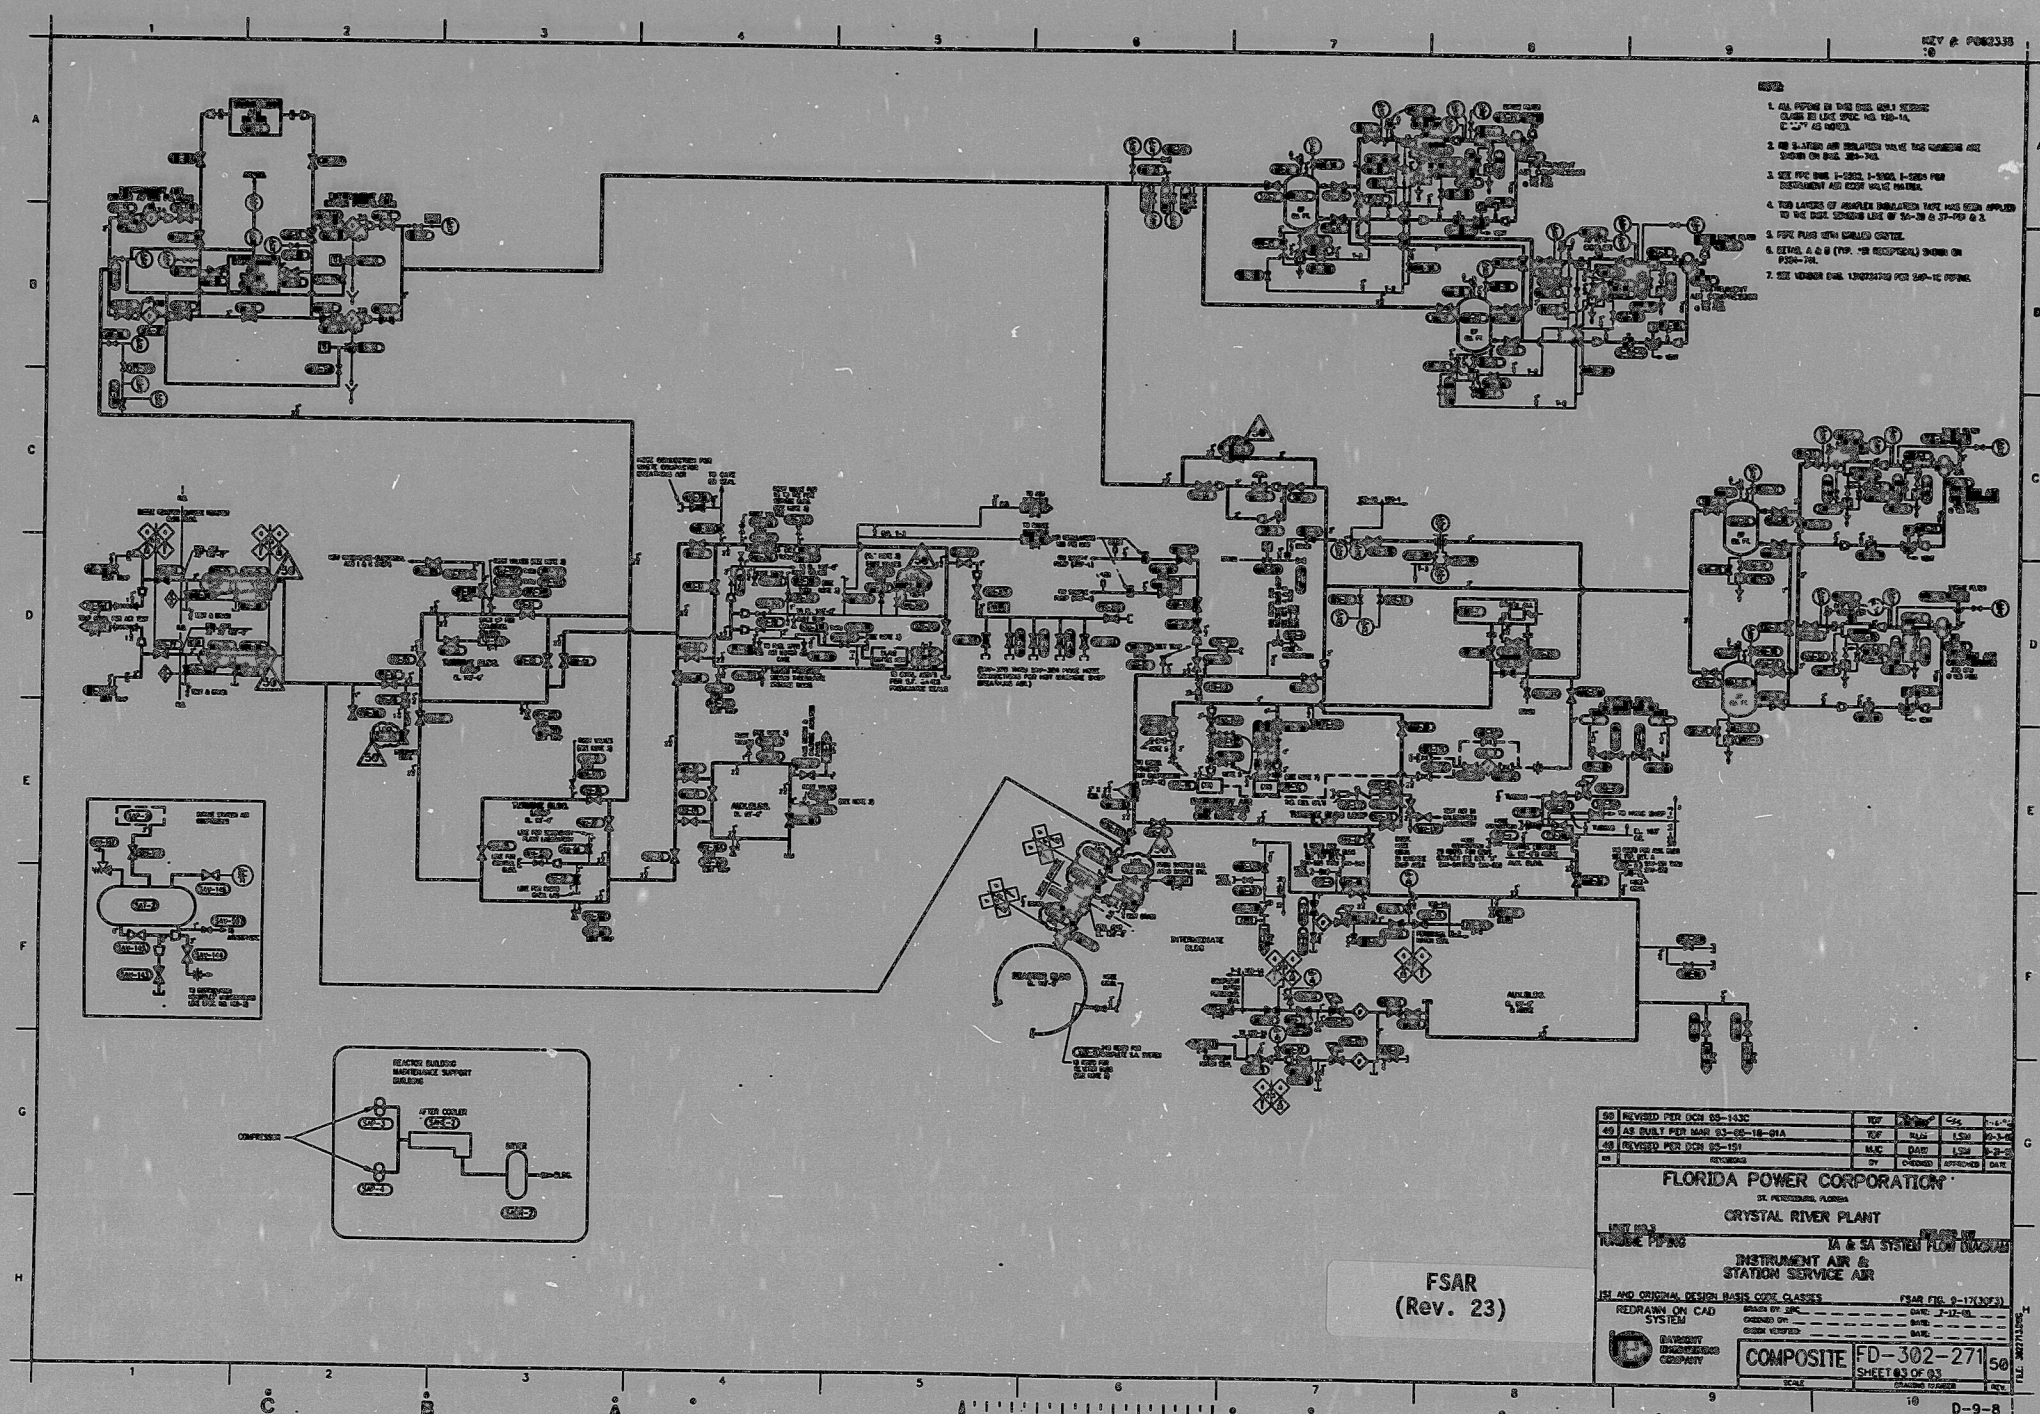

- NOTES

FSAR
(Rev. 23)

REVISIONS		REV.	DATE	BY	CHKD.

FLORIDA POWER CORPORATION
ST. PETERSBURG, FLORIDA
CRYSTAL RIVER PLANT
INSTRUMENT AIR & STATION SERVICE AIR
COMPOSITE
FD-302-271

ANSTEC
APERTURE
CARD

9611290324

PDR RIDS

9611290324

