




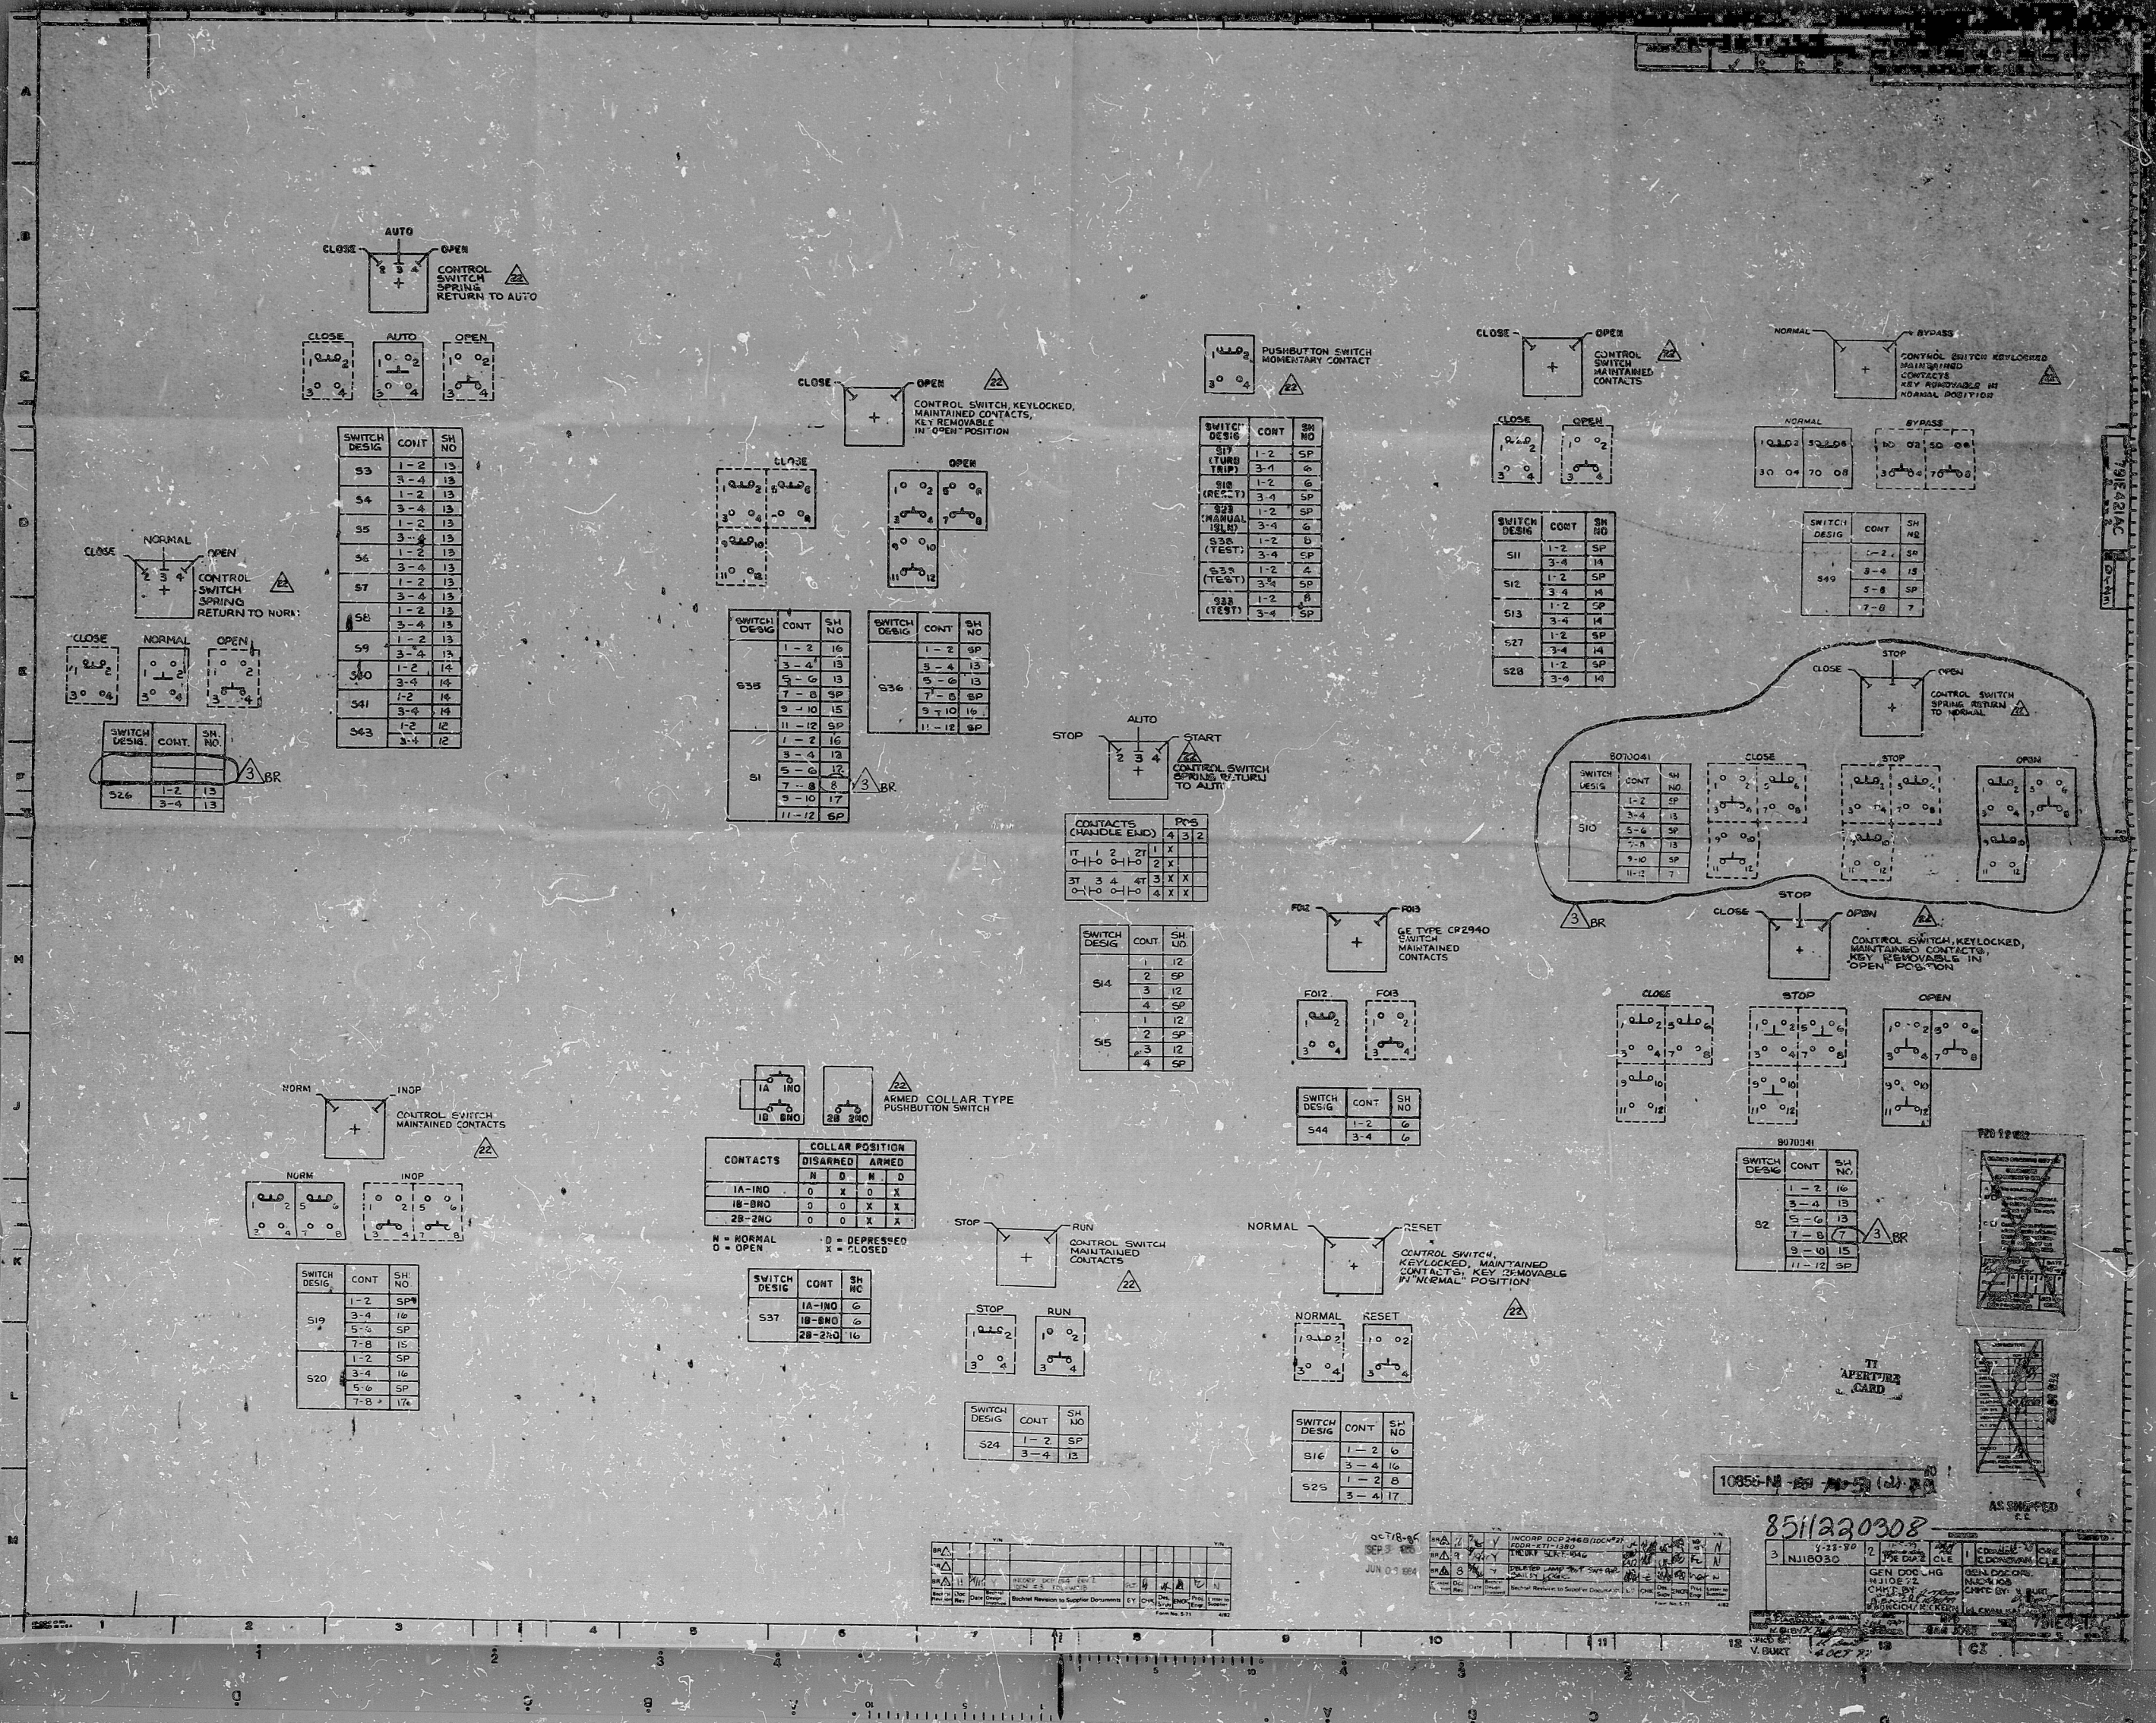

PDR RIDS

8511220308

