


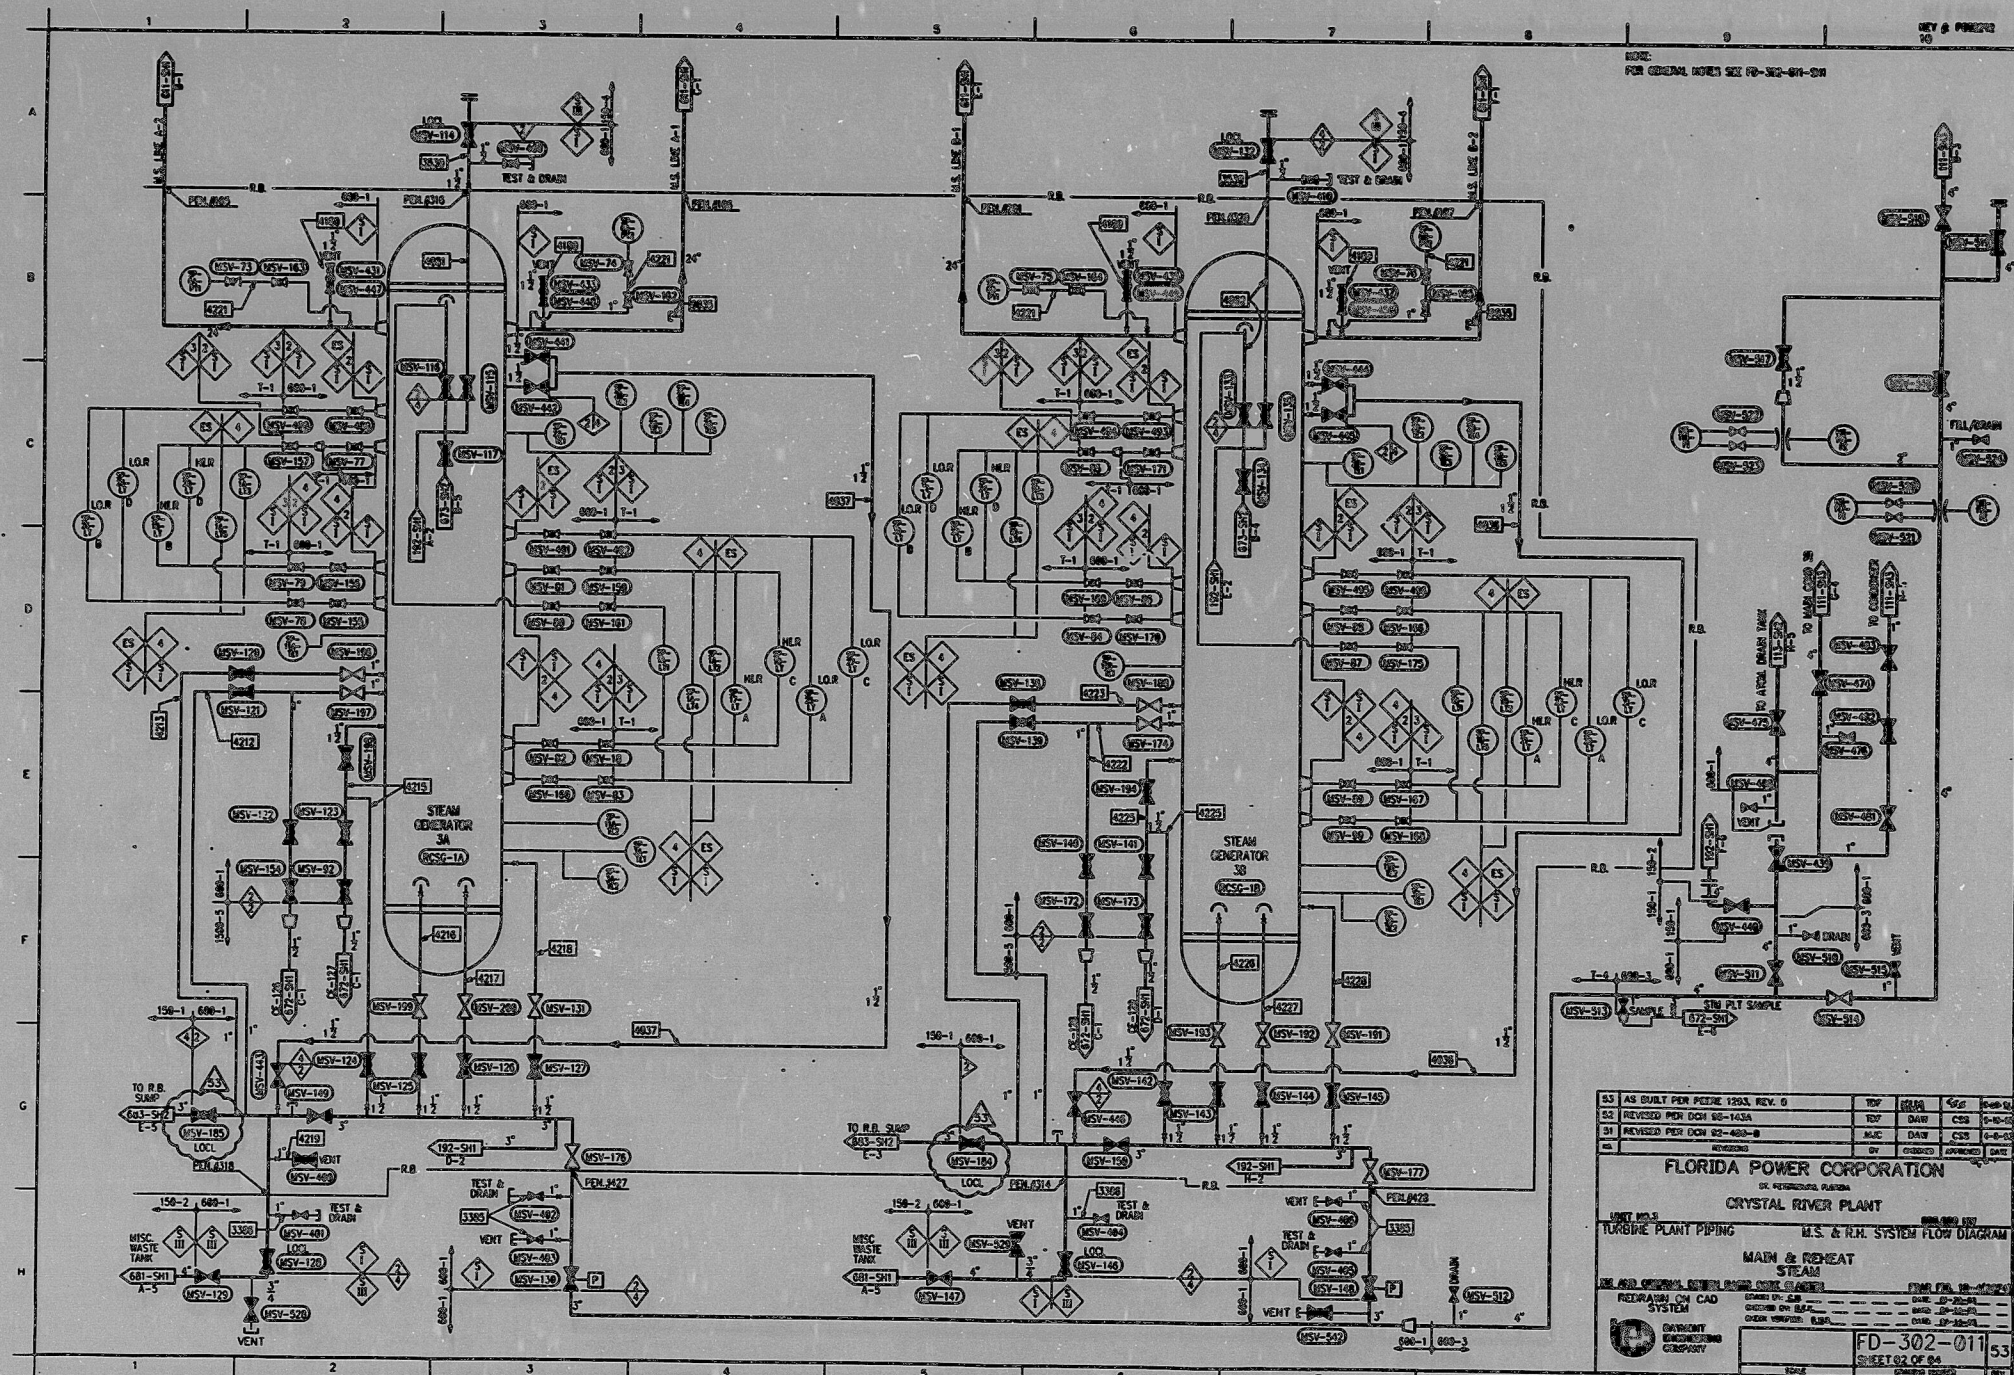

ANSTEC
APERTURE
CARD

FSAR
(Rev. 23)

9612020075

PDR RIDS

9612020075

