


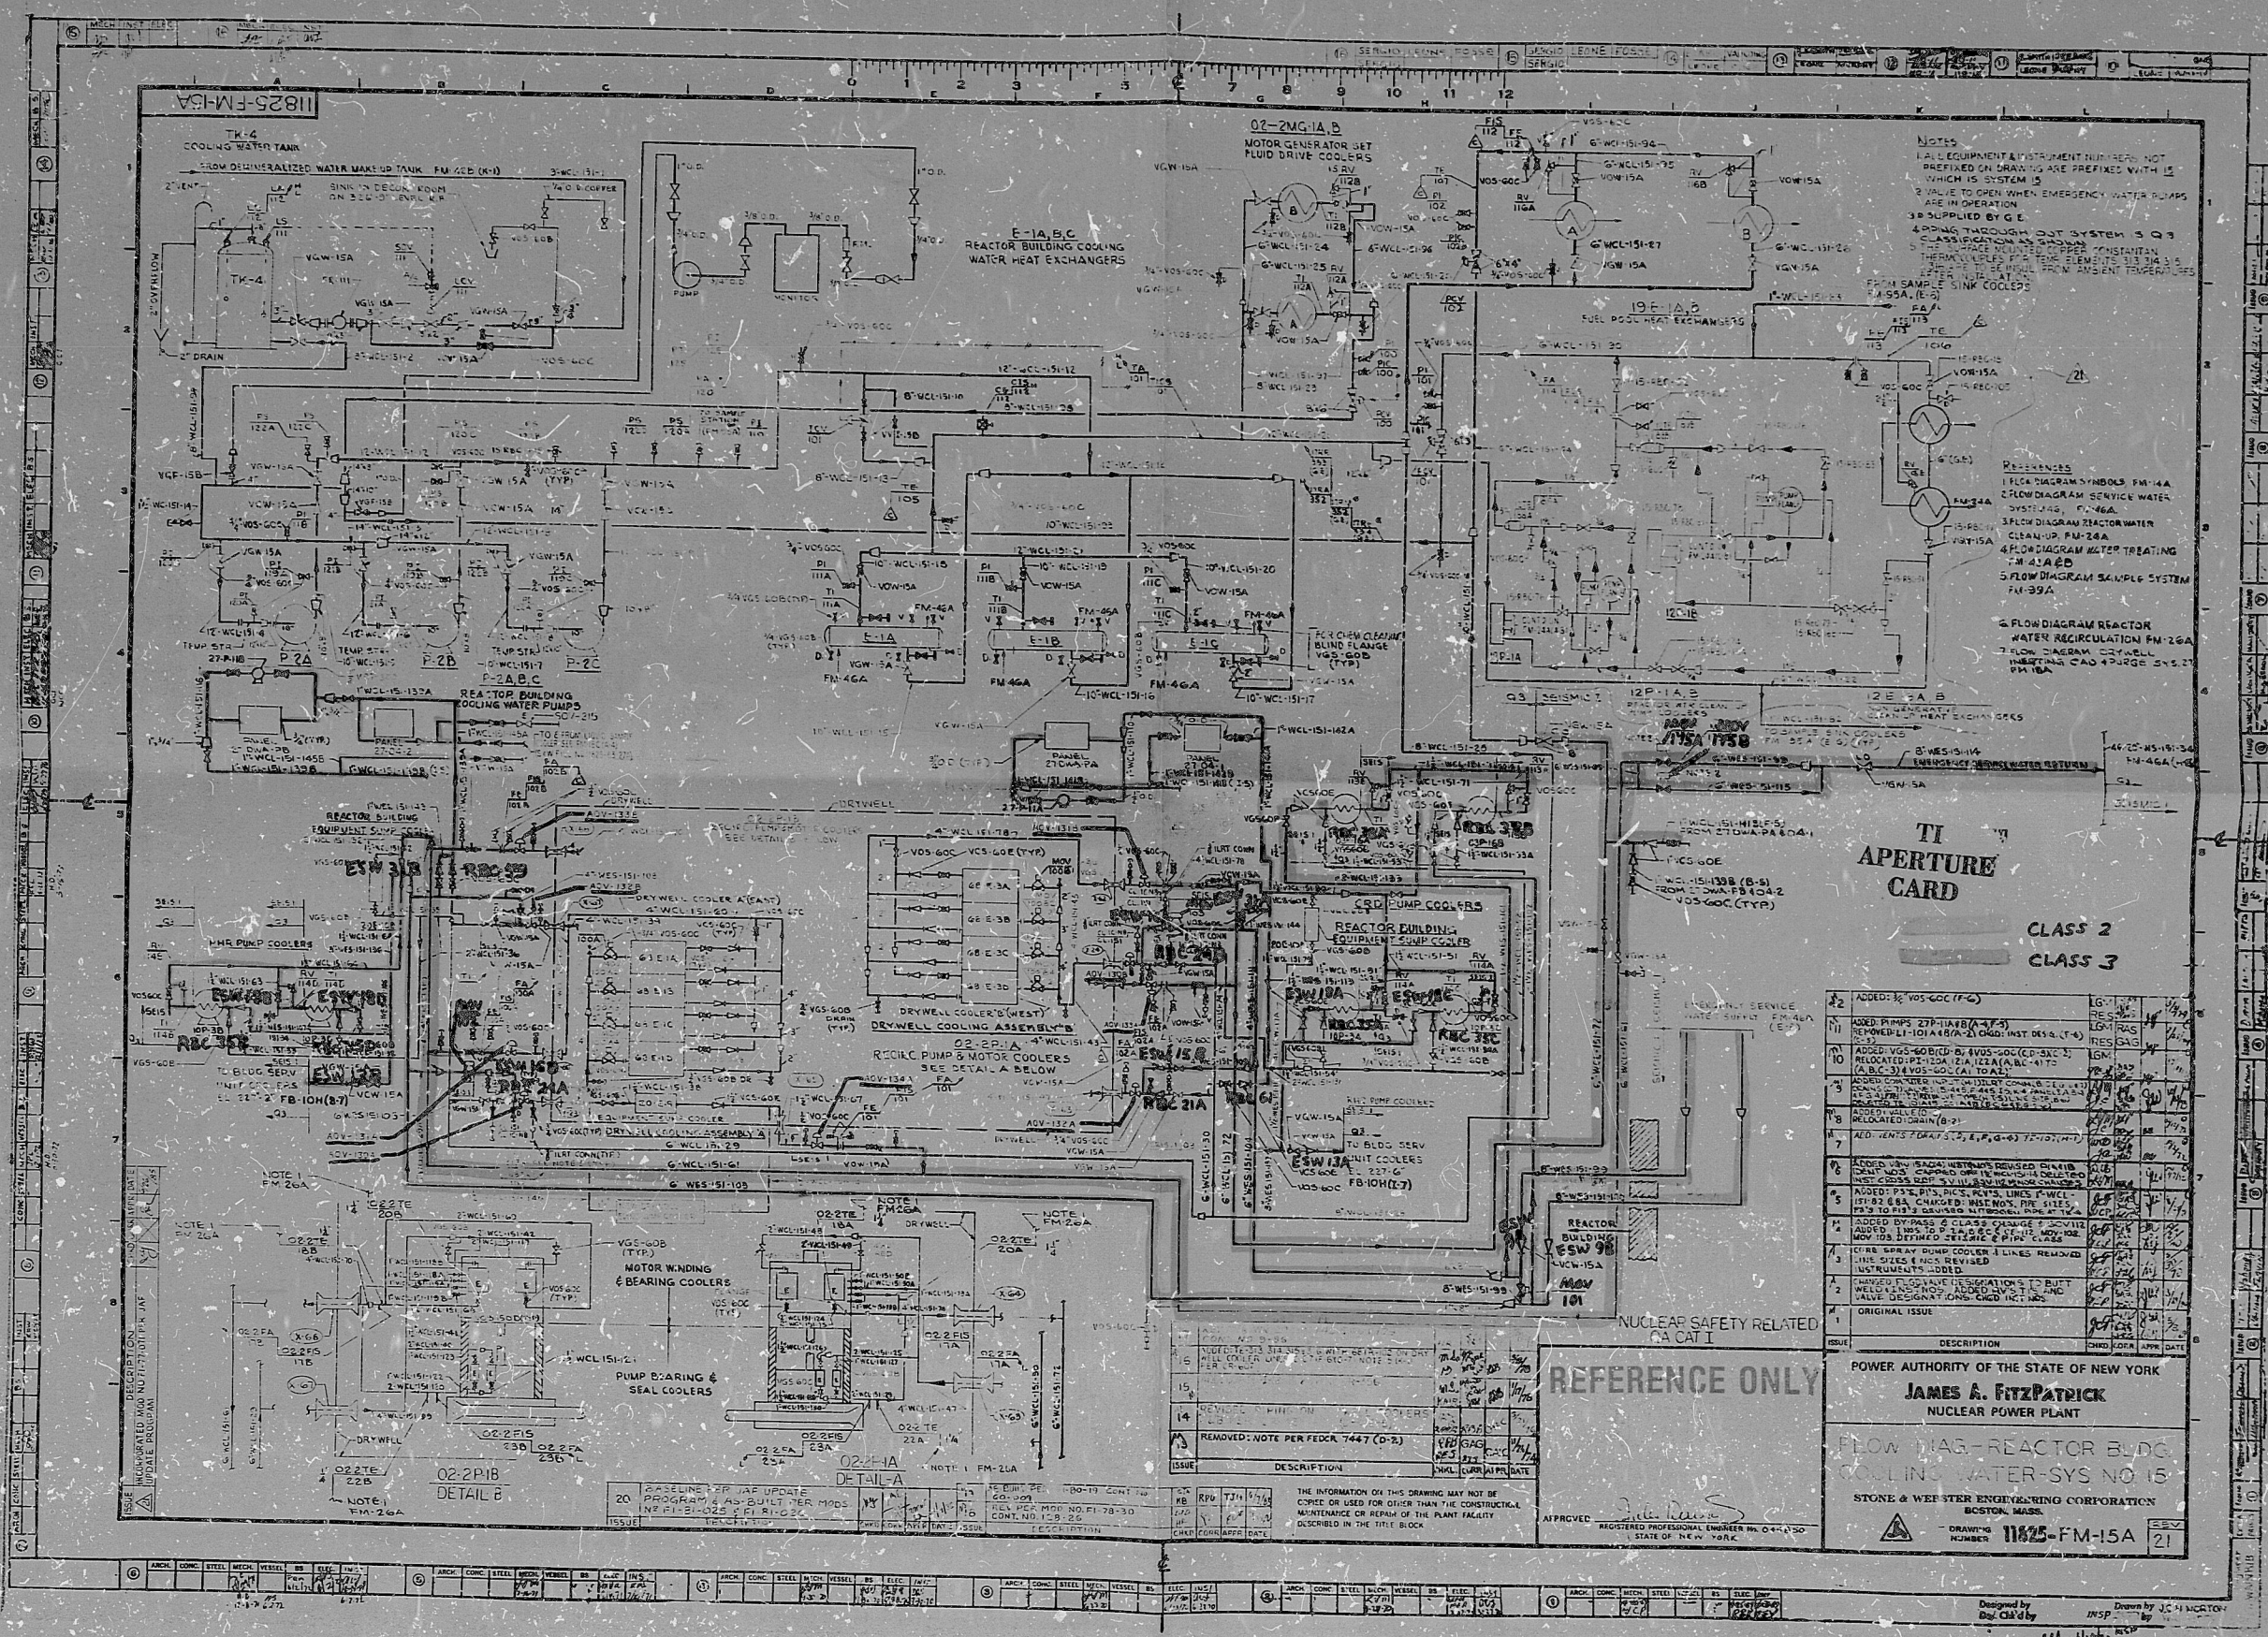

PDR RIDS

8511260021

