


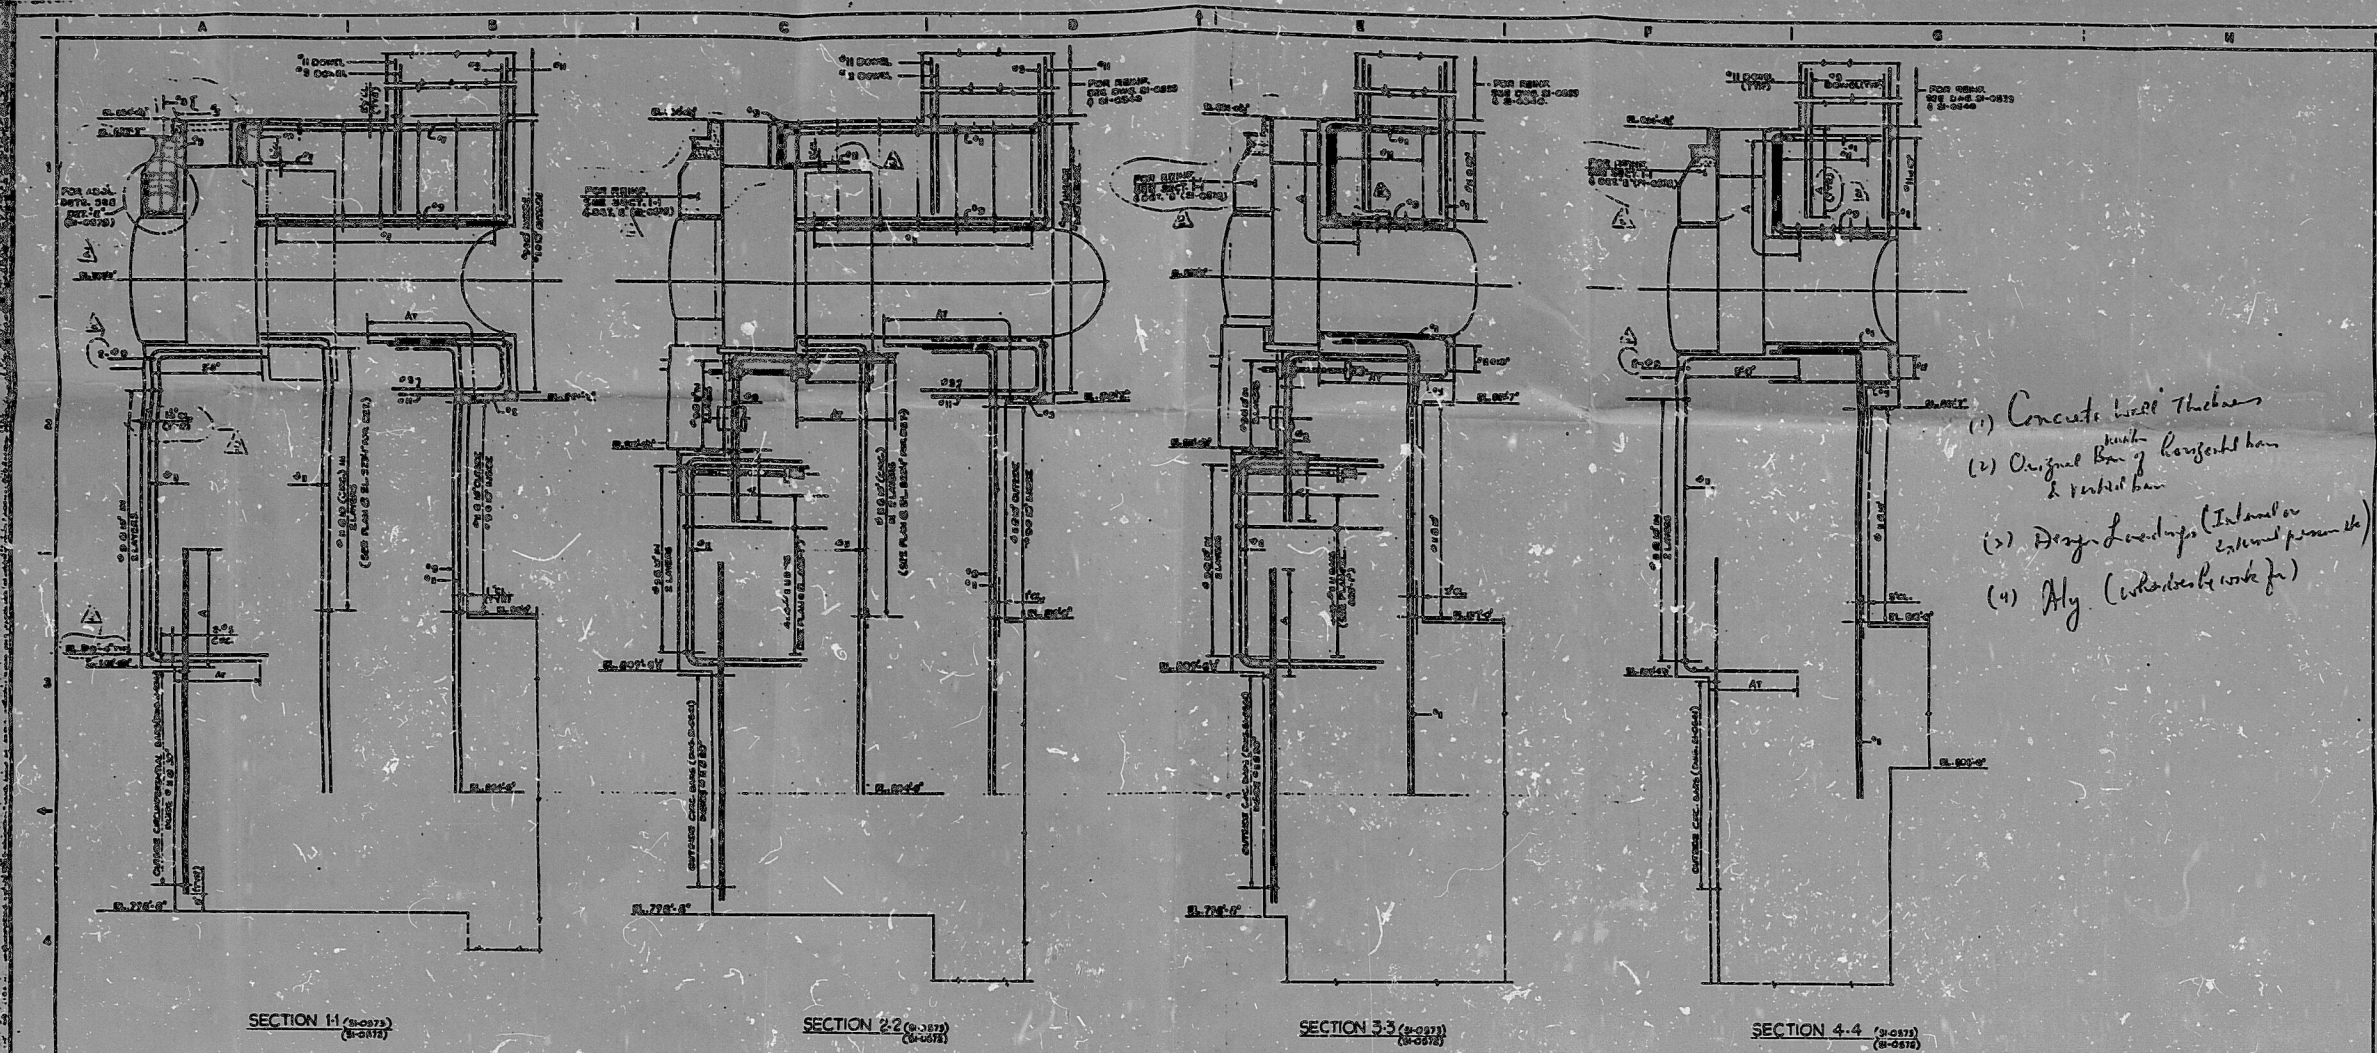

- (1) Concrete Wall Thickness
- (3) Design Loadings (Internal or External pressure)
- (4) Aly. (wherever applicable)

VOID

**FOR OFFICE AND
ENGINEERING USE ONLY**

**TI
APERTURE
CARD**

CLASS I	
TEXAS UTILITIES SERVICES INC.	
DALLAS POWER & LIGHT COMPANY	
TEXAS ELECTRIC SERVICE COMPANY	
TEXAS POWER & LIGHT COMPANY	
COMMANCHE PEAK A.S.	
1960-62-1200 MW INSTALLATION	
R. B. INTERNAL STRUCT.	
REACTOR CAVITY REIN.	
SECT'S & DETS. SH. 3	
DATE: 1-1-60	SCALE: 1/4" = 1'-0"
2323-SH-0574	



8512020260

FOIA-85-59
(101)

PDR

8512020260

