

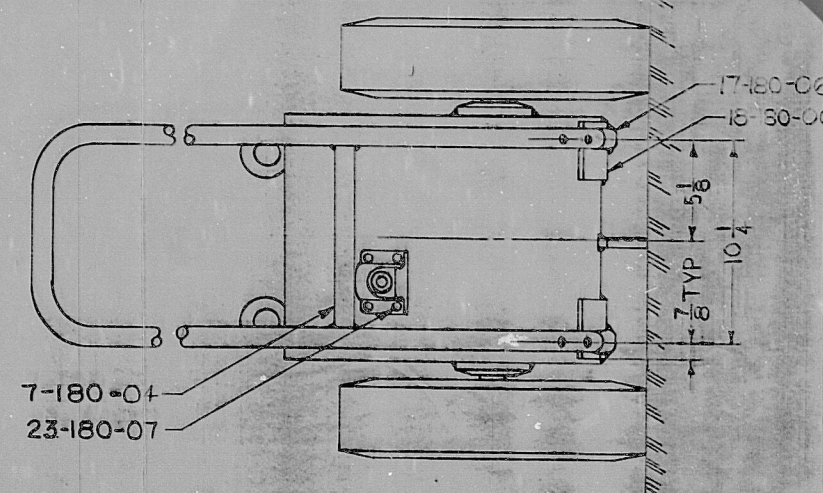
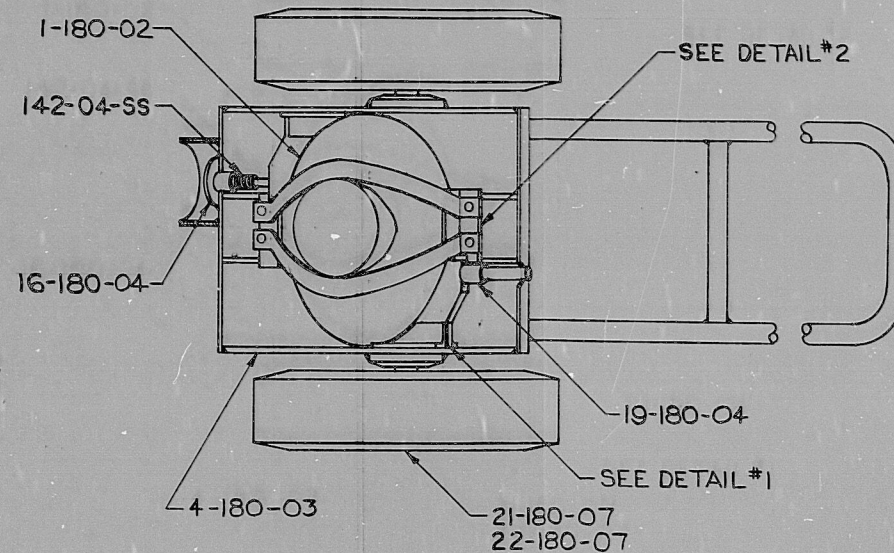



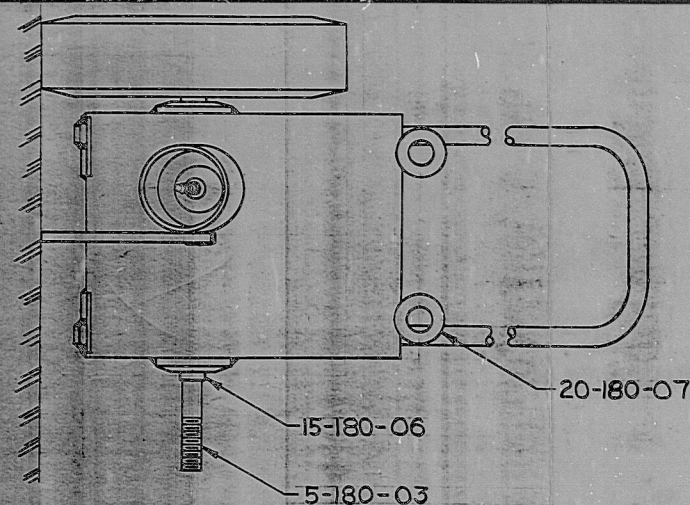


DETAIL # 1

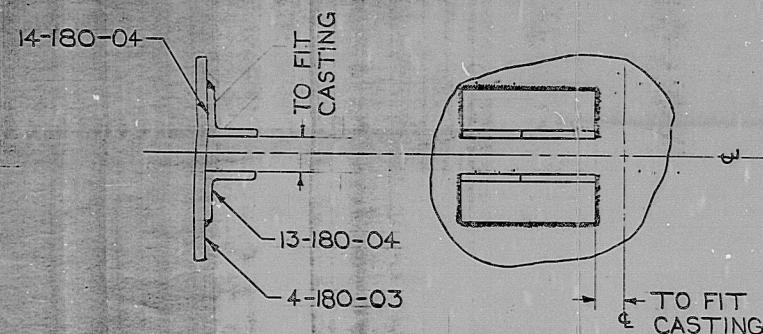


DETAIL # 2


CLEARANCE
BETWEEN
CASTING AND
180-06 BEND
180-06 TO
CASTING AS
SHOWN.

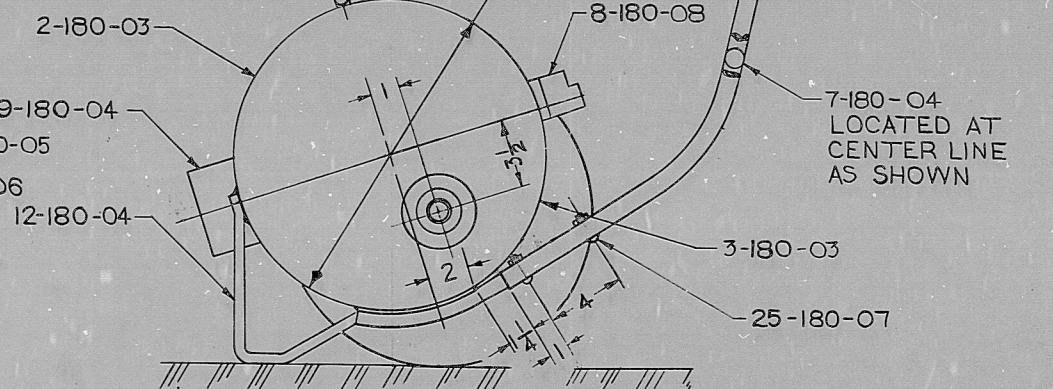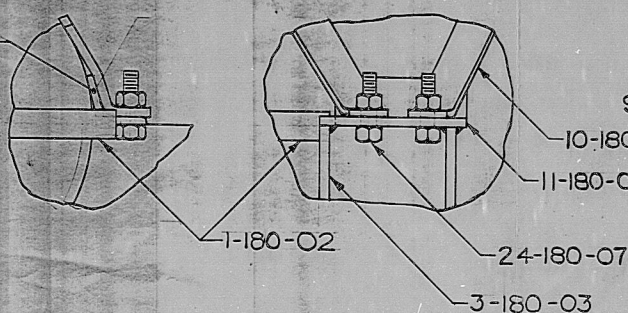

9701080059

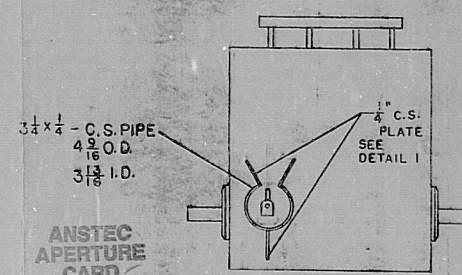

RETROFIT
To Qualify For
Type B Std.

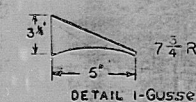

REVISIONS		GAMMA INDUSTRIES BATON ROUGE, LA.	
RETROFIT	5-5-78	ASSEMBLY GAMMATRONS	
		SCALE:	DRAWN BY J.R.G.
		DATE: 7-17-70	REVISED:
		20A, 50A, 100A, 200A	
		20, 50, 100, 200	

PDR RILS 9701080059

9701080059

