

NON-CONTROLLED PRINT
 JUL 16 1995
 NPPD PAS

INFORMATION ONLY



THIS DRAWING GENERATED BY N.P.P.D.


ANSTEC
 APERTURE
 CARD


AS BUILT

484003895

REVISIONS

MAR. 31, 1995 NPPD

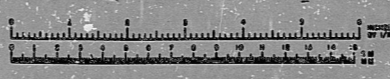

PDR

9512040102

