


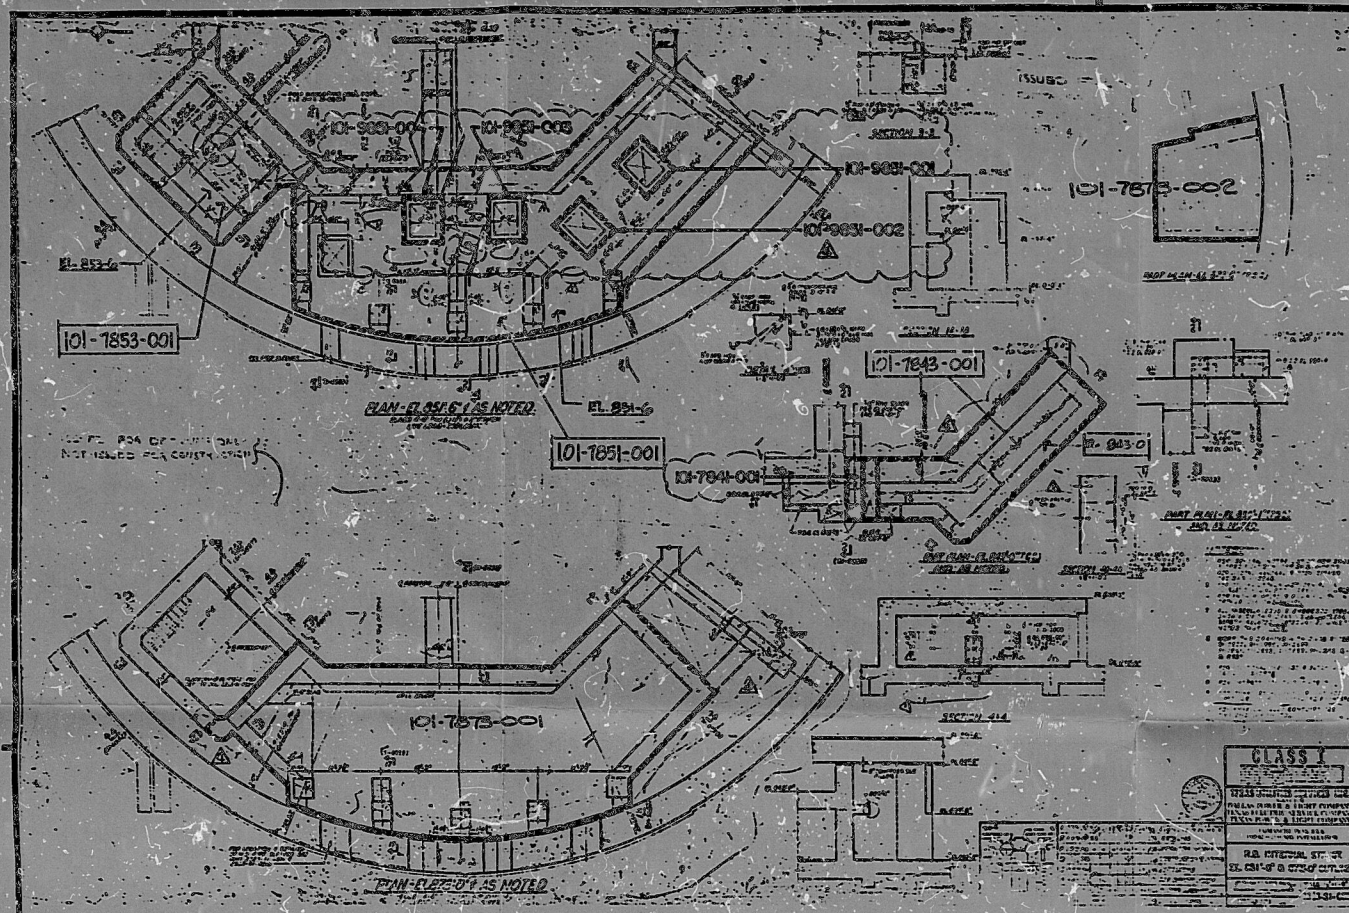

ROR NUMBER	APPROVAL

FOR OFFICE AND
ENGINEERING USE ONLY


--	---	---	--	---	---------------------------------------	---	-------------------------------------

85/2030273
 FOIA-85-59
 C/381

PDR

8512030273

