

NON-CONTROLLED PRINT  
 JUL 18 1995  
 NPPD PAS

INFORMATION  
 ONLY

ANSTEC  
 APERTURE  
 CARD


AS BUILT

454003605

BURNS AND ROE, INC.  
 ENGINEERS AND ARCHITECTS  
 FLOOR CHASERS  
 TURBINE & RADWASTE BLDG. CONTAMINATED  
 FLOOR DRAIN & WASHROOM DRAIN SYSTEMS  
 COMMUNITY PUBLIC POWER DISTRICT  
 COOPER NUCLEAR STATION  
 W. O. 2520  
 DWG. 2017

NO.	DATE	BY	CHKD.	REVISION
1	11/10/92	JPL	WAD	AS BUILT
2	11/10/92	JPL	WAD	REVISION 1: CORRECTED PIPING AND VALVE SYMBOLS TO MATCH FIELD DRAWING.

JUNE 16, 1992 NPPD

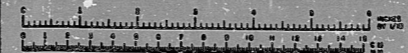

PDR

9512040119

