

- NOTES**
1. PIPING PENETRATIONS THROUGH WALLS AND FLOORS SHALL BE PROVIDED WITH GASKETS AND CONTAINMENT UNDER CONTINGENCY 10-1-1.
 2. SUPPLY POINT SP-1 LINE UP TO AND INCLUDING THE POINT OF BRANCHING AND INSTALLED GASKETS SHALL BE PROVIDED WITH GASKETS UNDER CONTINGENCY 10-1-1.
 3. REPLACEMENT PLANS FOR THE REACTOR RECIRCULATION AND SUPPRESSION CHAMBER VENT SYSTEMS SHALL BE PROVIDED BY THE DESIGNER AND SHALL BE INSTALLED BY THE CONTRACTOR UNDER CONTINGENCY 10-1-1.
 4. HIGH POINT VENTS AND LOW POINT DRAINS SHALL BE PROVIDED.

INFORMATION ONLY

NON-CONTROLLED PRINT
 JUL 18 1965
 NPPD PAS.




AS BUILT 454003617

PARSONS AND ROE, INC.
 ENGINEERS AND CONSULTANTS
 CONSTRUCTION AND OPERATIONS
 FLOW DIAGRAM
 REACTOR RECIRCULATION AND SUPPRESSION
 CHAMBER VENT SYSTEMS CONNECTION
 CONSUMERS PUBLIC POWER DISTRICT

| NO. | DATE | BY | DESCRIPTION |
|-----|---------|------|-------------|
| 1 | 7/18/65 | W.C. | AS BUILT |

MAR. 31, 1995 NPPD

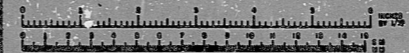

PDR

9512040153

