

DRAWING SUBJECT TO REVISION PER DC 29-284
 DRAWING BEING REVIS'D PER DC#

NON-CONTROLLED PRINT
 JUL 16 1995
 N.P.P.D. R.A.S.

INFORMATION ONLY

- NOTES:
1. UNLESS OTHERWISE INDICATED ALL PRESSURE AND/OR FLOW INSTRUMENT ROOF LINES SHALL BE 3/4" ROOF VALVES SHALL BE 3/4" ROOF. LIFT UP TO AND INCLUDING ROOF VALVE SHALL BE SUPPLIED AND INSTALLED UNDER CONTRACT B-89-4.
 2. PORTIONS OF ENCASED PIPING PROVIDED AND INSTALLED BY OTHERS AS SHOWN ON DRAWING 2102, 2106 & 2107.
 3. HIGH POINT VENTS AND LOW POINT DRAINS ARE NOT SHOWN.
 4. ALL VALVE NUMBERS IN PARENTHESES () ARE NUMBERS TO BE USED IN OPERATING PROCEDURES. THESE NUMBERS ARE ASSIGNED BY NPPD AND WILL NOT BE SHOWN ON PIPING DRAWINGS.
 5. ALL PIPING SHALL BE INSTALLED IN ACCORDANCE WITH THE SPECIFICATIONS FOR THE SYSTEM. THE SPECIFICATION DEFINES WORK FROM THE POINT.
 6. C-1 PRIMARY CONTAINMENT BOLDCAST.

ANSTEC APERTURE CARD

REVISIONS BY N.P.P.D.	
NO.	DESCRIPTION

FOR PREVIOUS REVISIONS SEE SUPERSEDED DWG.

BURNS AND ROE, INC.
 ENGINEERS AND ARCHITECTS
 NEW YORK, N.Y.

FLOW DIAGRAM
 REACTOR BUILDING
 DEMINERALIZED WATER SYSTEM


EDISON PUBLIC POWER DISTRICT
 COOPER HUBBARD STATION

454-003819
 AS BUILT

NO.	DATE	BY	DESCRIPTION	NO.	DATE	BY	DESCRIPTION
1							
2							
3							
4							
5							
6							
7							
8							
9							
10							

NOTES MARKED THIS WAY ARE "AS BUILT" ITEMS AND WILL NOT BE SHOWN ON PIPING DRAWINGS.

MAR. 31, 1995 NPPD

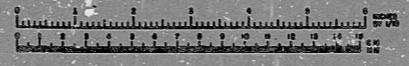

PDR

951204015L0

