

**INFORMATION ONLY**  
**NON-CONTROLLED P&ID**  
**JUL 18 1995**  
**NPPD DAS**

**454003637**


**AS BUILT**

**DURNS AND ROE, INC.**  
 ENGINEERS AND ARCHITECTS  
 1000 S. W. 10th Ave., Fort Lauderdale, FL 33304

**CONSUMERS PUBLIC POWER DISTRICT**  
 COOPER NUCLEAR STATION

**W. O. 1990**  
**DWG. 4000**

MAR. 31, 1995 NPPD

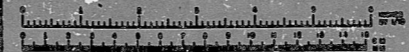

PDR

9512040193

