
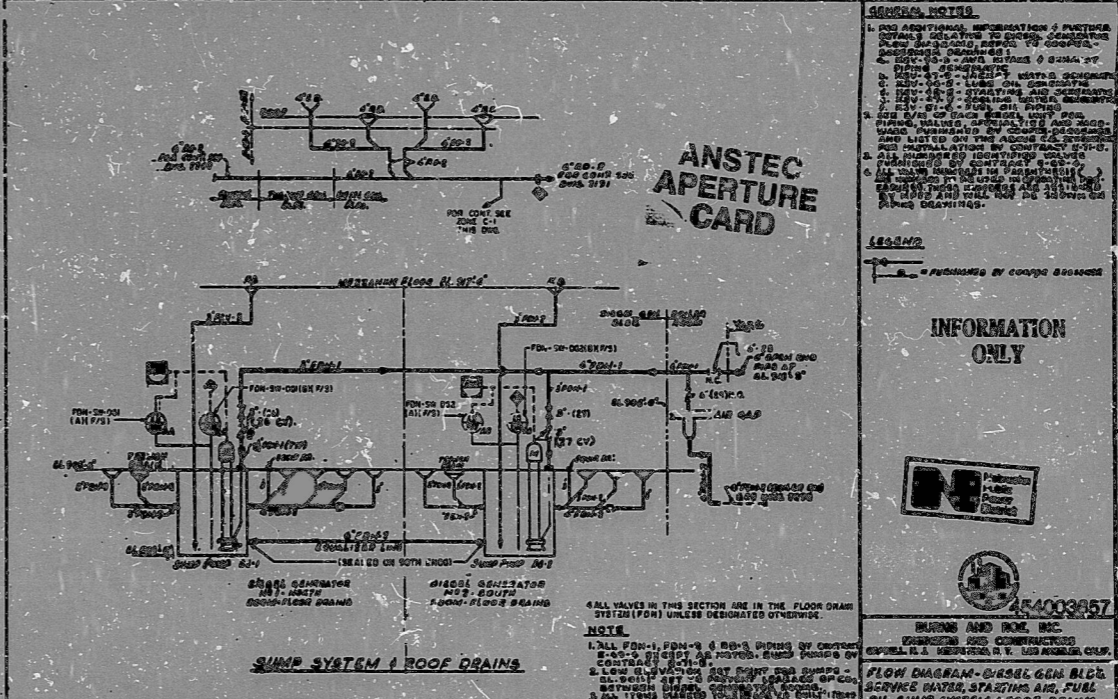



NON-CONTROLLED PRINT
 JUL 16 1995
 NPPD, RAS.

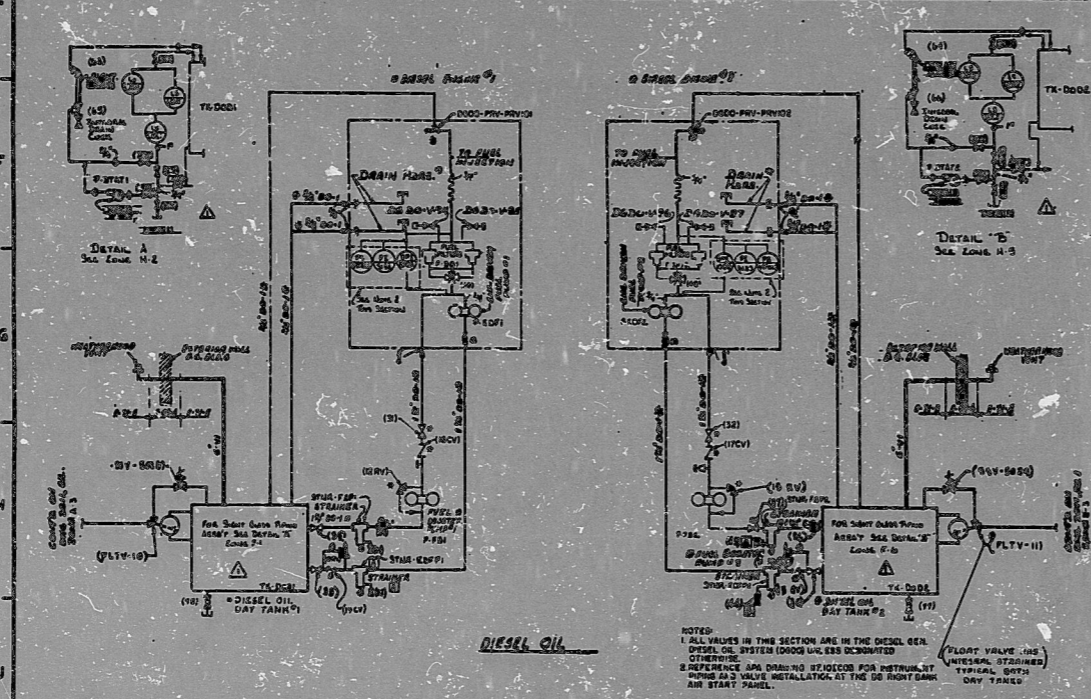

GENERAL NOTES:
 2. ALL VALVES IN THIS SECTION ARE IN THE DIESEL OIL SYSTEM UNLESS DESIGNATED OTHERWISE.

NO.	DATE	DESCRIPTION	BY	CHKD.
1	07/16/95	AS BUILT		

MAR. 3, 1995 NPPD

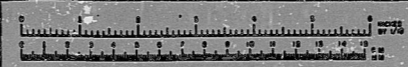

INFORMATION ONLY



W. O. 2820
 DWG. 107

PDR

9512 040200

