



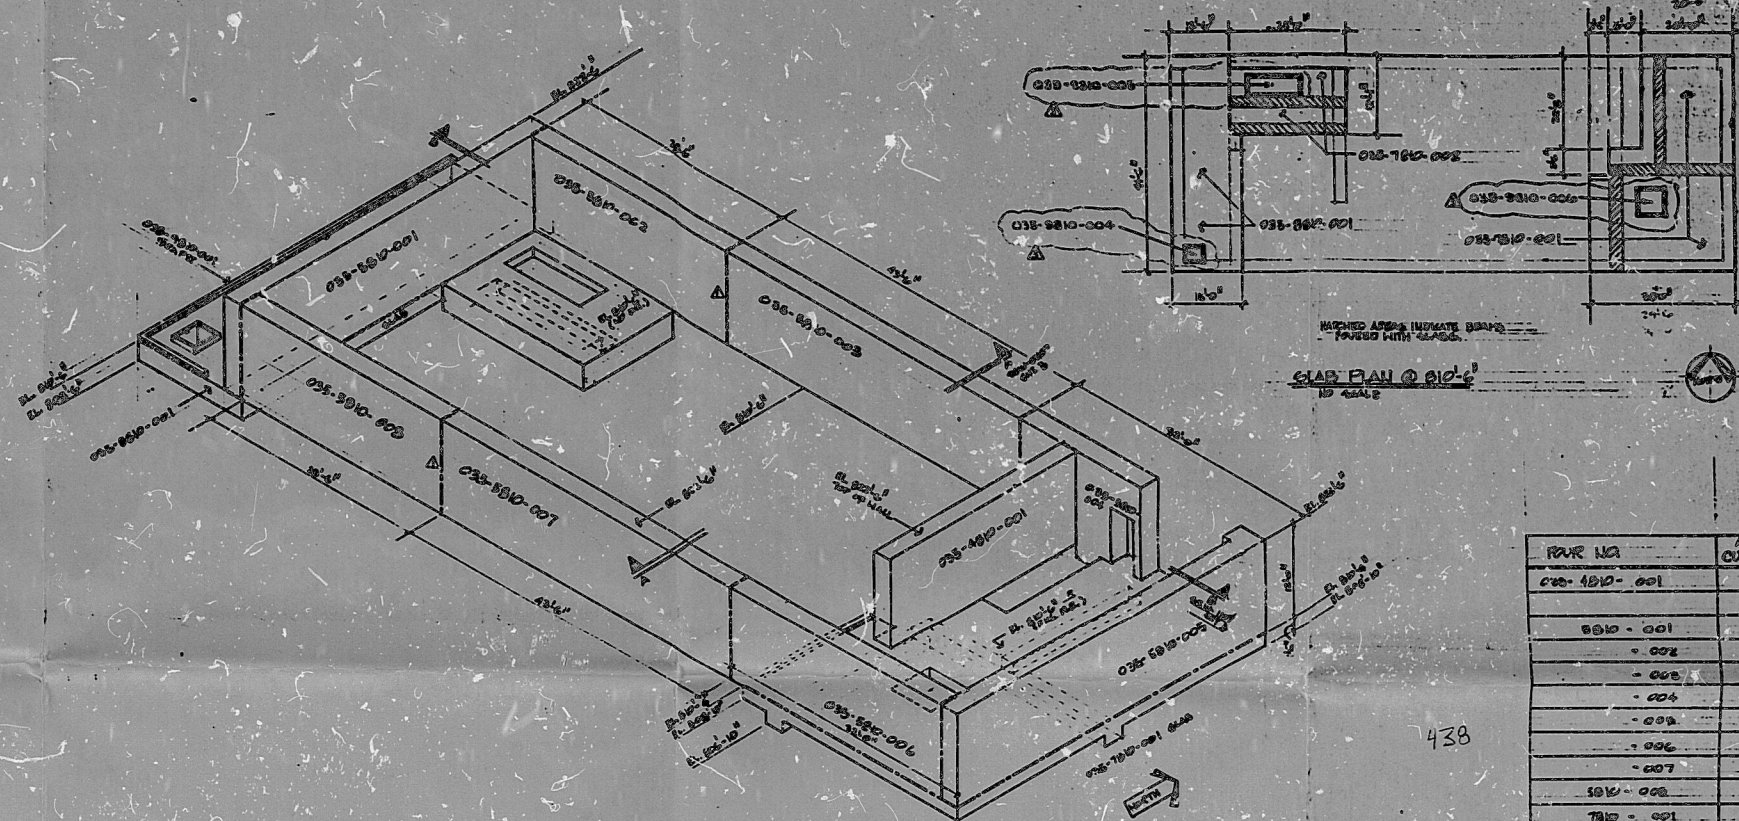


RAW NO.	APPROX. CU. YDS.

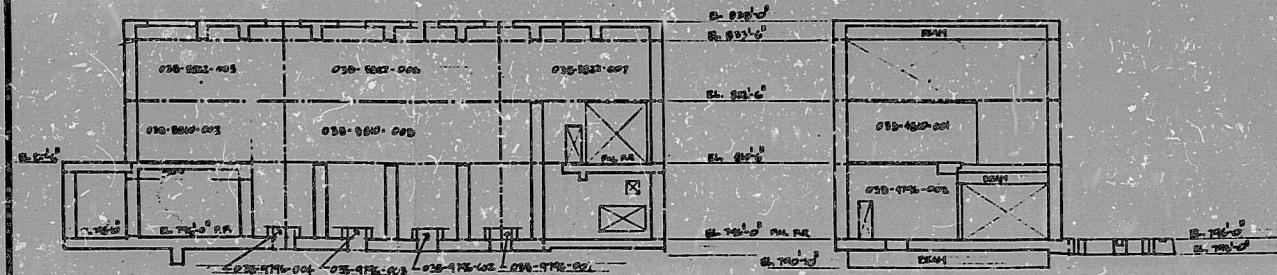

FOR OFFICE AND
ENGINEERING USE ONLY



REVISIONS 1. AS NOTED 2. AS NOTED 
---	--	---	--	--

8512030399
FOIA-85-59

C/438
ITI
APERTURE
CARD

PDR

8512030399

