


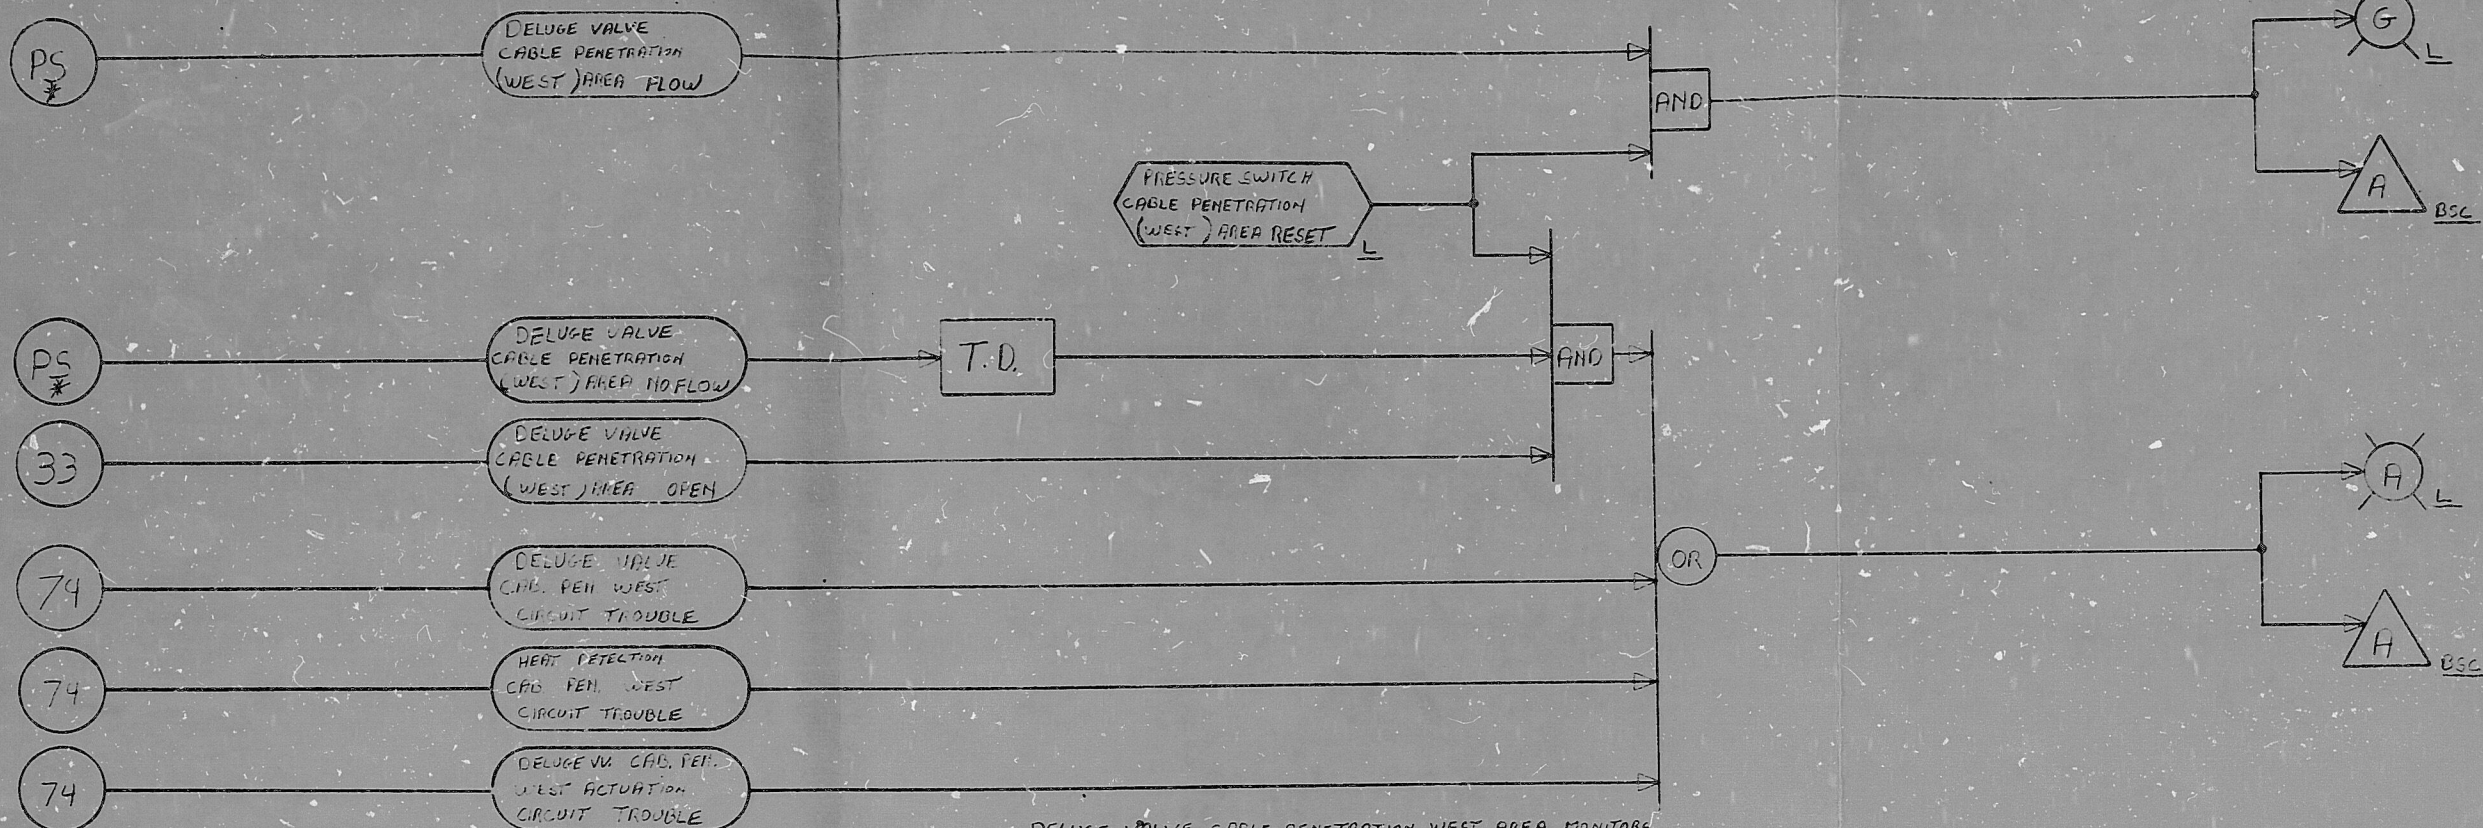

NOTES 1 * BY MANUFACTURER
 2. DELUGE VALVE CABLE PENETRATION WEST AREA MONITORS SHOWN
 DELUGE VALVE CABLE PENETRATION EAST AREA MONITORS IDENTICAL

DELUGE VALVE CABLE PENETRATION WEST AREA MONITORS

CONST AS-BUILT
 FOR DCP 268

ITEM 8A
 INTERIM ISSUE

TASK 12690.85 DATE 6-20-80
 RESPONSIBLE ENGINEER John H. H. H.

4A-2	ISS	CHD CORR APP'D	FOR CONST AS BUILT
------	-----	----------------	--------------------

OFF	12-80	REV	1
CO	203		
D.C.P.	DATE	Issued By D. L. Co.	

7	6	5	4	3	2	1
---	---	---	---	---	---	---

LOGIC DIAGRAM
 WATER FIRE PROTECTION SYSTEM - DELUGE
 BEAVER VALLEY POWER STATION UNIT-1
 DUQUENE LIGHT COMPANY
 STONE & WEBSTER ENGINEERING CORPORATION
 11700-LSK-20-E-4A-2

8701060043

PDR

8701060043

