


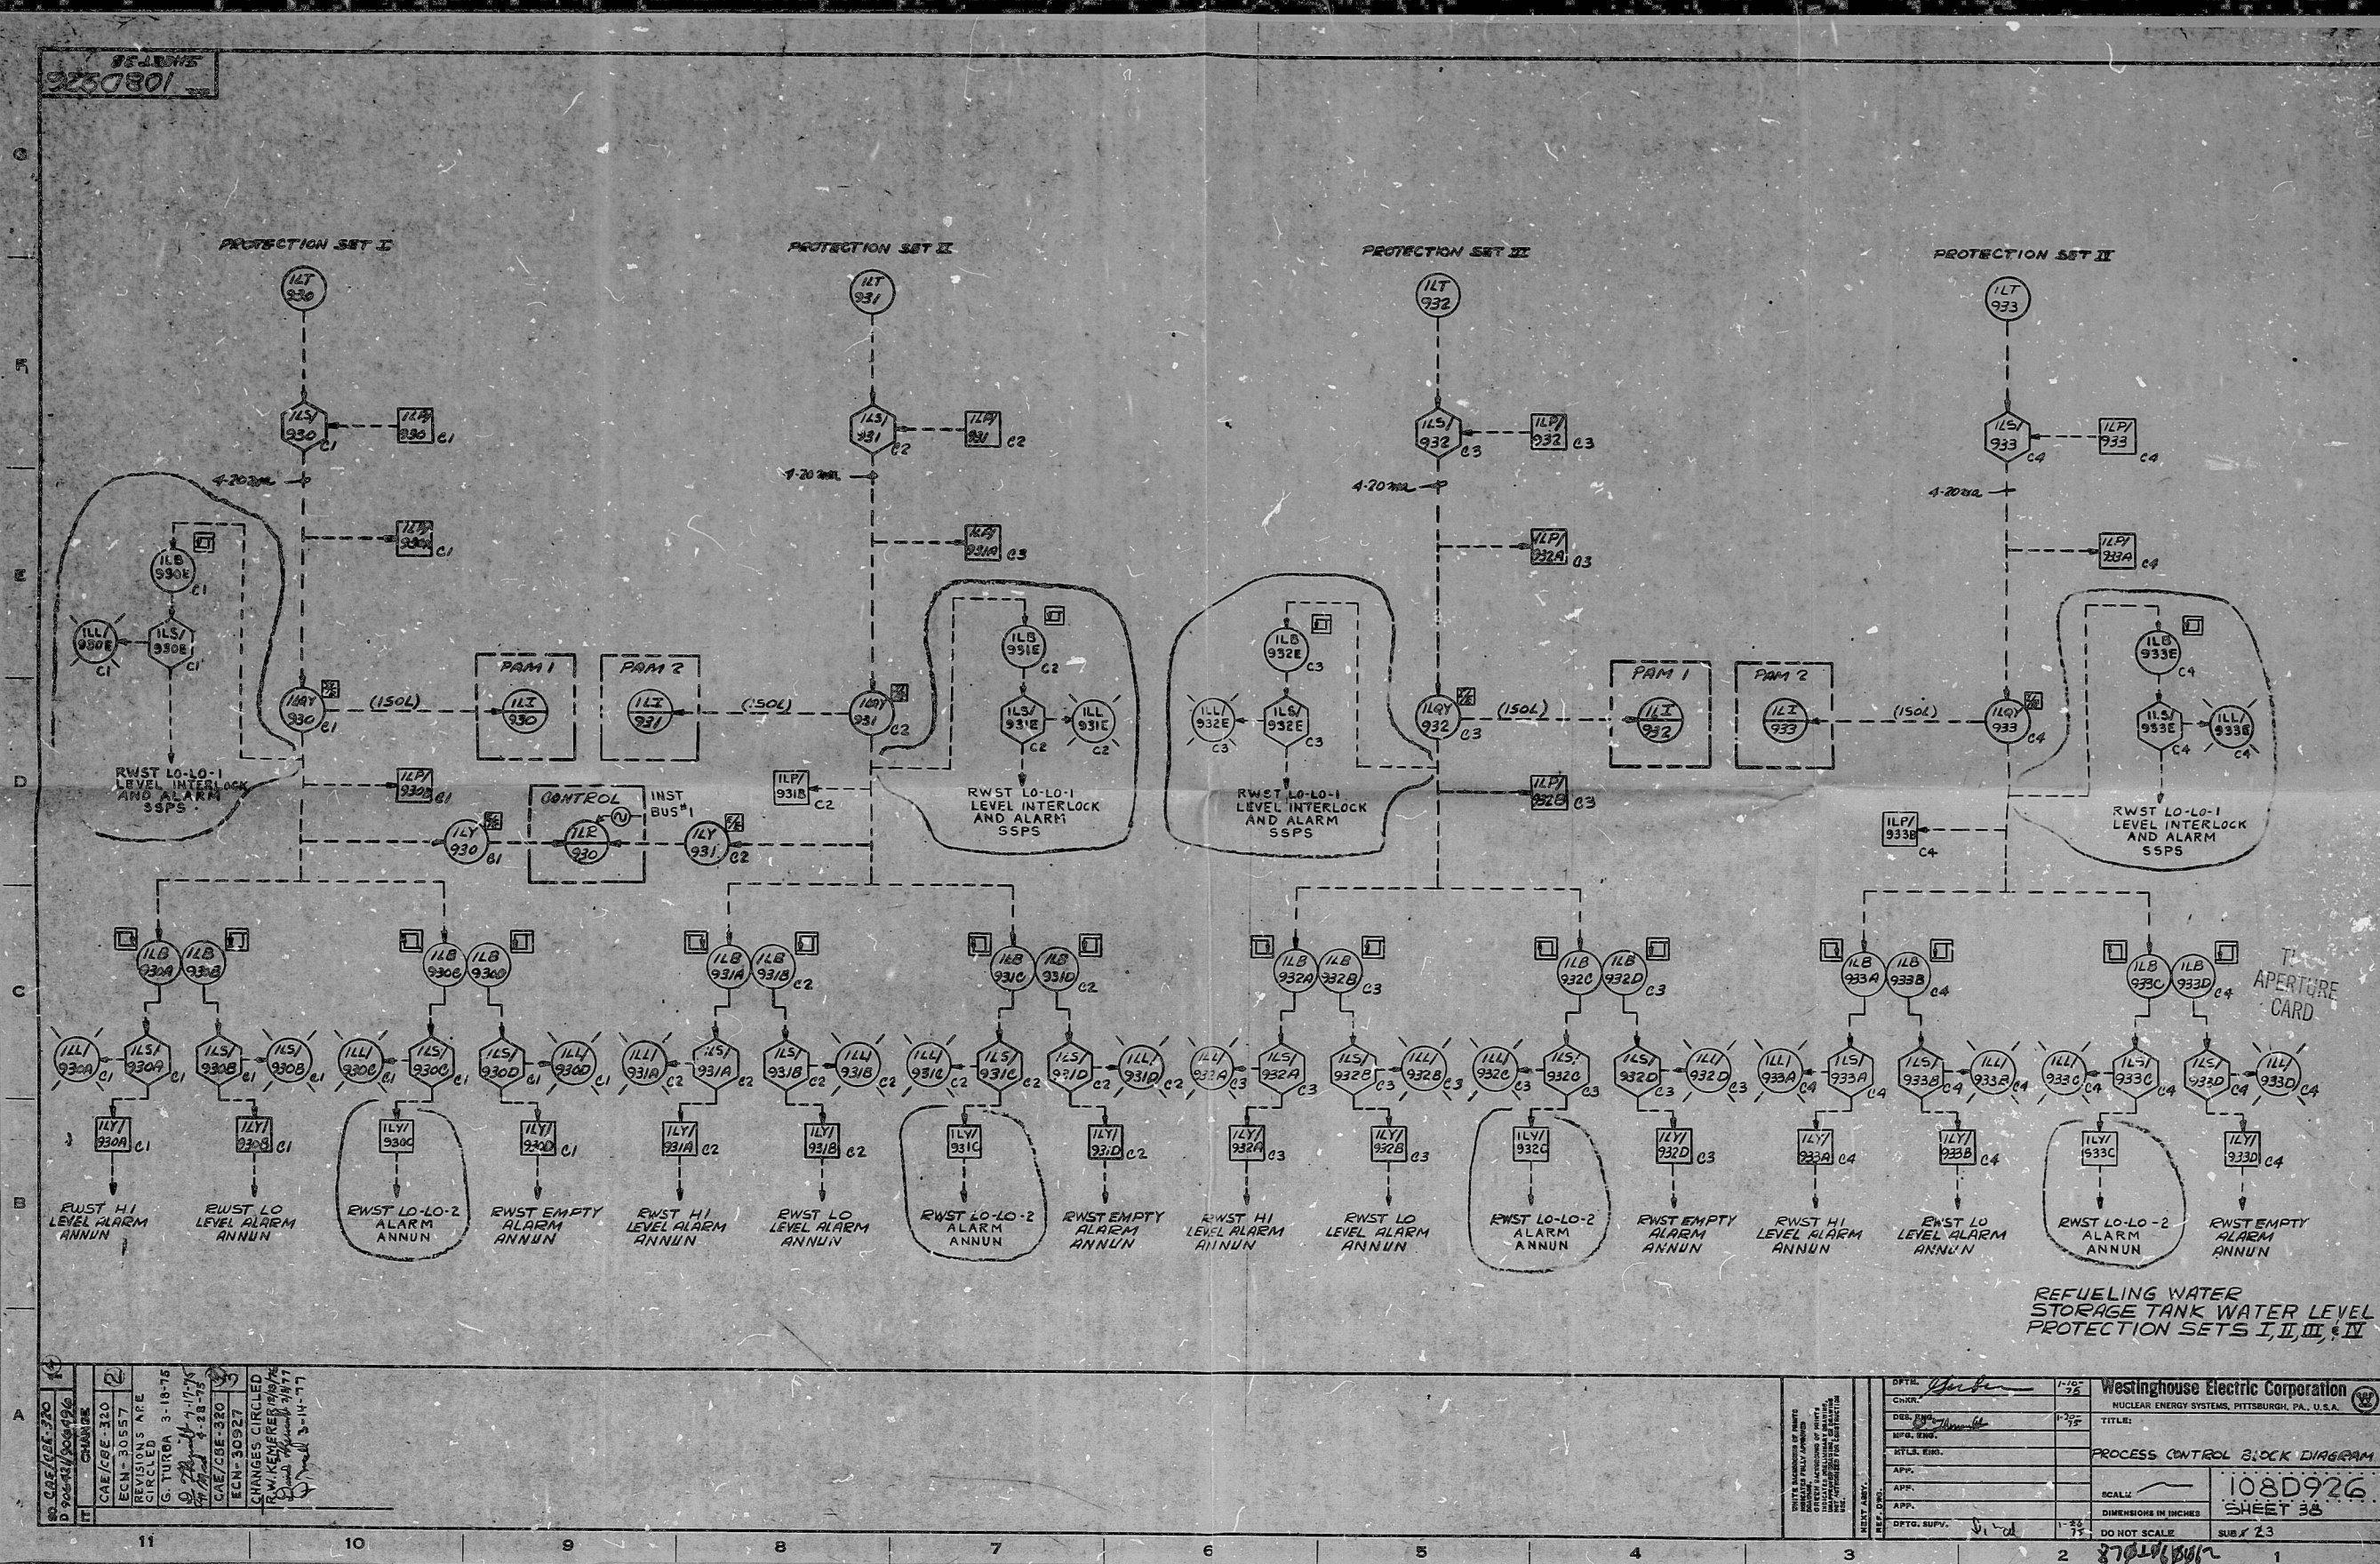



PDR

8701060062

