






PDR RIDS

8512040255

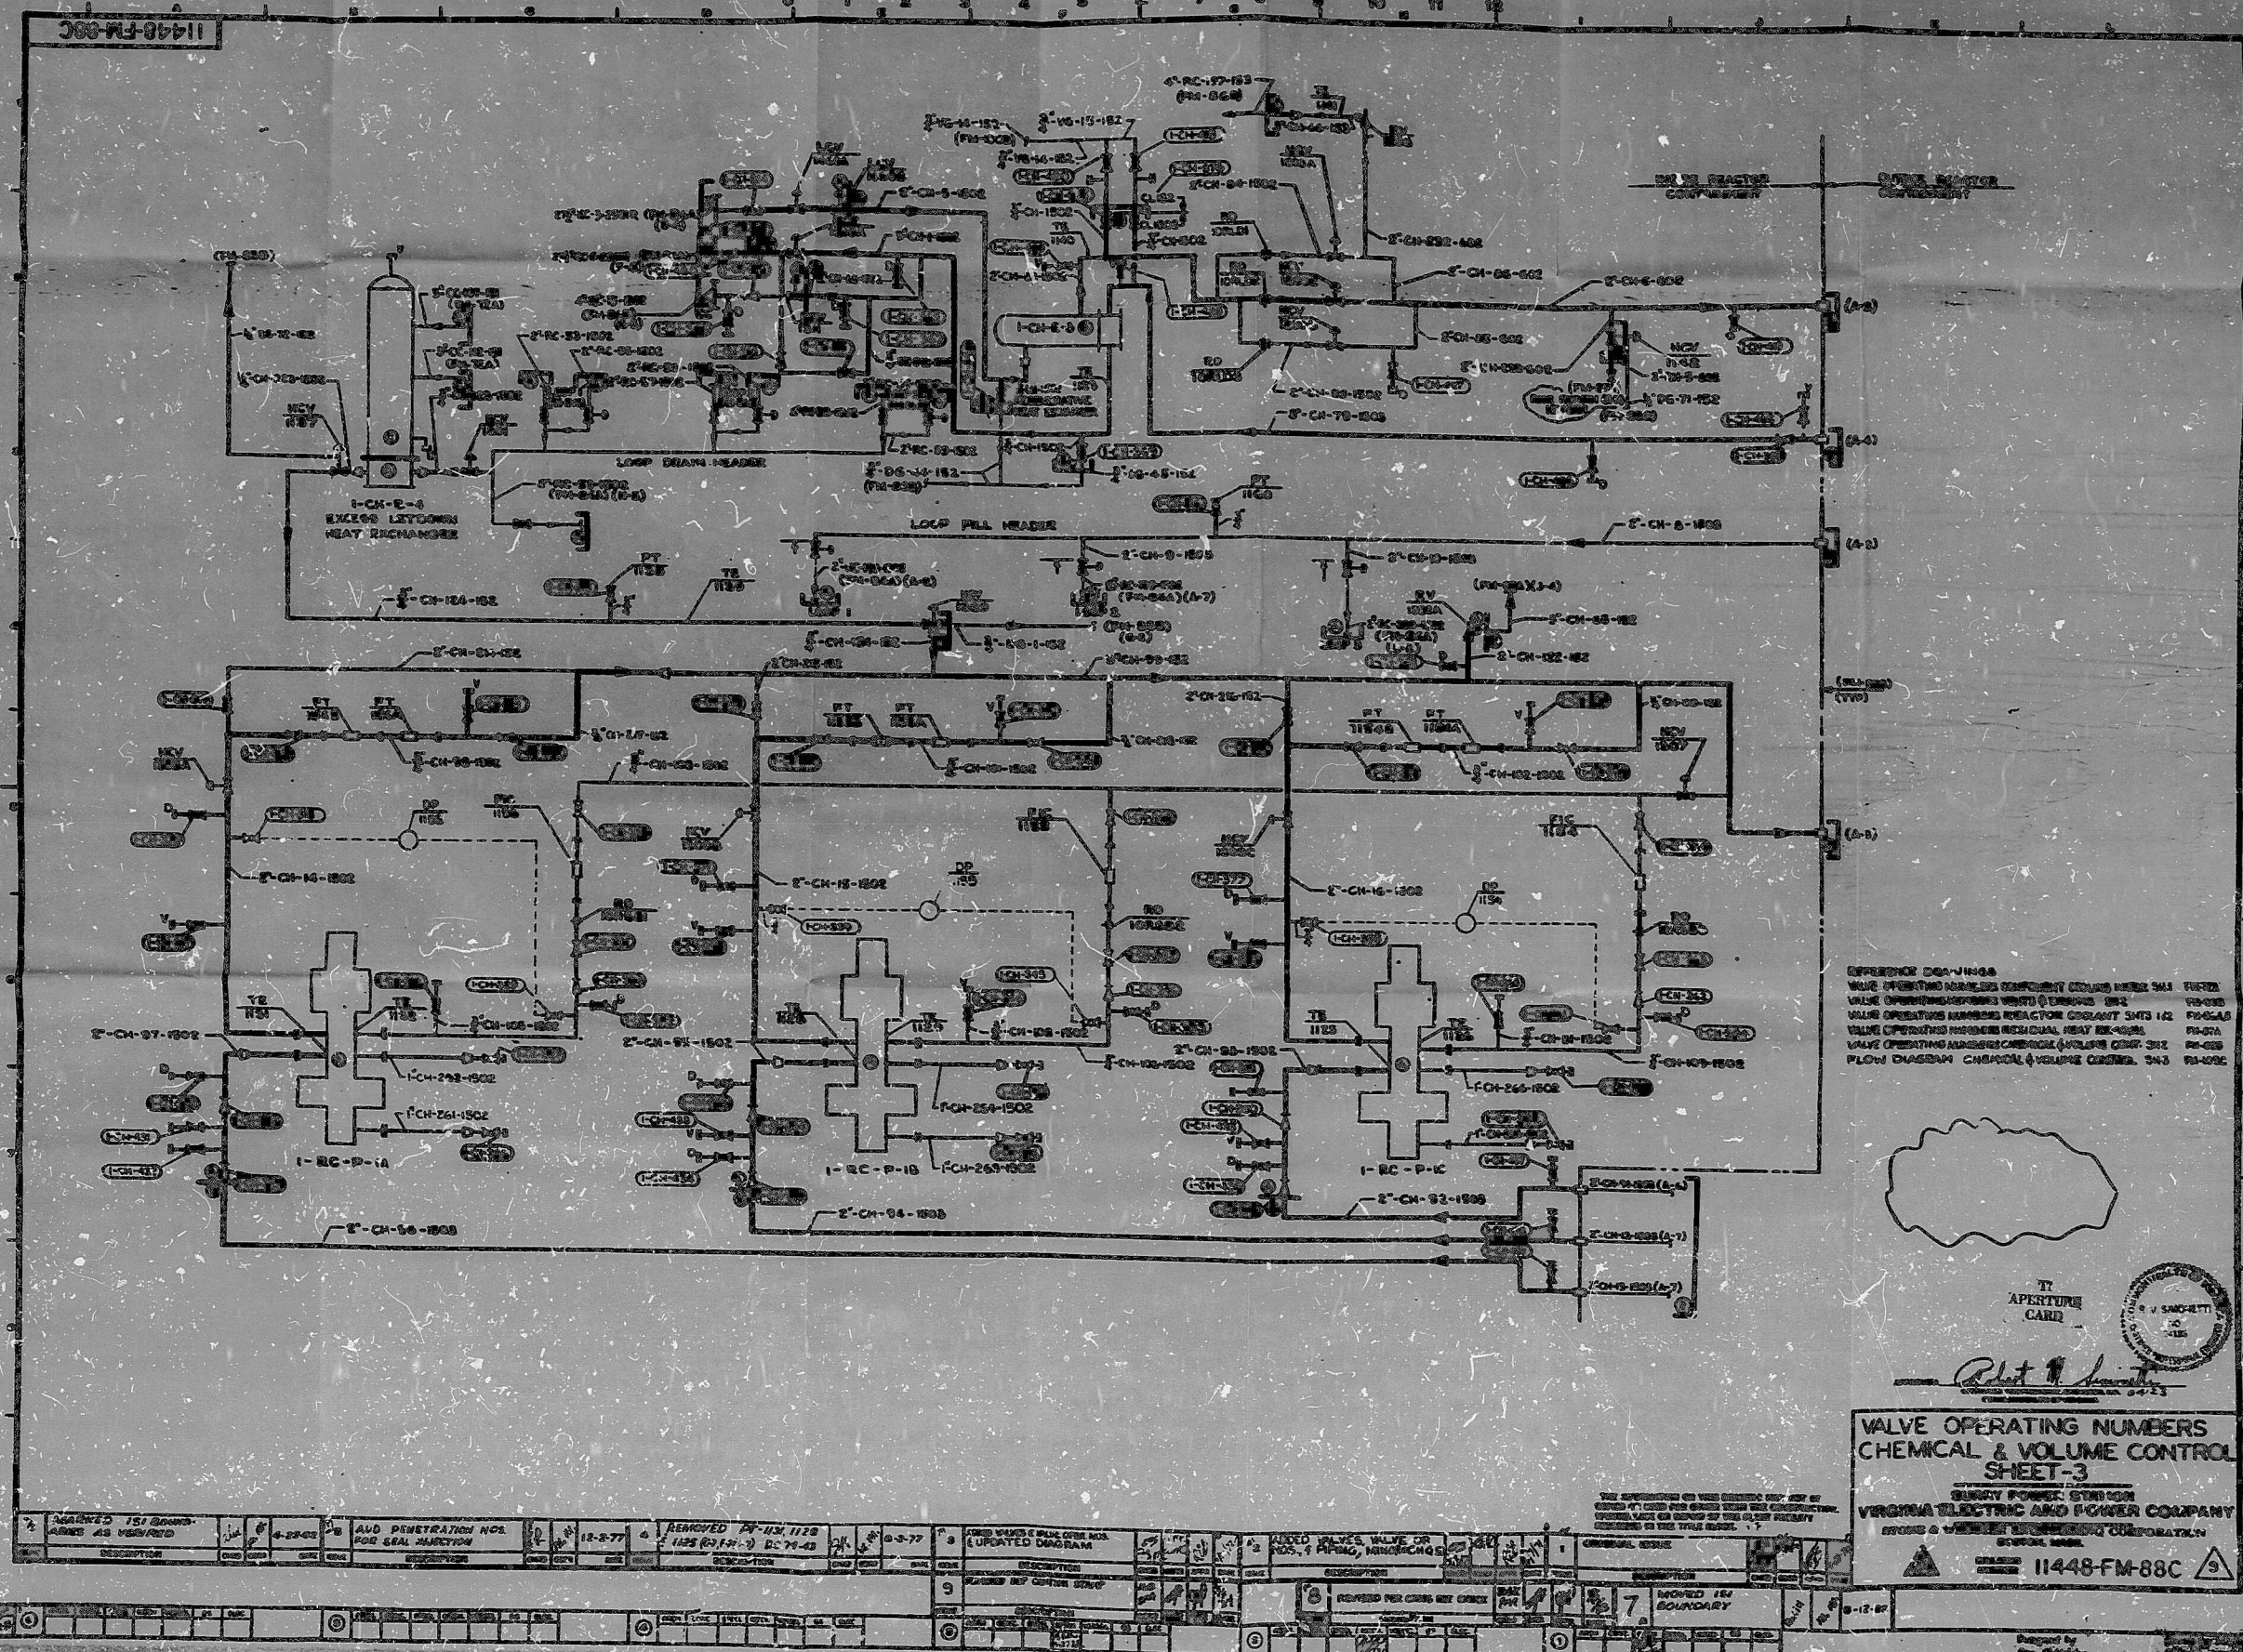