
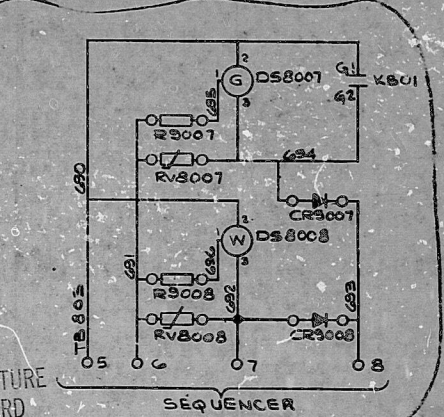
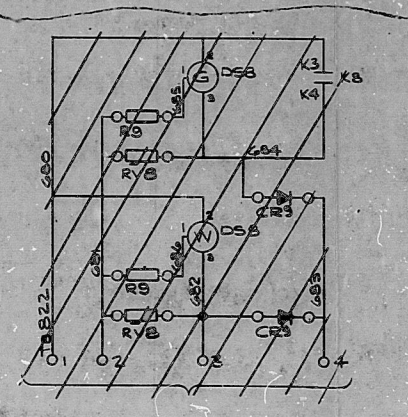
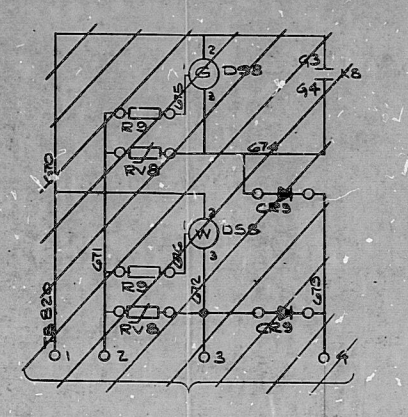
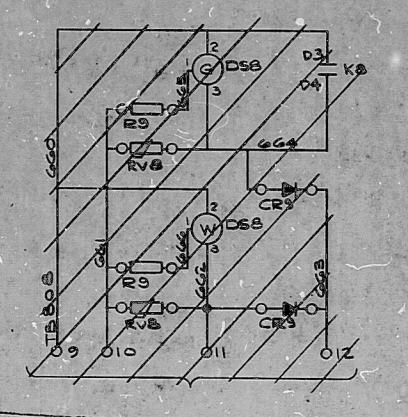
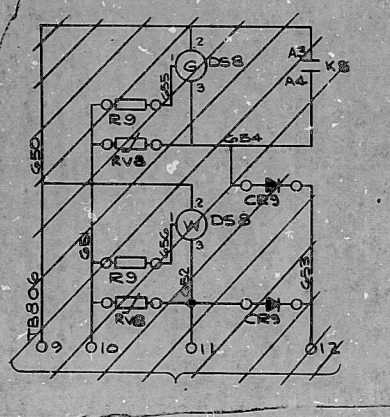
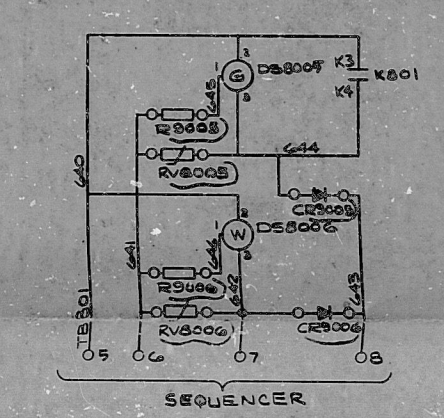
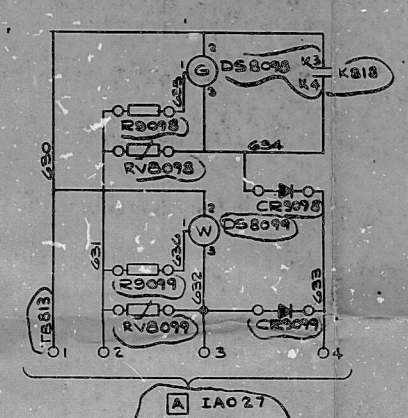
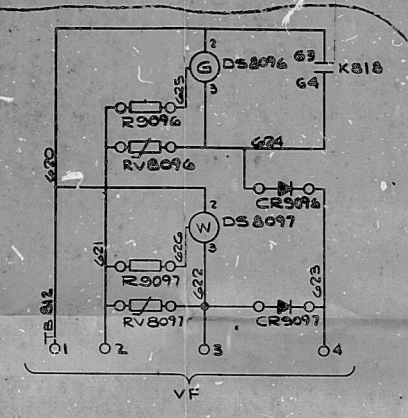
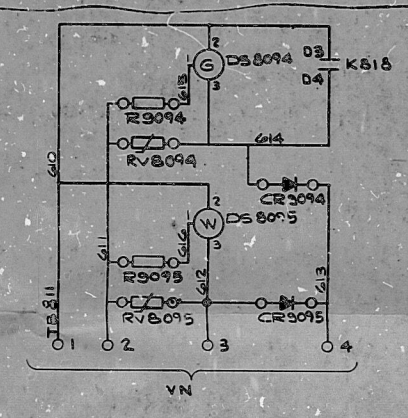
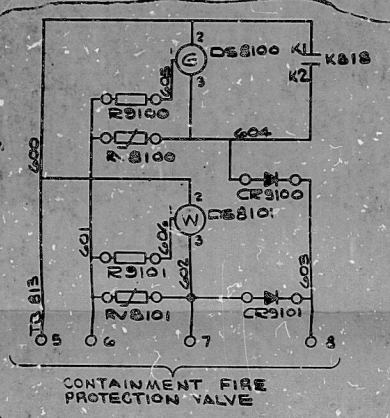
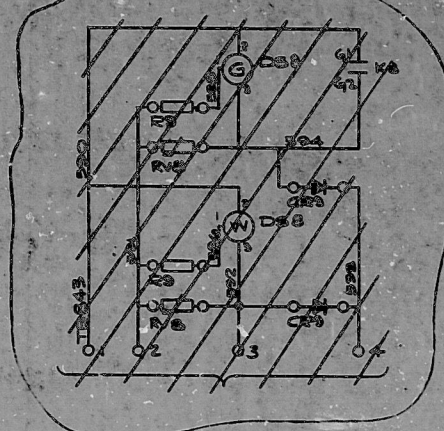
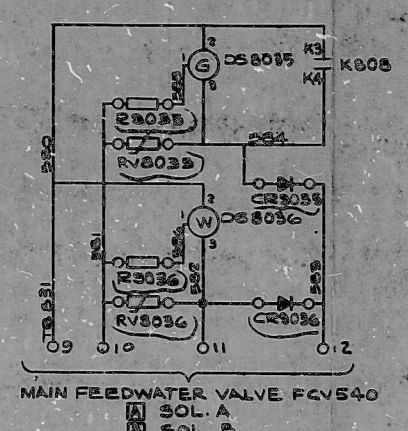
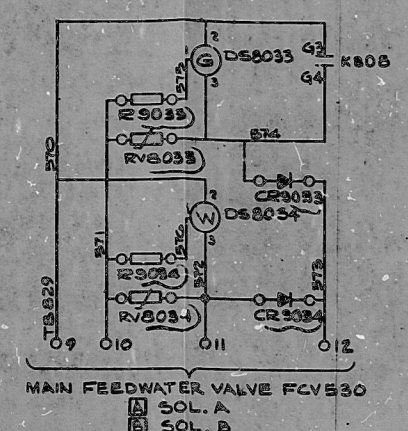
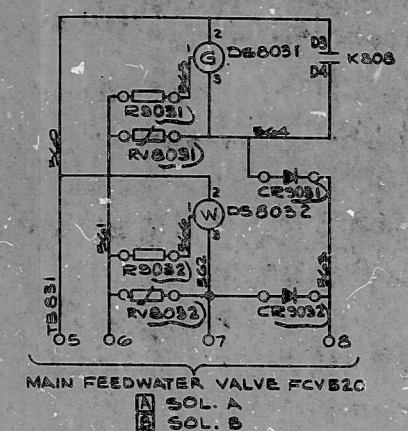


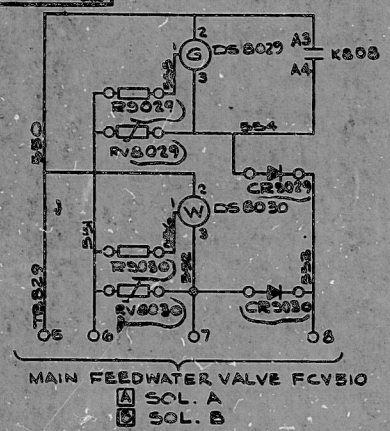

T!
APERTURE
CARD

NOTE:
ALL RESISTORS 3500 OHMS UNLESS OTHERWISE SPECIFIED.

SOCAE/-/CDE-306 9 906421/906496	IT CHANGE CAE/.../CDF-306 EGN-3089 REVISIONS CIRCLED 1-2-76 C.J. Redmond 9/27/76 P. Noel 9-30-76
------------------------------------	---

DC TEST CIRCUIT SCHEMATICS- FIGURE B	
DATE W. DEAN	3-3-75
CHECKED	Westinghouse Electric Corporation
FILE NO.	NUCLEAR ENERGY SYSTEMS, PITTSBURGH, PA., U.S.A.
BY T. WITTINGER	7-4-75
INSP. ENG.	TITLE:
TEST ENG.	SAFEGUARDS TEST CABINET
APP.	NTS
APP.	SCALE
APP.	DIMENSIONS IN INCHES
TEST. SUPV.	SHEET 8
3-3-75	DO NOT SCALE
2	270106008
1	1

PDR

8701060081

