


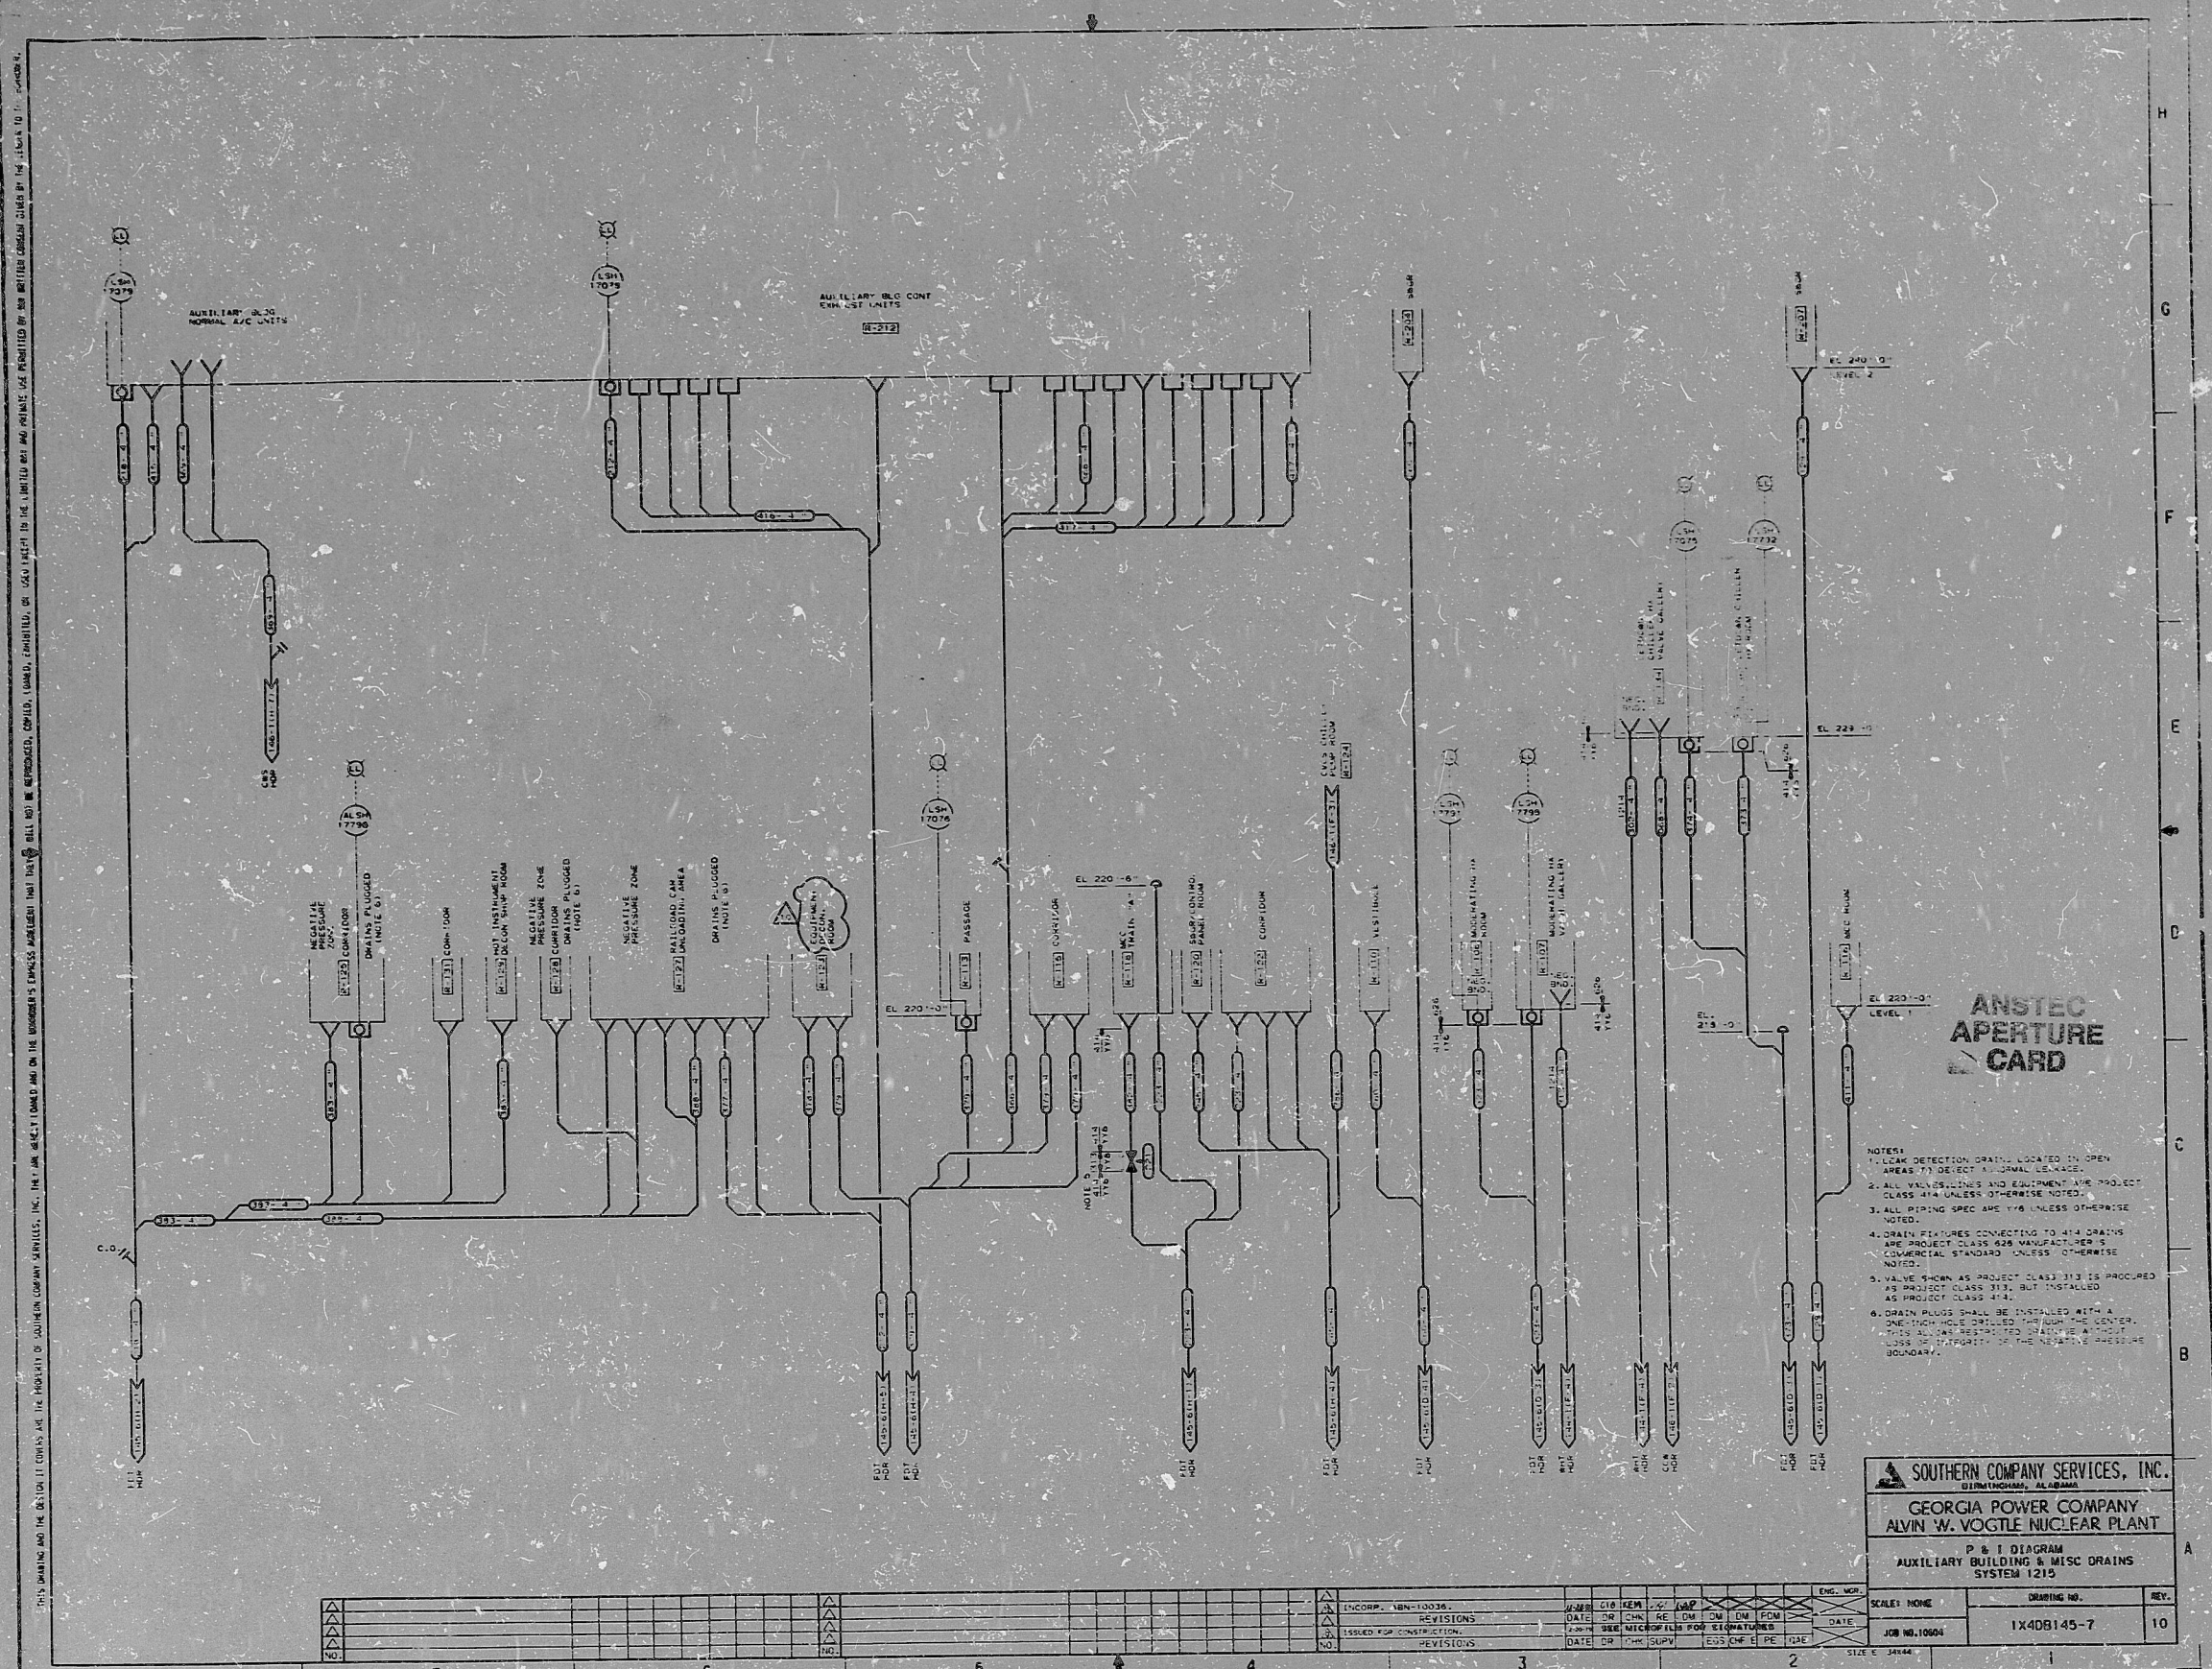

ANSTEC APERTURE CARD

NOTES:
 1. LEAK DETECTION DRAIN, LOCATED IN OPEN AREAS, TO DETECT ALL DRAIN LEAKAGE.
 2. ALL VALVES, LINES AND EQUIPMENT ARE PROJECT CLASS 414 UNLESS OTHERWISE NOTED.
 3. ALL PIPING SPEC ARE 1/8" UNLESS OTHERWISE NOTED.
 4. DRAIN FEATURES CONNECTING TO 414 DRAINS ARE PROJECT CLASS 428 MANUFACTURED TO COMMERCIAL STANDARD UNLESS OTHERWISE NOTED.
 5. VALVE SHOWN AS PROJECT CLASS 413 IS PROCURED AS PROJECT CLASS 414.

SOUTHERN COMPANY SERVICES, INC.
GEORGIA POWER COMPANY
ALVIN W. VOGTLE NUCLEAR PLANT
 P & I DIAGRAM
 AUXILIARY BUILDING & MISC DRAINS


SCALE: NONE
 JOB NO. 10004
 DRAWING NO. 1X408145-7
 REV. 10

PDR RIDS

9512180011

