


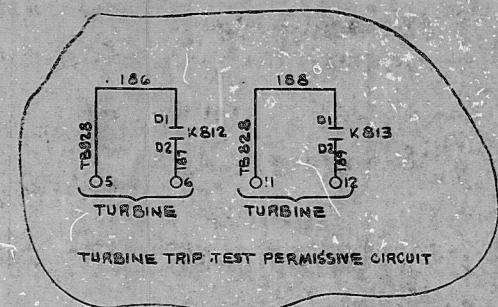

TI
APERTURE
CARD

AC/DC TEST CIRCUIT SCHEMATIC-FIGURE A

NOTE:
ALL 8000 SERIES RESISTORS ARE 2500 OHMS
ALL 9000 SERIES RESISTORS ARE 3500 OHMS

20 CAE / ... / CDE 386	CHANGES	2
290642 / 906496		1
CAE / CDE 386		2
ECN 30259		2
REVISIONS CIRCLED		
Revised 8/16/76		
C. Kalund 4/21/76		
Printed 9-30-76		
CAE / CDE 386		3
ECN 30290		
REVISIONS CIRCLED		
Revised 3/10/77		
C. Kalund 3/11/77		
Printed 4/13/77		

BTTL	W DEAN	1-31-73	Westinghouse Electric Corporation		
CHRG.			NUCLEAR ENERGY SYSTEMS, PITTSBURGH, PA., U.S.A.		
DEPT. ENG.	J. T. SUTTINGER		TITLE		
INSTR. DESIG.	4-14-73				
BTTL. NGR.					
APP.	SAFEGUARDS TEST CABINET				
APP.	NTS				
APP.	SCALE				
APP.	8756D87				
APP.	DIMENSIONS IN INCHES				
APP.	DO NOT SCALE				
APP.	SHEET 6				
APP.	SUB. # 3				

2 8701060095

PDR

8701060095

