


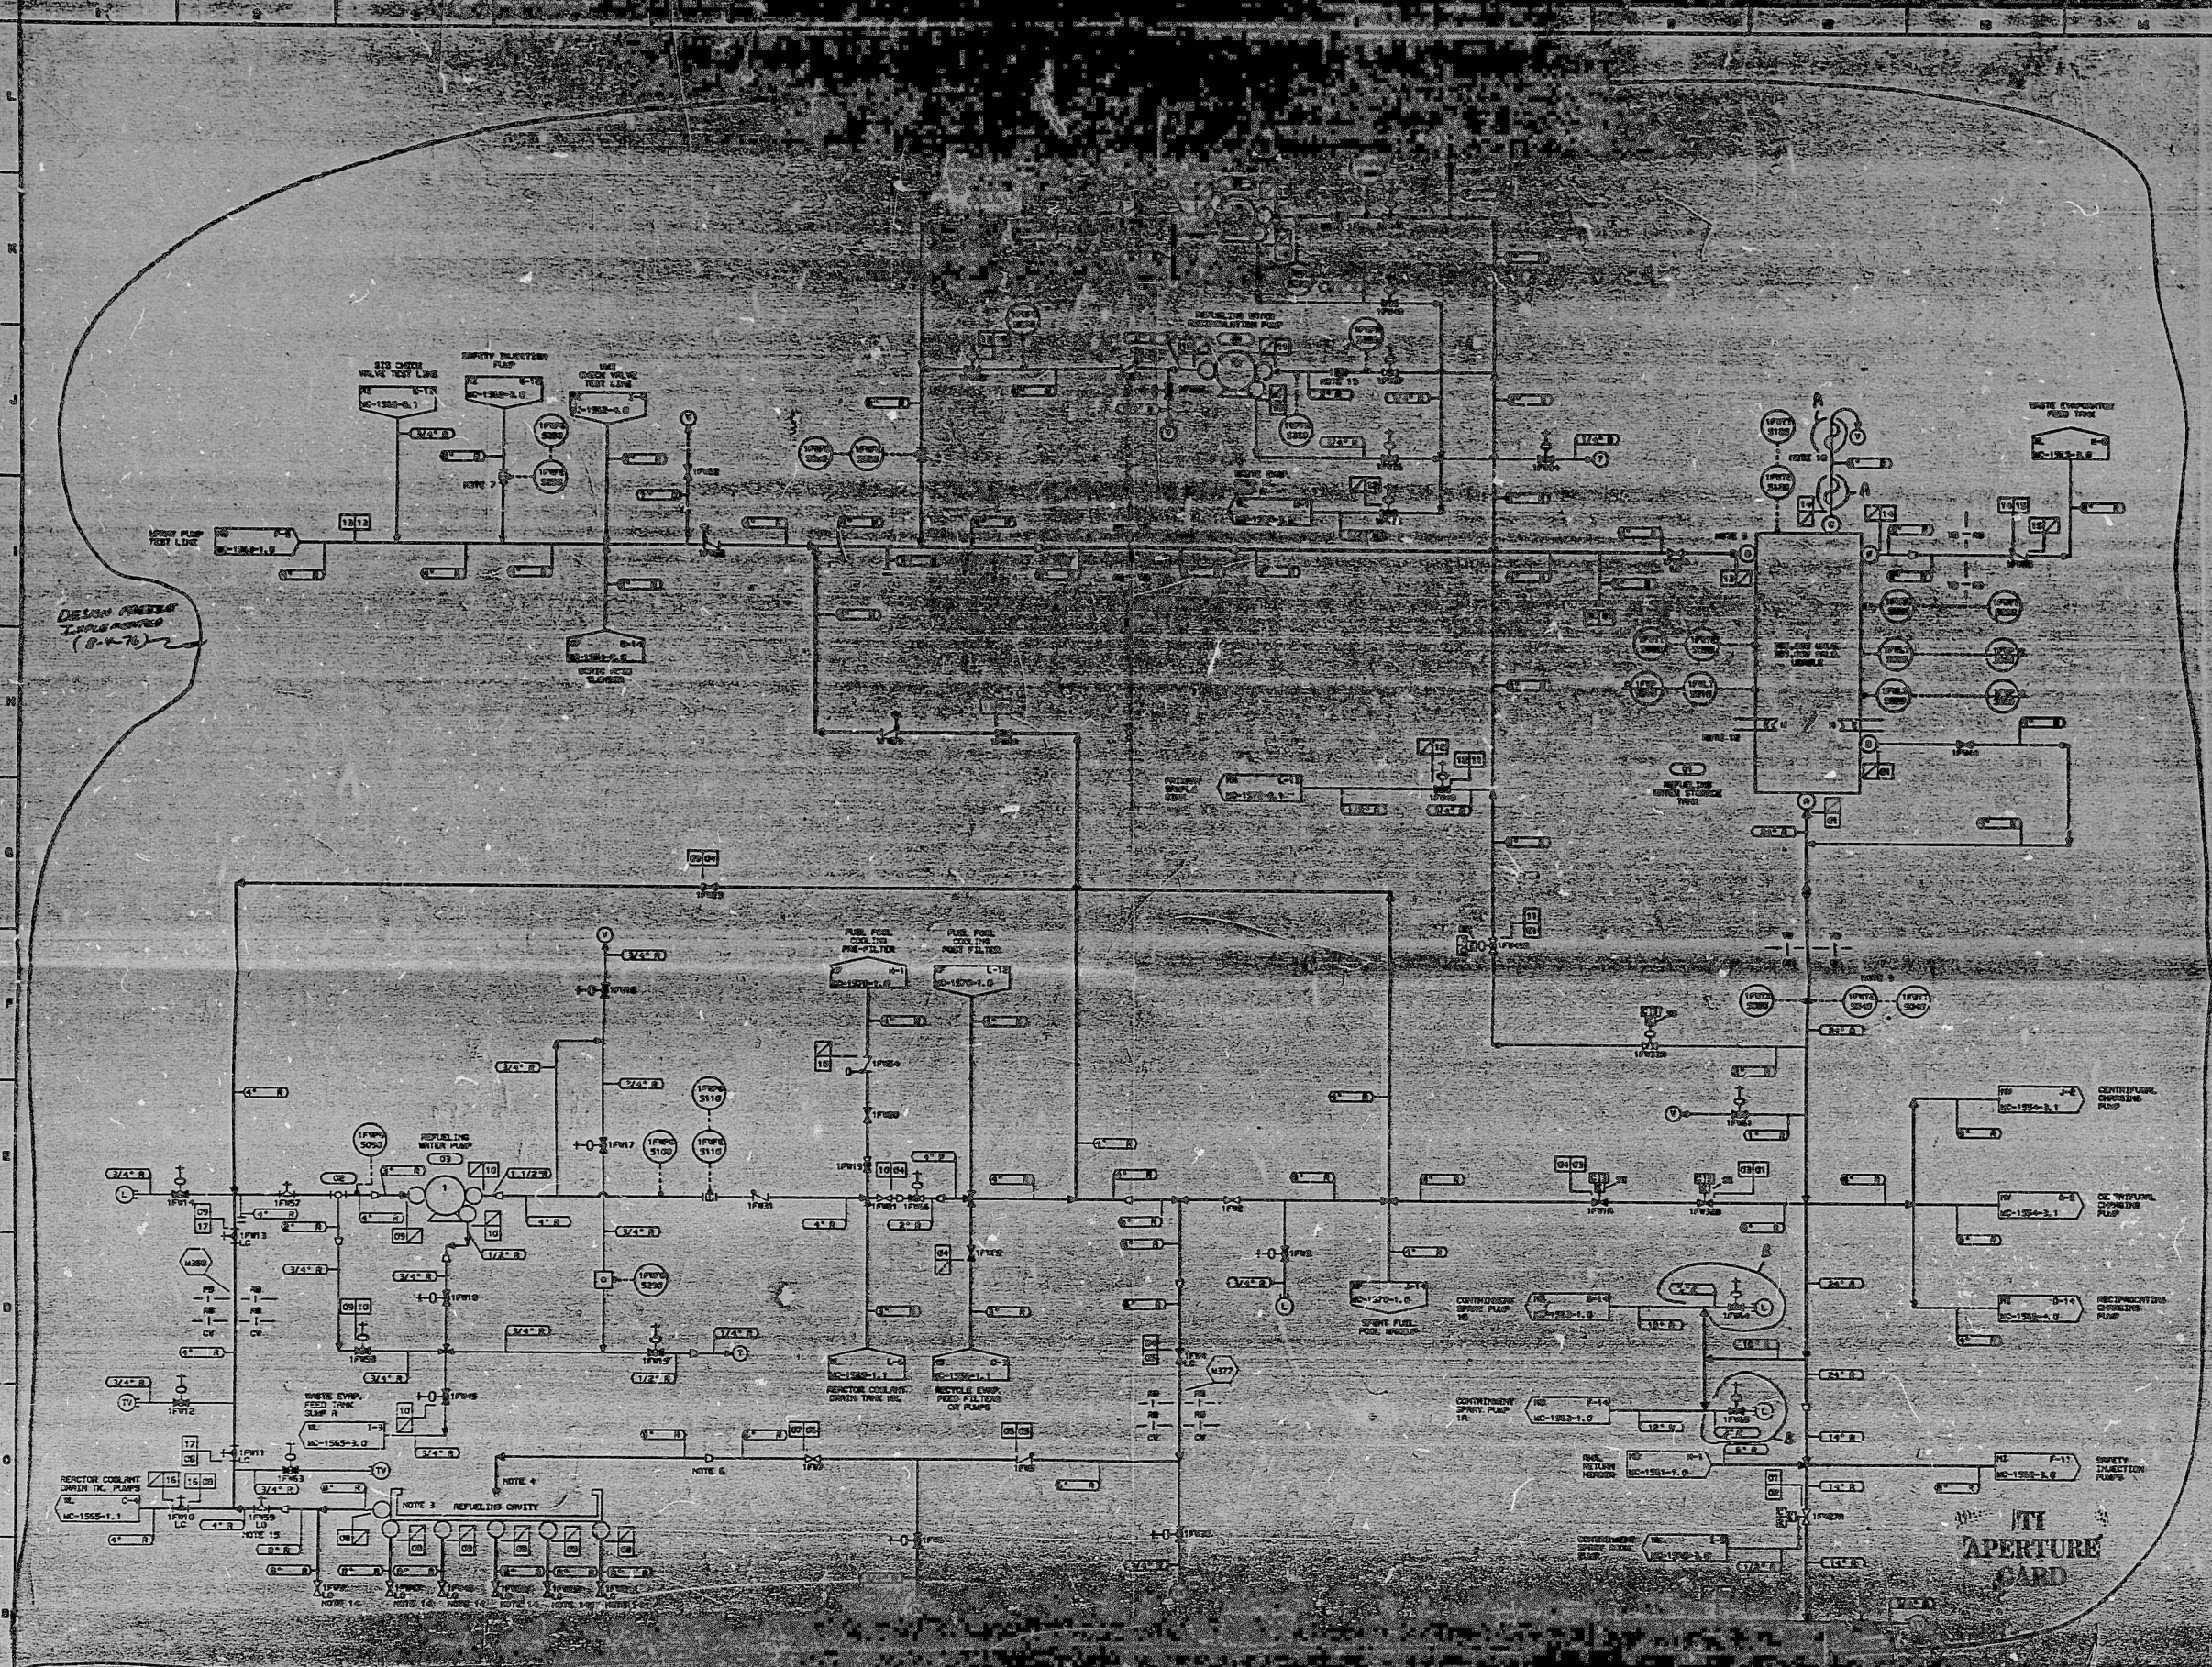

NOTES:


APERTURE CARD

SYSTEM CHANGE ORDER NUMBER	

870206090

PDR

8701060302

