
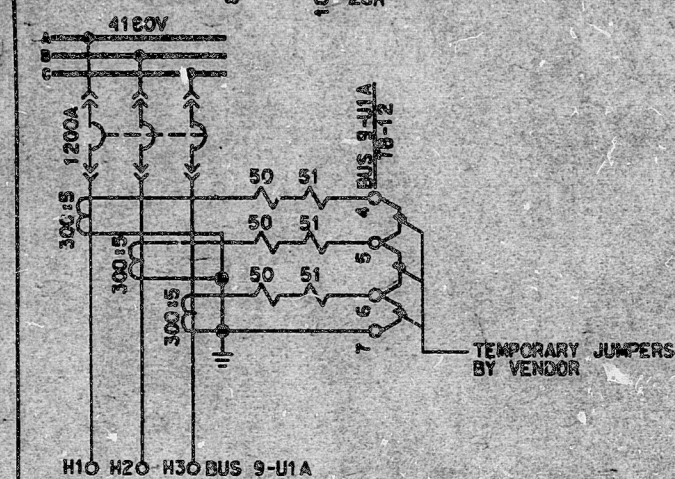


This drawing and the design it covers are the property of BECHTEL. They are hereby loaned and on the borrower's express agreement that they will not be reproduced, copied, loaned, exhibited, or used except in the limited way and private use permitted by the lender to the borrower.

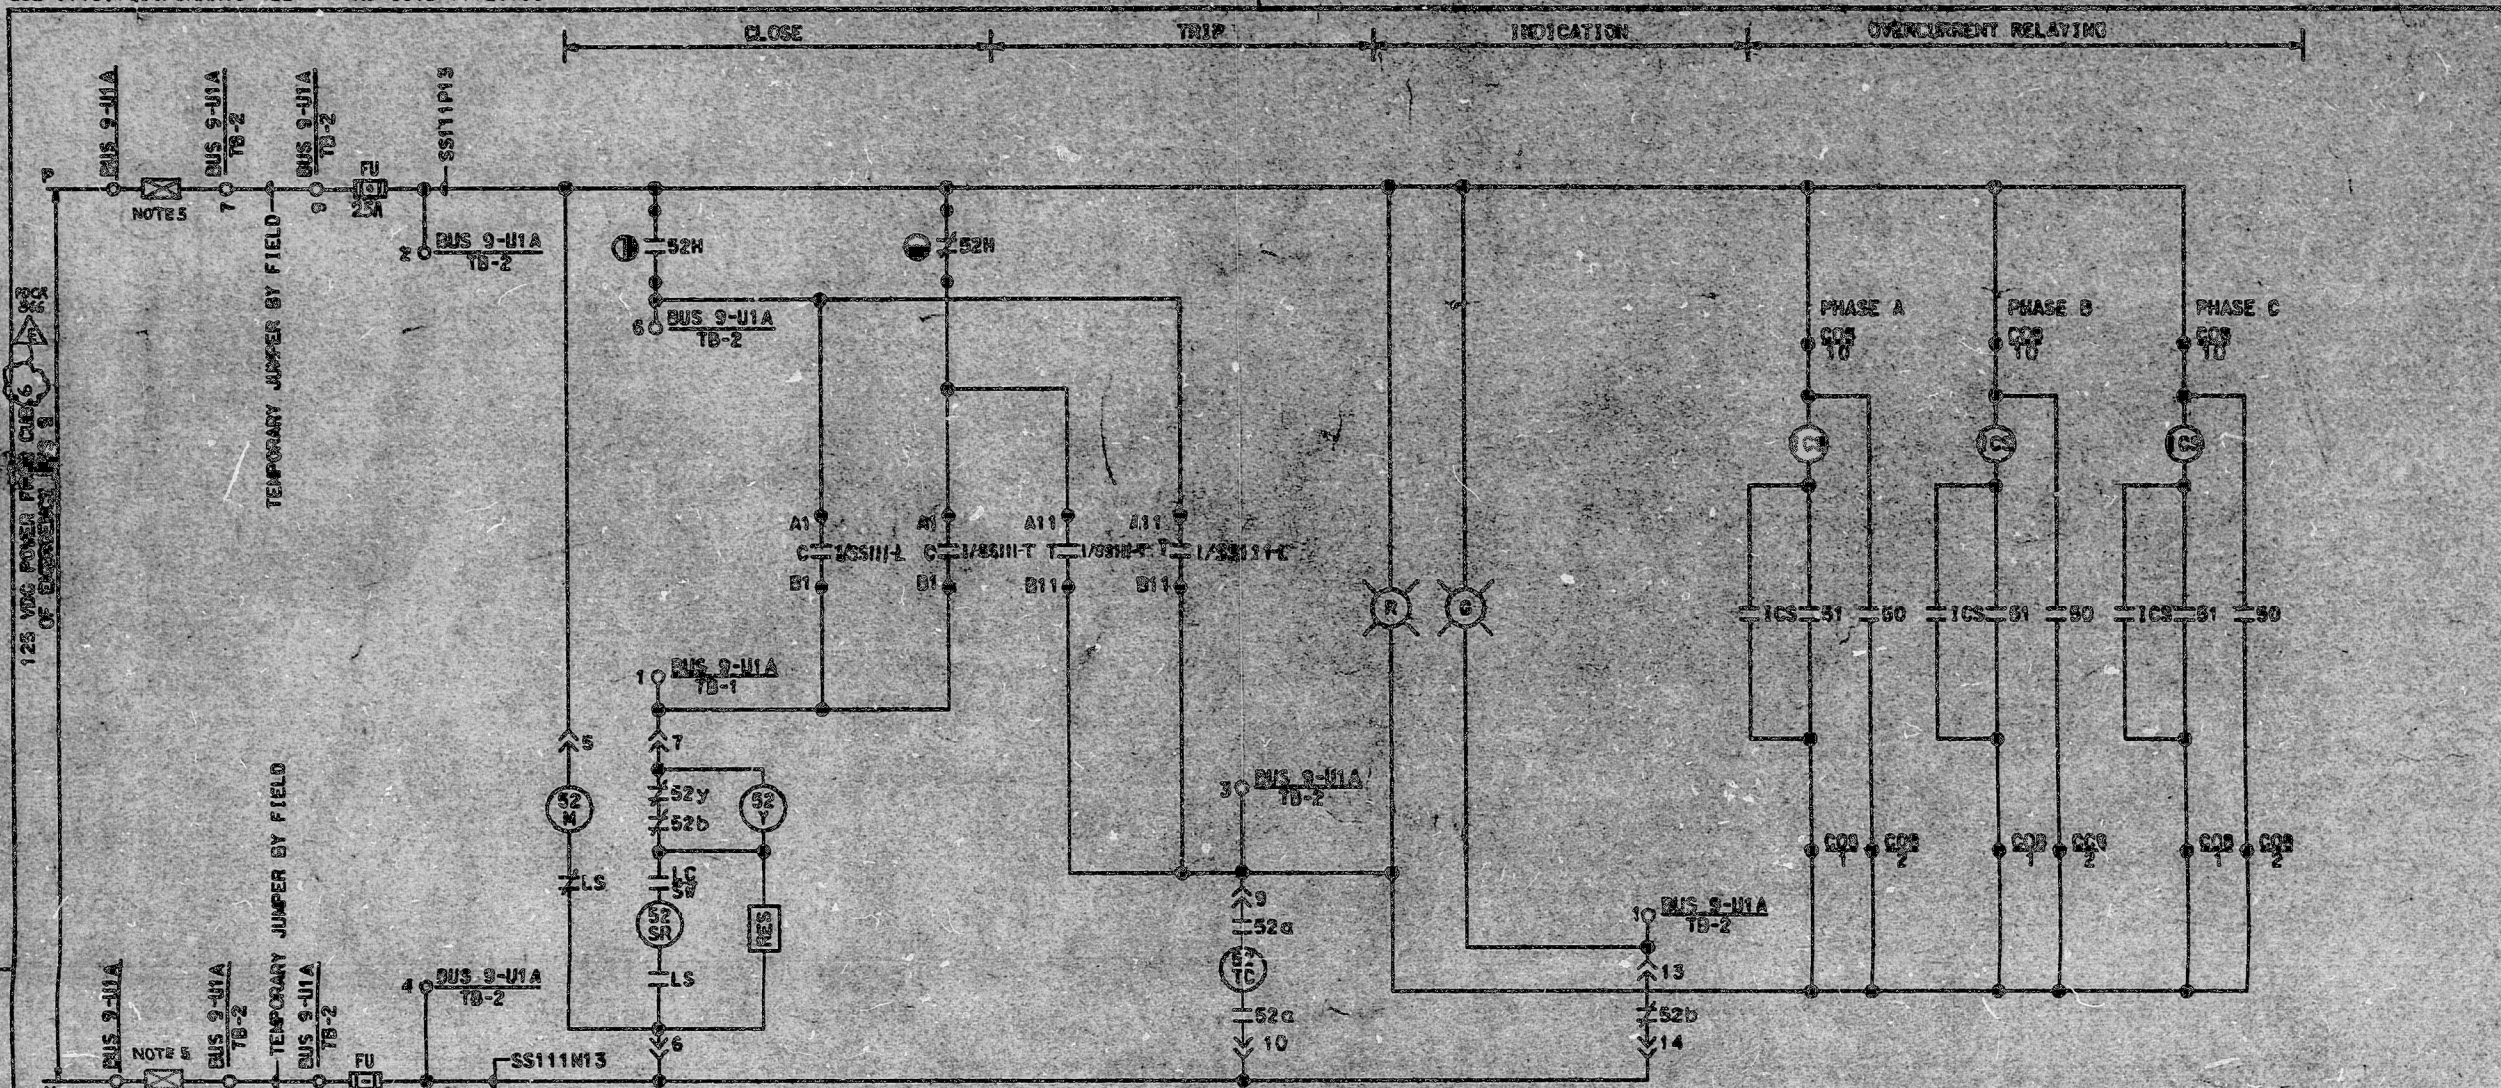

LEGEND:

- CELL SWITCH CLOSED WHEN A.C.B. IS IN TEST POSITION ONLY
- CELL SWITCH CLOSED WHEN A.C.B. IS IN OPERATING POSITION ONLY

- 5. PULL OUT DUMMY FUSE USED AS CIRCUIT DISCONNECT SWITCH.
- 6. THIS DRAWING WILL BE VOIDED AND WILL BE SUPERSEDED BY DRAWING 83117-32001, 1M-500 WHEN POCA 502 IS IMPLEMENTED.

NOTES:

- THIS DRAWING SHOWS THE CHANGES OF POCA No. 866 (PA No. 83-117). IT SHOULD BE USED IN CONJUNCTION WITH POCA No. 866 ONLY.
- THIS DRAWING CONTAINS MODIFICATIONS REQUIRED TO MEET FIRE PROTECTION CRITERIA OF APPENDIX R TO 10 CFR 40.
- BREAKER IS SHOWN IN OPEN POSITION.
- FOR SWITCH DEVELOPMENT 1/SS111H-B, 3/SS111V-SEE DWG 83117-32001 SH.500X.

THIS DRAWING IS NUCLEAR SAFETY RELATED
WORK THIS DWG WITH 83117-32001 SH.500X.

E.	N/A	F.A.S.	N/A	N/A


83117	
D. 11/20/86	ADDED NOTE G FOR POCA 502

872290399

PDR RIDS

