


IX3DG041

OX

10/10/68

10/10/68

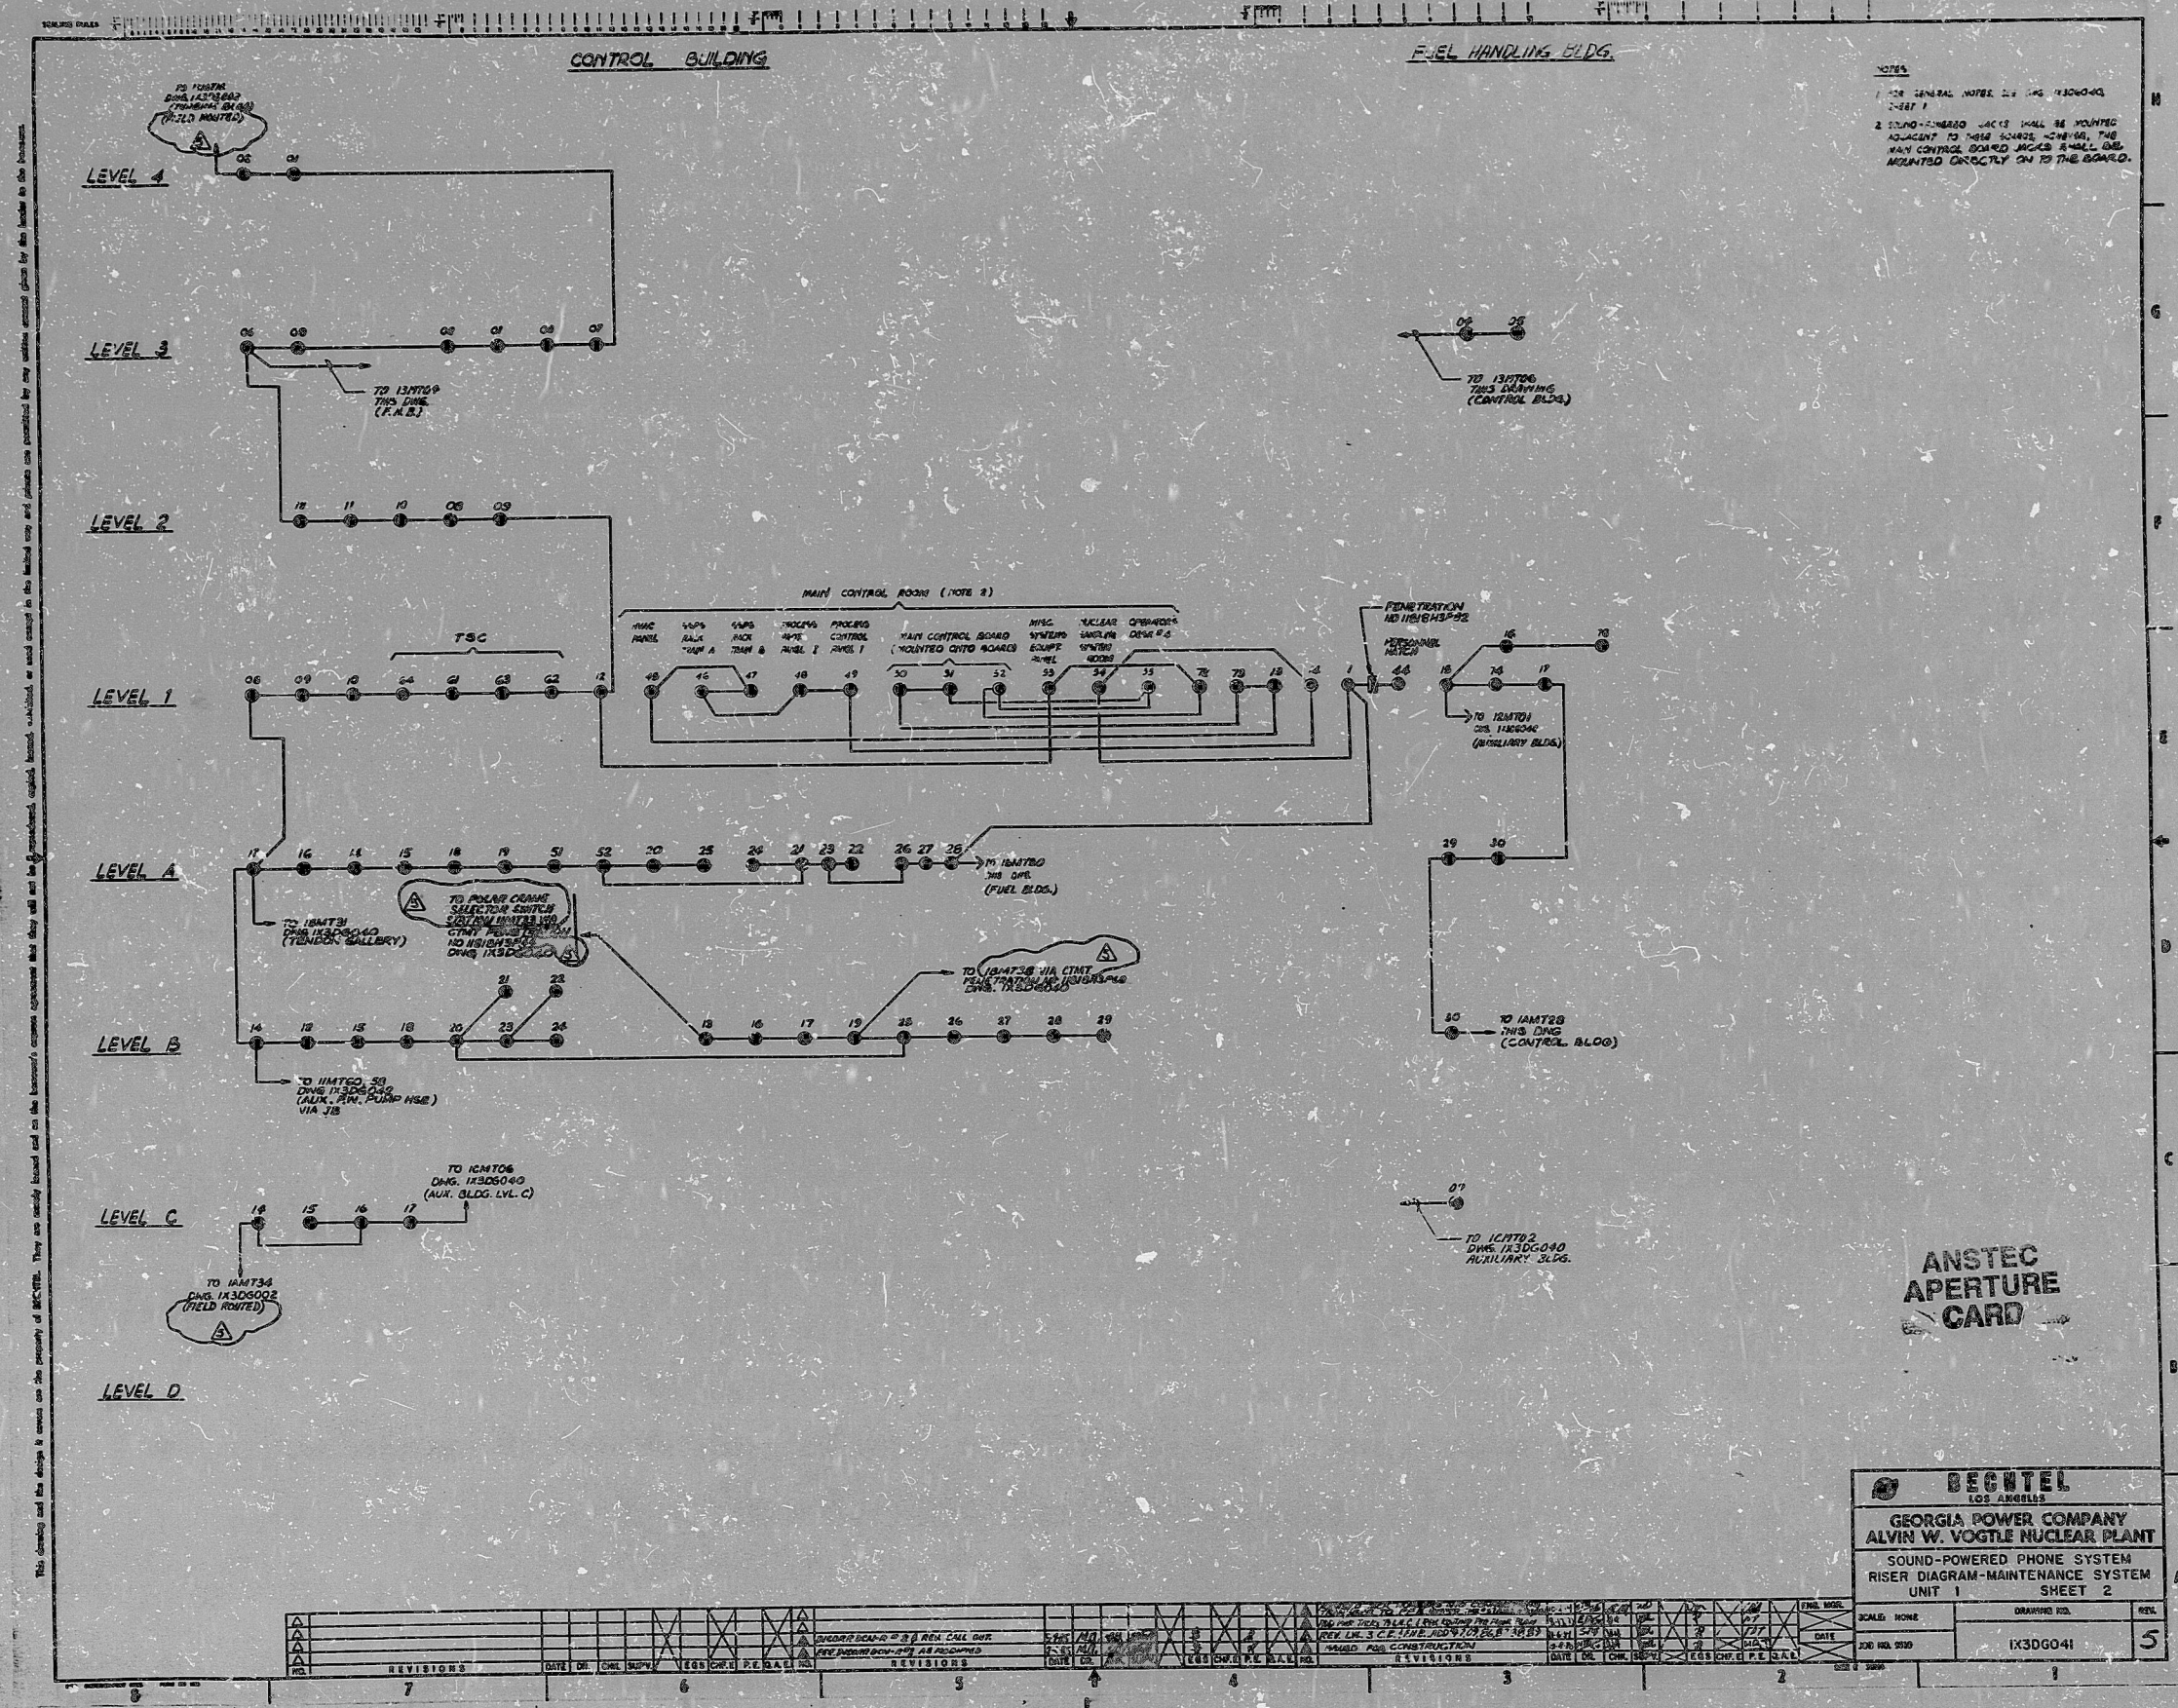

DECHTEL	
LOS ANGELES	
GEORGIA POWER COMPANY	
ALVIN W. VOGTLE NUCLEAR PLANT	
SOUND-POWERED PHONE SYSTEM	
RISER DIAGRAM-MAINTENANCE SYSTEM	
UNIT 1	
SHEET 2	
SCALE: NONE	DRAWN: P.E. SAL
DATE: 200 JUL 2000	IX3DG041
5	

PDR RIDG

9512190417

