

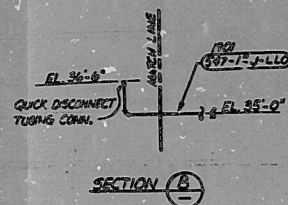
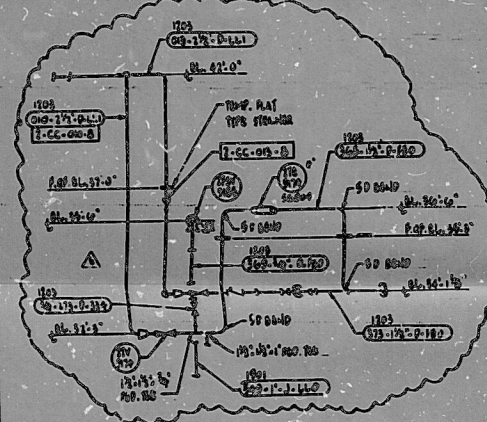


MATCH LINE W. 3+12 FOR CONT. SEE DWG. N° 40469 AREA 2C14

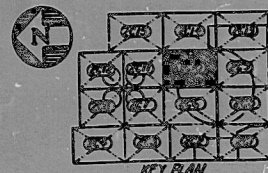

MATCH LINE S. 18+62.5 FOR CONT. SEE DWG. N° 40469 AREA 2C11

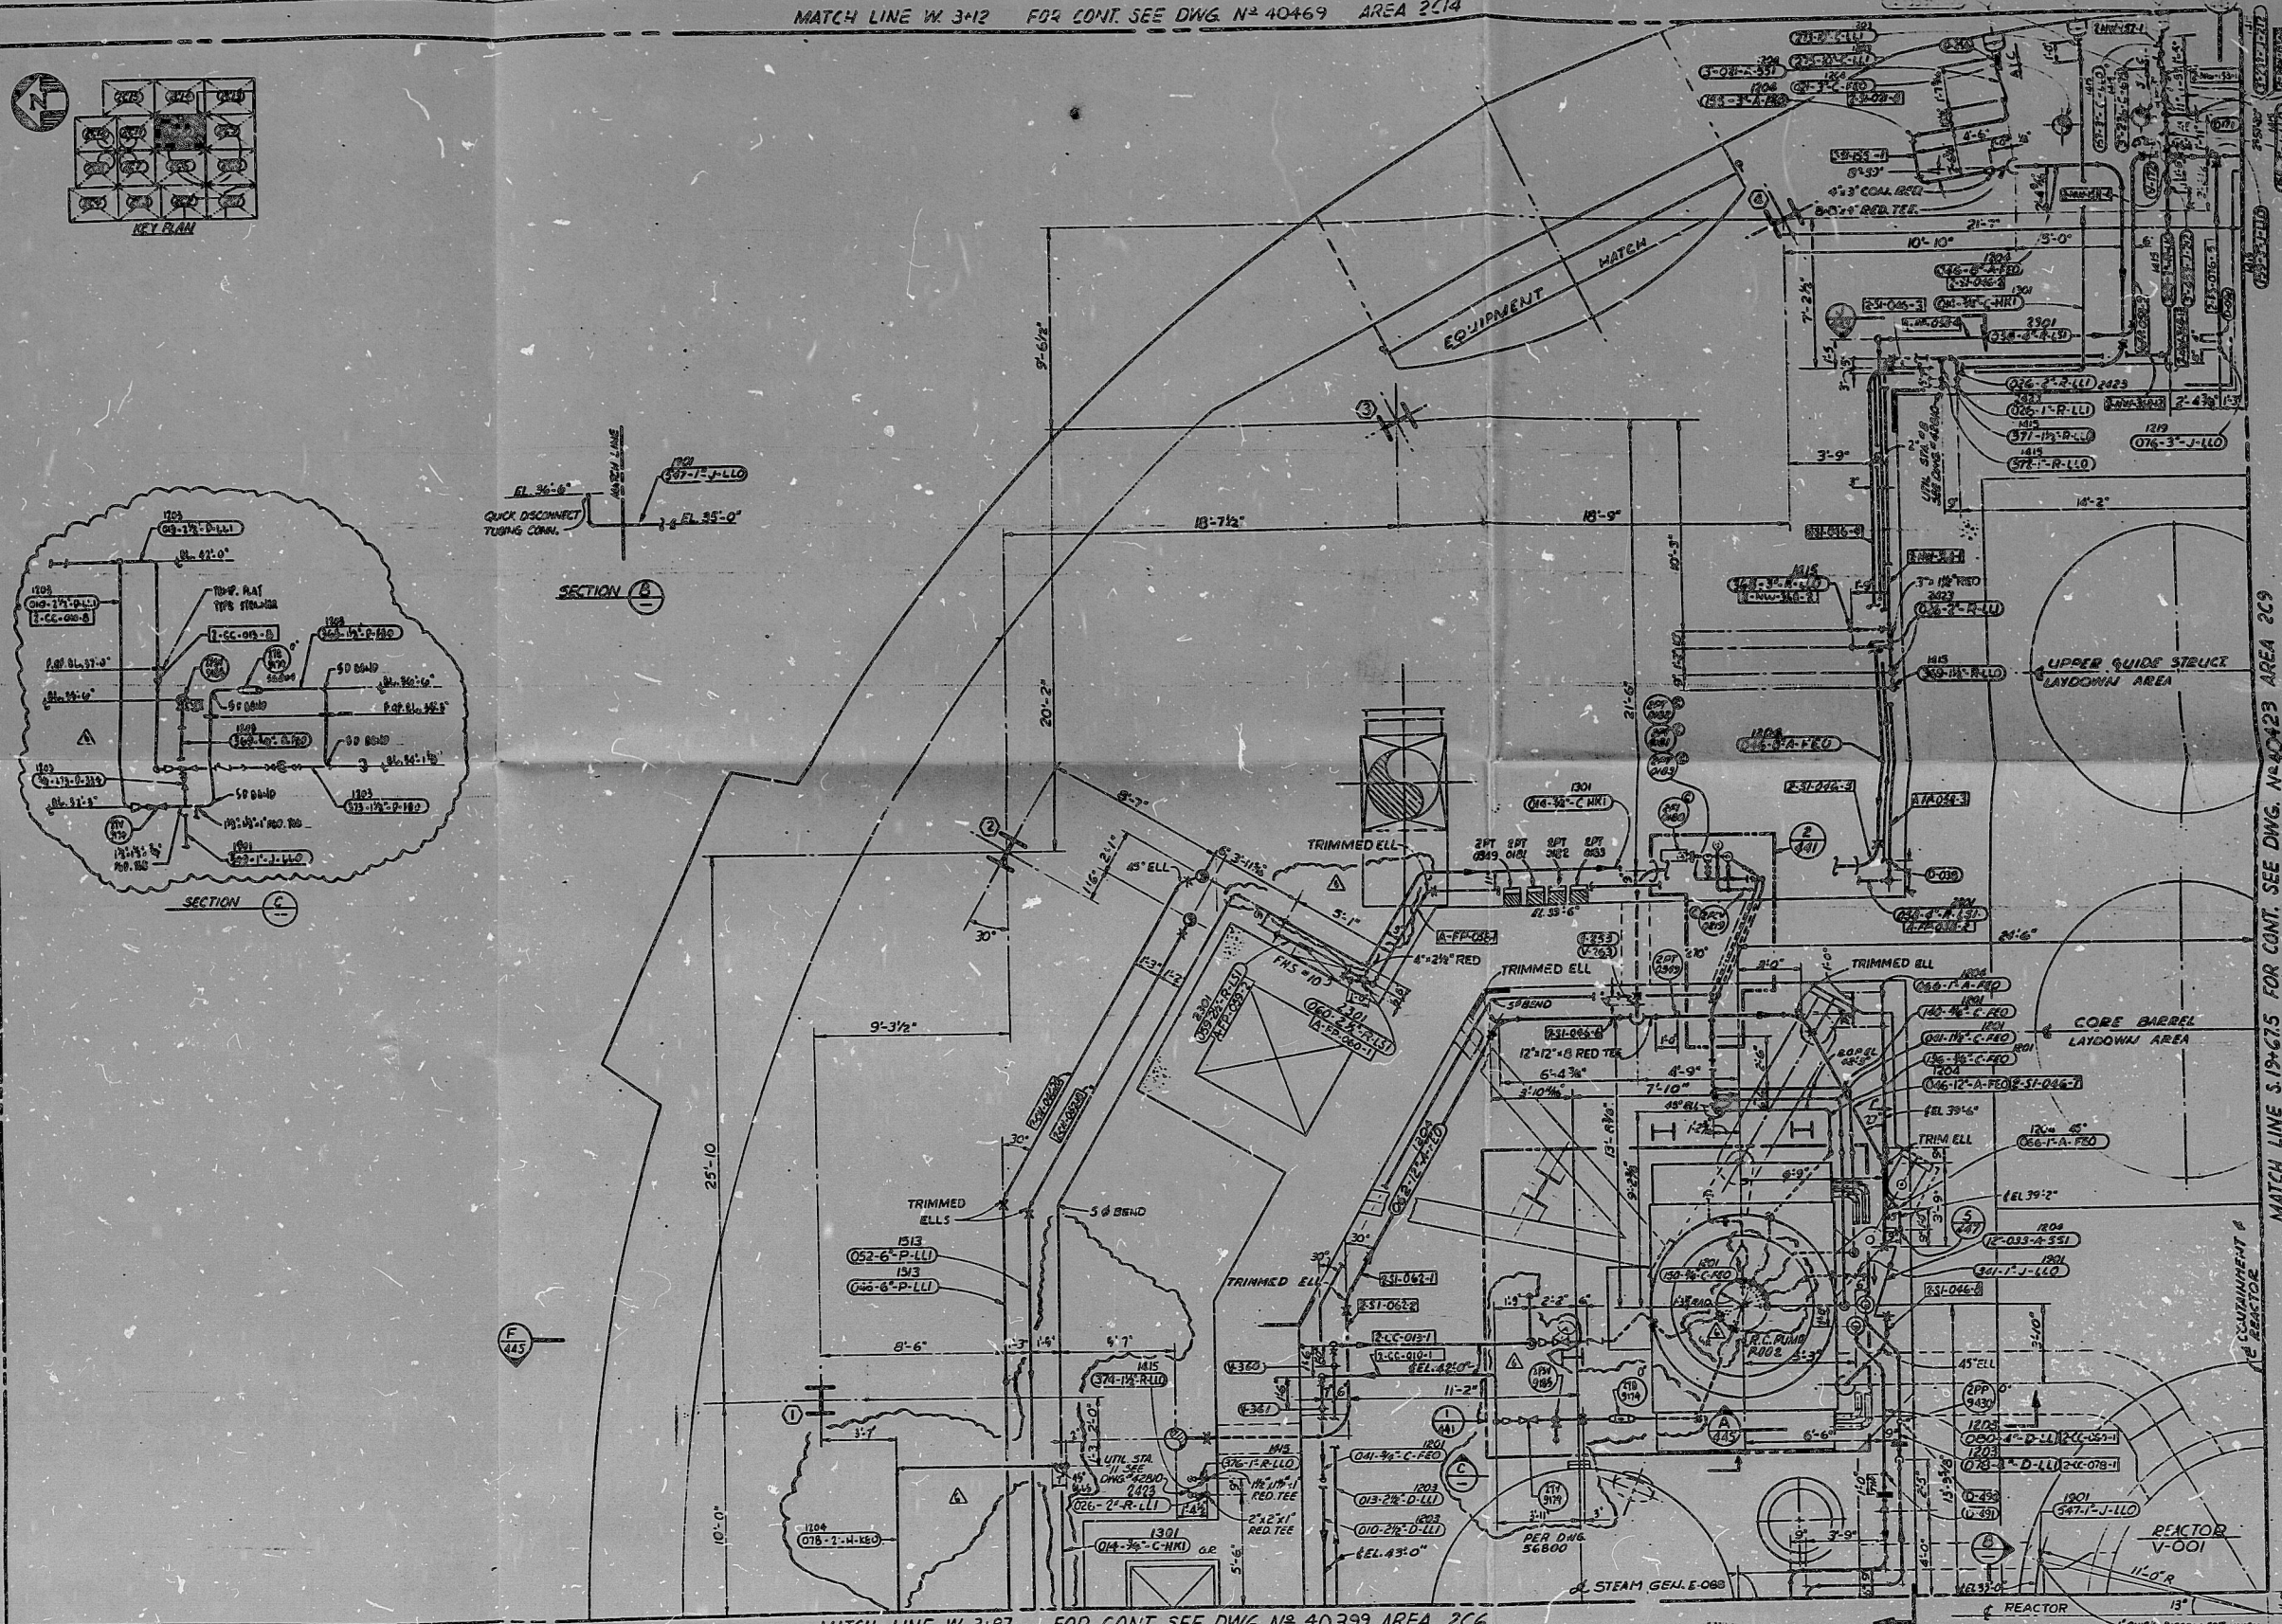

MATCH LINE W. 3+87 FOR CONT. SEE DWG. N° 40399 AREA 2C6

MATCH LINE S. 19+67.5 FOR CONT. SEE DWG. N° 40423 AREA 2C9

TI  
APERTURE  
CARD

QUALITY CLASS I  
UNIT 2

BECHTEL CORPORATION  
ENGINEERS & CONSTRUCTORS  
LOS ANGELES, CALIF.  
JOB NO. DATE APPROVED  
10070

3/1/77  
3/1/77

P & ID 40439-6 (SHEET 1 OF 2)  
FLOOR DRAINS  
4.0 V. & A.C. PLAN  
ELECTRICAL PLAN  
STEEL PLAN  
CONCRETE PLAN  
CROSS REFERENCES

NO. 1  
REVISIONS  
DATE  
BY  
CHKD.  
E.C.

1. INCORPORATE ALL CHANGES FROM PREVIOUS EDITIONS  
2. REVISED FOR CONSTRUCTION  
3. REVISED FOR CONSTRUCTION  
4. REVISED FOR CONSTRUCTION  
5. REVISED FOR CONSTRUCTION

DATE  
BY  
CHKD.  
E.C.

DATE  
BY  
CHKD.  
E.C.

SAN ONOFRE NUCLEAR GENERATING STATION  
AREA 2C10  
PIPING PLAN  
ELEVATION 45'-0" TO 33'-0"  
SOUTHERN CALIFORNIA Edison COMPANY  
LOS ANGELES, CALIF.

40439-6

8701060497

23 22 21 20 19 18 17 16 15 14 13 12 11 10 9 8 7 6 5 4 3 2 1

I CERTIFY THAT THE IMAGE CONTAINED ON THIS FRAME WAS MADE IN THE NORMAL AND REGULAR COURSE OF BUSINESS ON THE DATE STATED HEREIN AND THAT IT IS AN ACCURATE REPRESENTATION OF THE DOCUMENT SUBMITTED TO MICROFILM.

PDR

8701060497

