


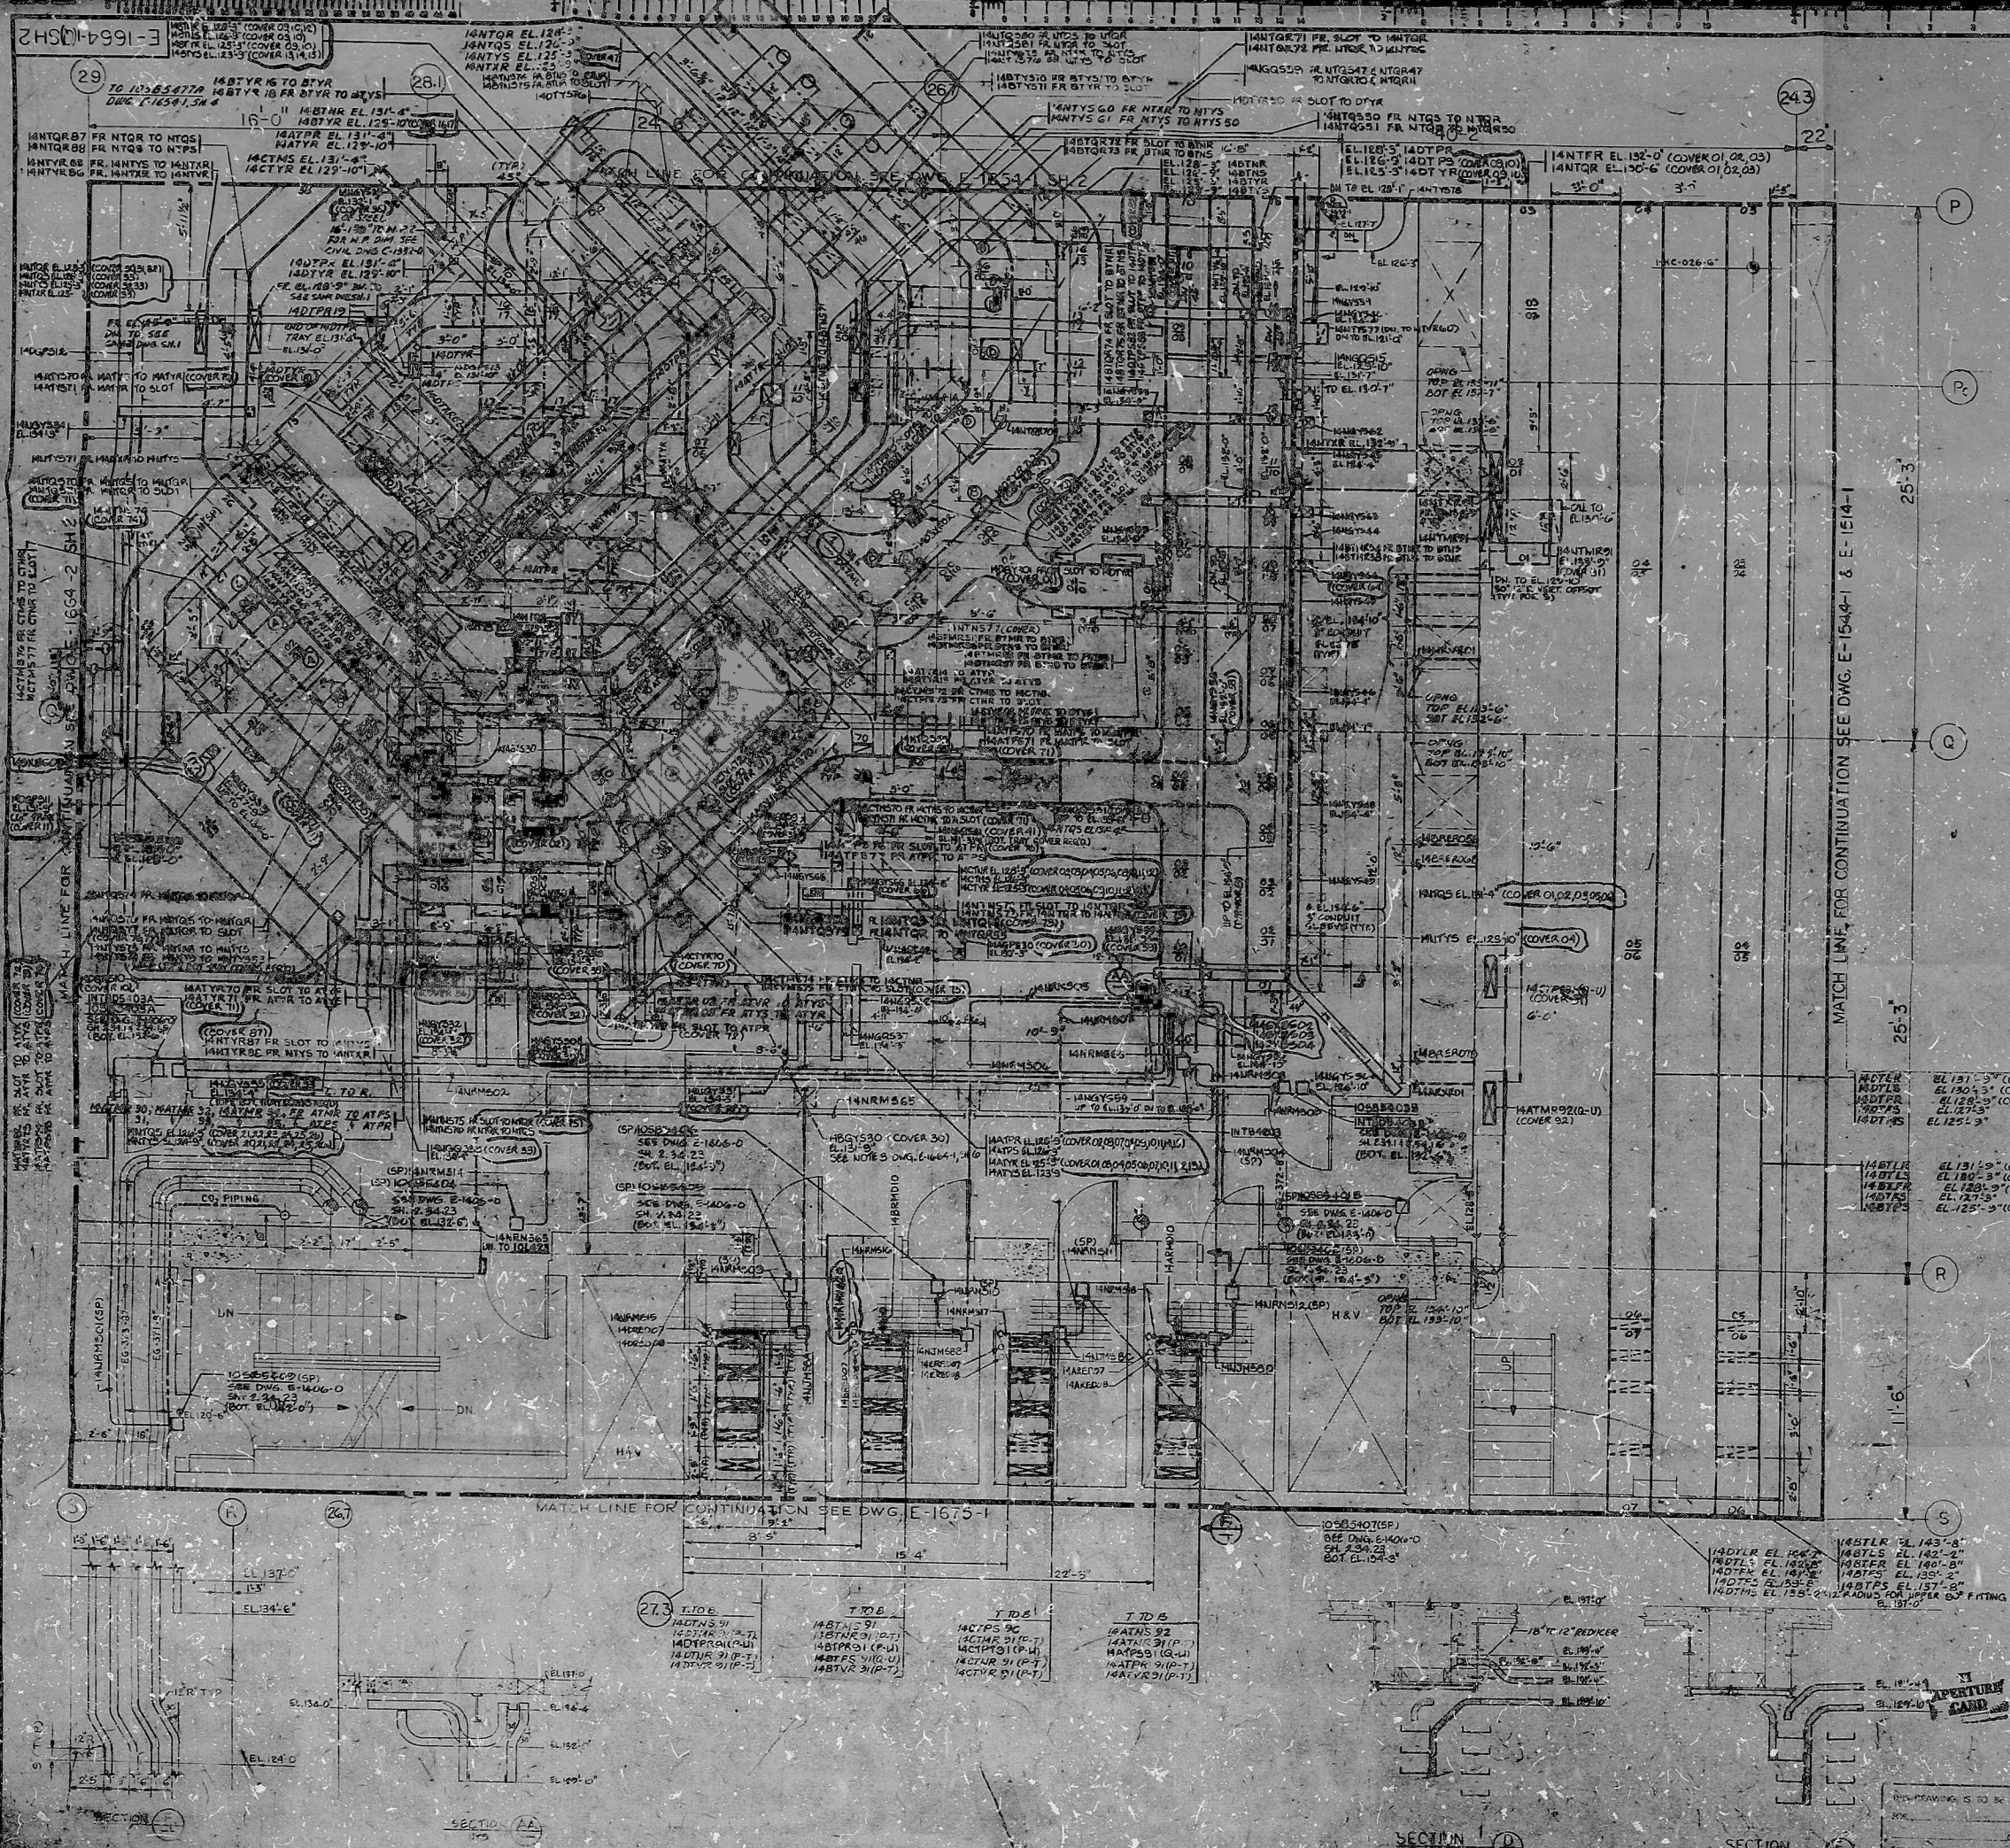


- NOTES:
1. CLASS 12 RACEWAY-TRAY & COND., ETC., ARE IDENTIFIED FOR "Q" LISTED INSTALLATION BY LETTERS A, C, G, W, X, Y AND Z, IN THE THIRD CHARACTER OF THE RACEWAY NUMBER.
  2. ALL CABLE TRAYS 24" UNLESS OTHERWISE SHOWN.
  3. FOR ELECT. RACEWAY NOTES, SYMBOLS & DETAILS SEE DWG. E-1406-0.
  4. 12" RADII FOR ALL VERTICAL ELBOW, TEE AND CROSS FITTING.
  5. FOR HANGER DETAIL "A" SEE DWG. E-1644-1, SHT. 1.
  6. FOR HANGER INFORMATION SEE SHT. 2 OF THIS DWG.

- REFERENCE DRAWINGS
- E-1529-0 AUX BLDG.-CONT. AREA PL. PLAN EL. 117'-6" AREA 26
  - E-1363-0 AUX BLDG.-CONT. AREA STRUCTURAL STEEL FLOOR FRAMING PLAN EL. 117'-0" AREA 8
  - E-1355-0 AUX BLDG.-CONT. AREA STRUCTURAL STEEL FLOOR FRAMING PLAN EL. 124'-0" AREA 8
  - E-1311-0 (COVER 04/05/06) AUX BLDG.-CONT. AREA STRUCTURAL STEEL FLOOR FRAMING PLAN EL. 137'-0" AREA 8
  - E-1251-0 (COVER 04) HVAC AREA DRAWING AUX BLDG.-AREA 26 PLAN AT EL. 117'-6" 124'-0"
  - E-1311-0 (COVER 03/04) PLUMBING & DRAINAGE, AUX BLDG. CONT. AREA PLAN AT EL. 137'-0" AREA 26
  - E-1285-0 (COVER 03/04) PLUMBING & DRAINAGE, AUX BLDG. CONT. AREA PLAN AT EL. 124'-0" AREA 26

| NO. | REVISION                      | DATE    | BY          | CHKD. | APP'D. |
|-----|-------------------------------|---------|-------------|-------|--------|
| 1   | REV. AS PER REV. TABLE NO. 1  | 10/1/50 | W. J. H. R. |       |        |

**DECTEL**  
SAN FRANCISCO  
PUBLIC SERVICE COMPANY AND GAS COMPANY  
HOPE CREEK GENERATING STATION

RACEWAY PLAN  
AUX BLDG CONTROL AREA 26  
PLAN AT EL. 124'-0"

SHT. 2 OF 6

PDR RIDS

8512130573

