
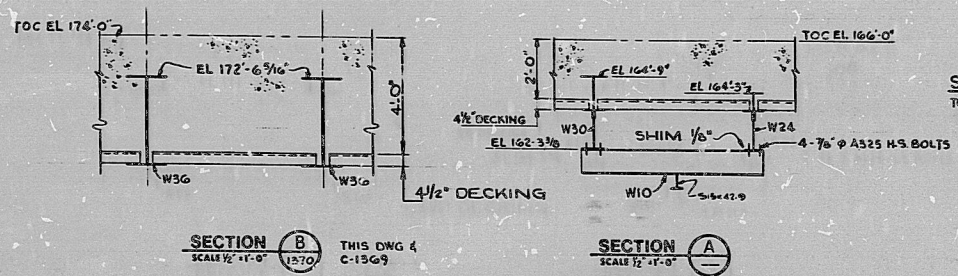


This drawing and the design it covers are the property of BECHTEL. They are loaned to you for your company's use only and are not to be reproduced, copied, loaned, or used in any way without written permission from the lender to the borrower.

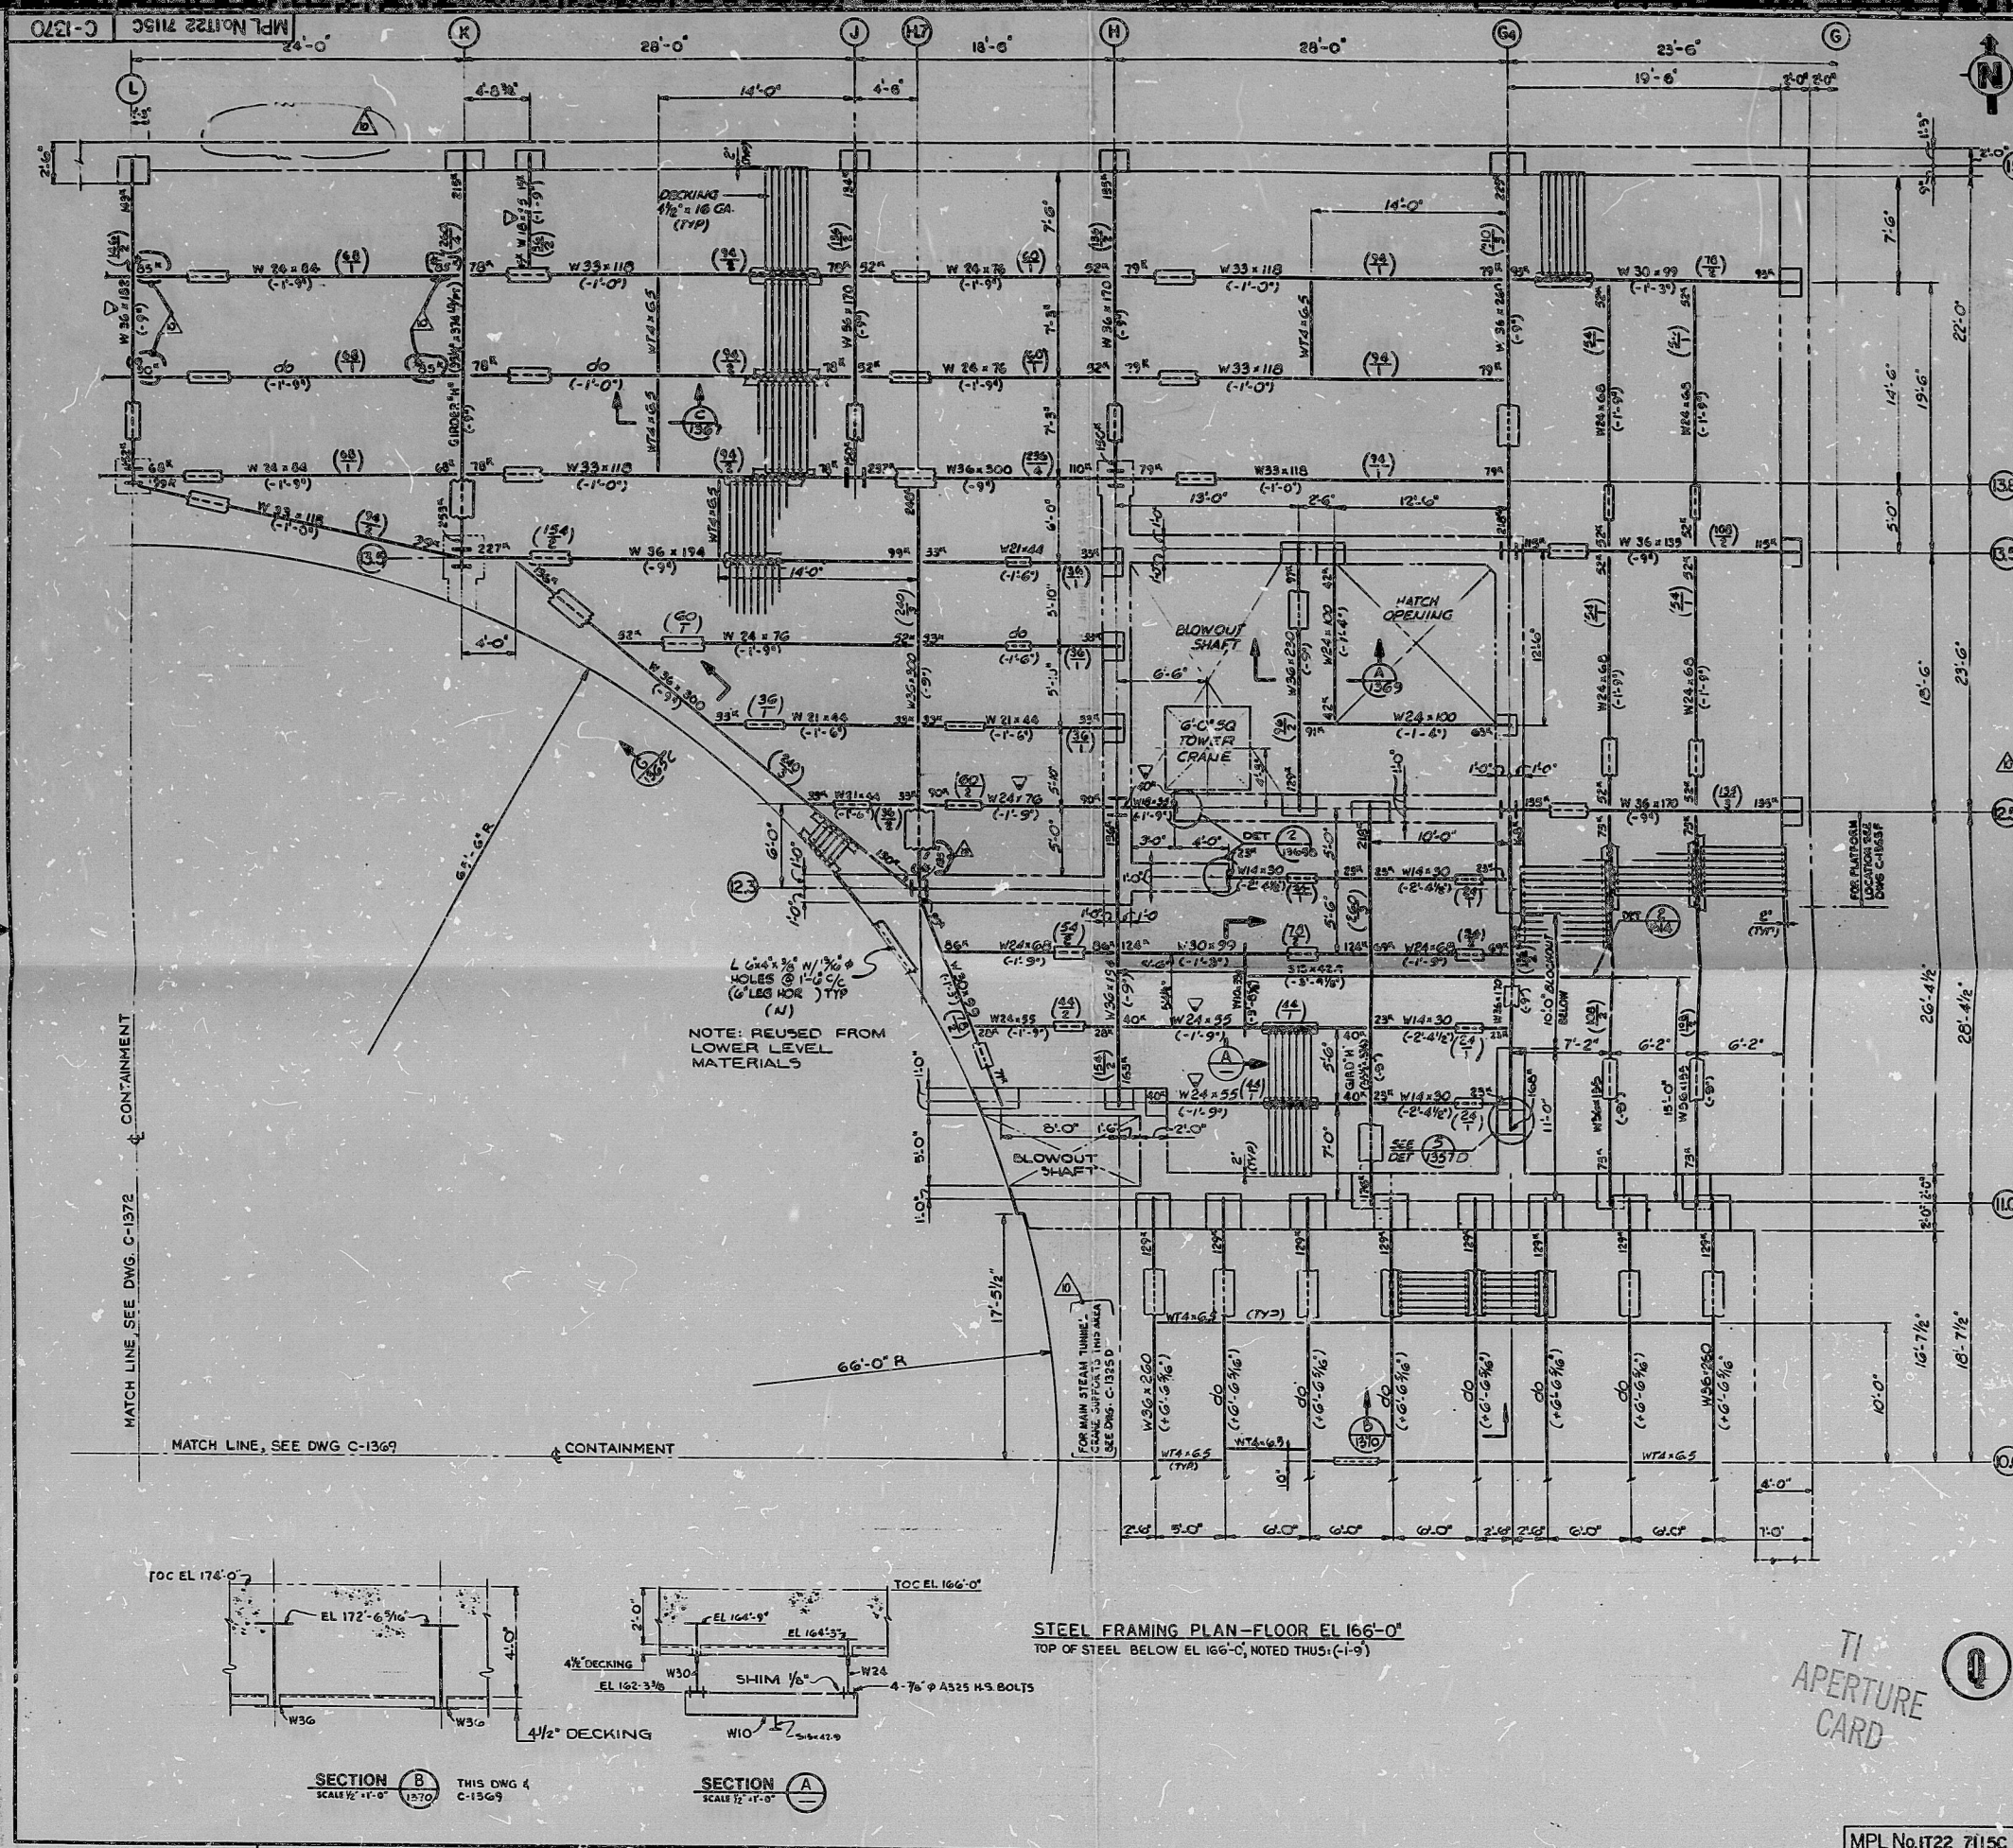

STEEL FRAMING PLAN-FLOOR EL 166'-0"
TOP OF STEEL BELOW EL 166'-0", NOTED THUS: (-1'-9")

- NOTES**
1. FOR GENERAL NOTES SEE DWG C-1355 A
 2. ALL STUDS TO BE 3/4" x 1/4" LG. NOTED THUS: (60) 1/8 OF STUDS 1/3 OF ROWS
 3. SEE DETAIL 1, DWG C-1367 FOR STUD DETAILS & SHELF ANGLE LOCATIONS FOR METAL DECKING.
 4. FOR DECKING NOTES SEE DWG C-1369
 5. MEMBERS MARKED THUS ∇ ARE TO BE TAKEN FROM SURPLUS MATERIAL LIST
 6. SEE NOTES # 11 ON DWG C-1369
 7. FURNISH DETAIL, FAB. DELIVERY AND ERECTION OF ITEMS SHOWN ON DET 2/18/14 ARE UNDER SPEC. C-181.0 & C-183.0
 8. (SEE NOTE # 13 ON DWG C-1361)

- REFERENCE DRAWINGS**
- C-1369 FRAMING PLAN EL 166'-0" AREA 7
 - C-1371 FRAMING PLAN EL 166'-0" AREA 9
 - C-1372 FRAMING PLAN EL 166'-0" AREA 10
 - C-1355A COLUMN SCHEDULE
 - C-1356A BASE PLATE DETAILS
 - C-1356C ANCHOR BOLT SCHEDULE
 - C-1357A BEARING PLATES/GORDER SCHEDULE
 - C-1356C SECTIONS & DETAILS
 - C-1362 FRAMING PLAN EL 115'-0" AREA 8
 - C-1303 B BEAM POCKETS & ANCHOR BOLTS
 - H-1015 EQUIPMENT LOCATIONS EL 166'-0"
 - C-1357B,C,D MISC BEARING PLATE DETAILS
 - C-1355B COLUMN SPICE DETAILS
 - C-1314 RIGGING BEAMS/DETAILS
 - C-1365F STR. STL. PLANS SECT. & DETAIL
 - C-1325D MISC. ENG. STL. PLANS SECT. & DETAIL

ALL STEEL DECKING IS NON "Q"

REV.	DESCRIPTION	DATE	BY	CHKD.
1	ISSUED FOR MILL ORDER	10/1/79	WTC	WTC
2	ADDED HOLD	10/1/79	WTC	WTC

BECHTEL SOUTHBRIDGE, MASSACHUSETTS	
MISSISSIPPI POWER & LIGHT COMPANY GRAND DUNE NUCLEAR STATION UNIT 1, AUX. BLDG. AREA 8 STRUCTURAL STEEL FRAMING PLAN-FLOOR EL. 166'-0"	
DWG. NO.	REV.
9645	10
C-1370	

MPL No. IT22 7115C

8701 070044

SUPERVISOR *Alfonso* OCT 79 CAMERA OPERATOR *John*

PDR

8701070044

