


THIS DRAWING AND THE DESIGN IT CARRIES ARE THE PROPERTY OF SOUTHERN COMPANY SERVICES, INC. THEY ARE LOANED TO AND ON THE BORROWER'S EXPRESS AGREEMENT THAT THEY SHALL NOT BE REPRODUCED, COPIED, LOANED, EITHERED, OR USED EXCEPT IN THE LIMITED WAY AND FOR THE PURPOSES SPECIFICALLY GIVEN BY THE LENDER TO THE BORROWER.

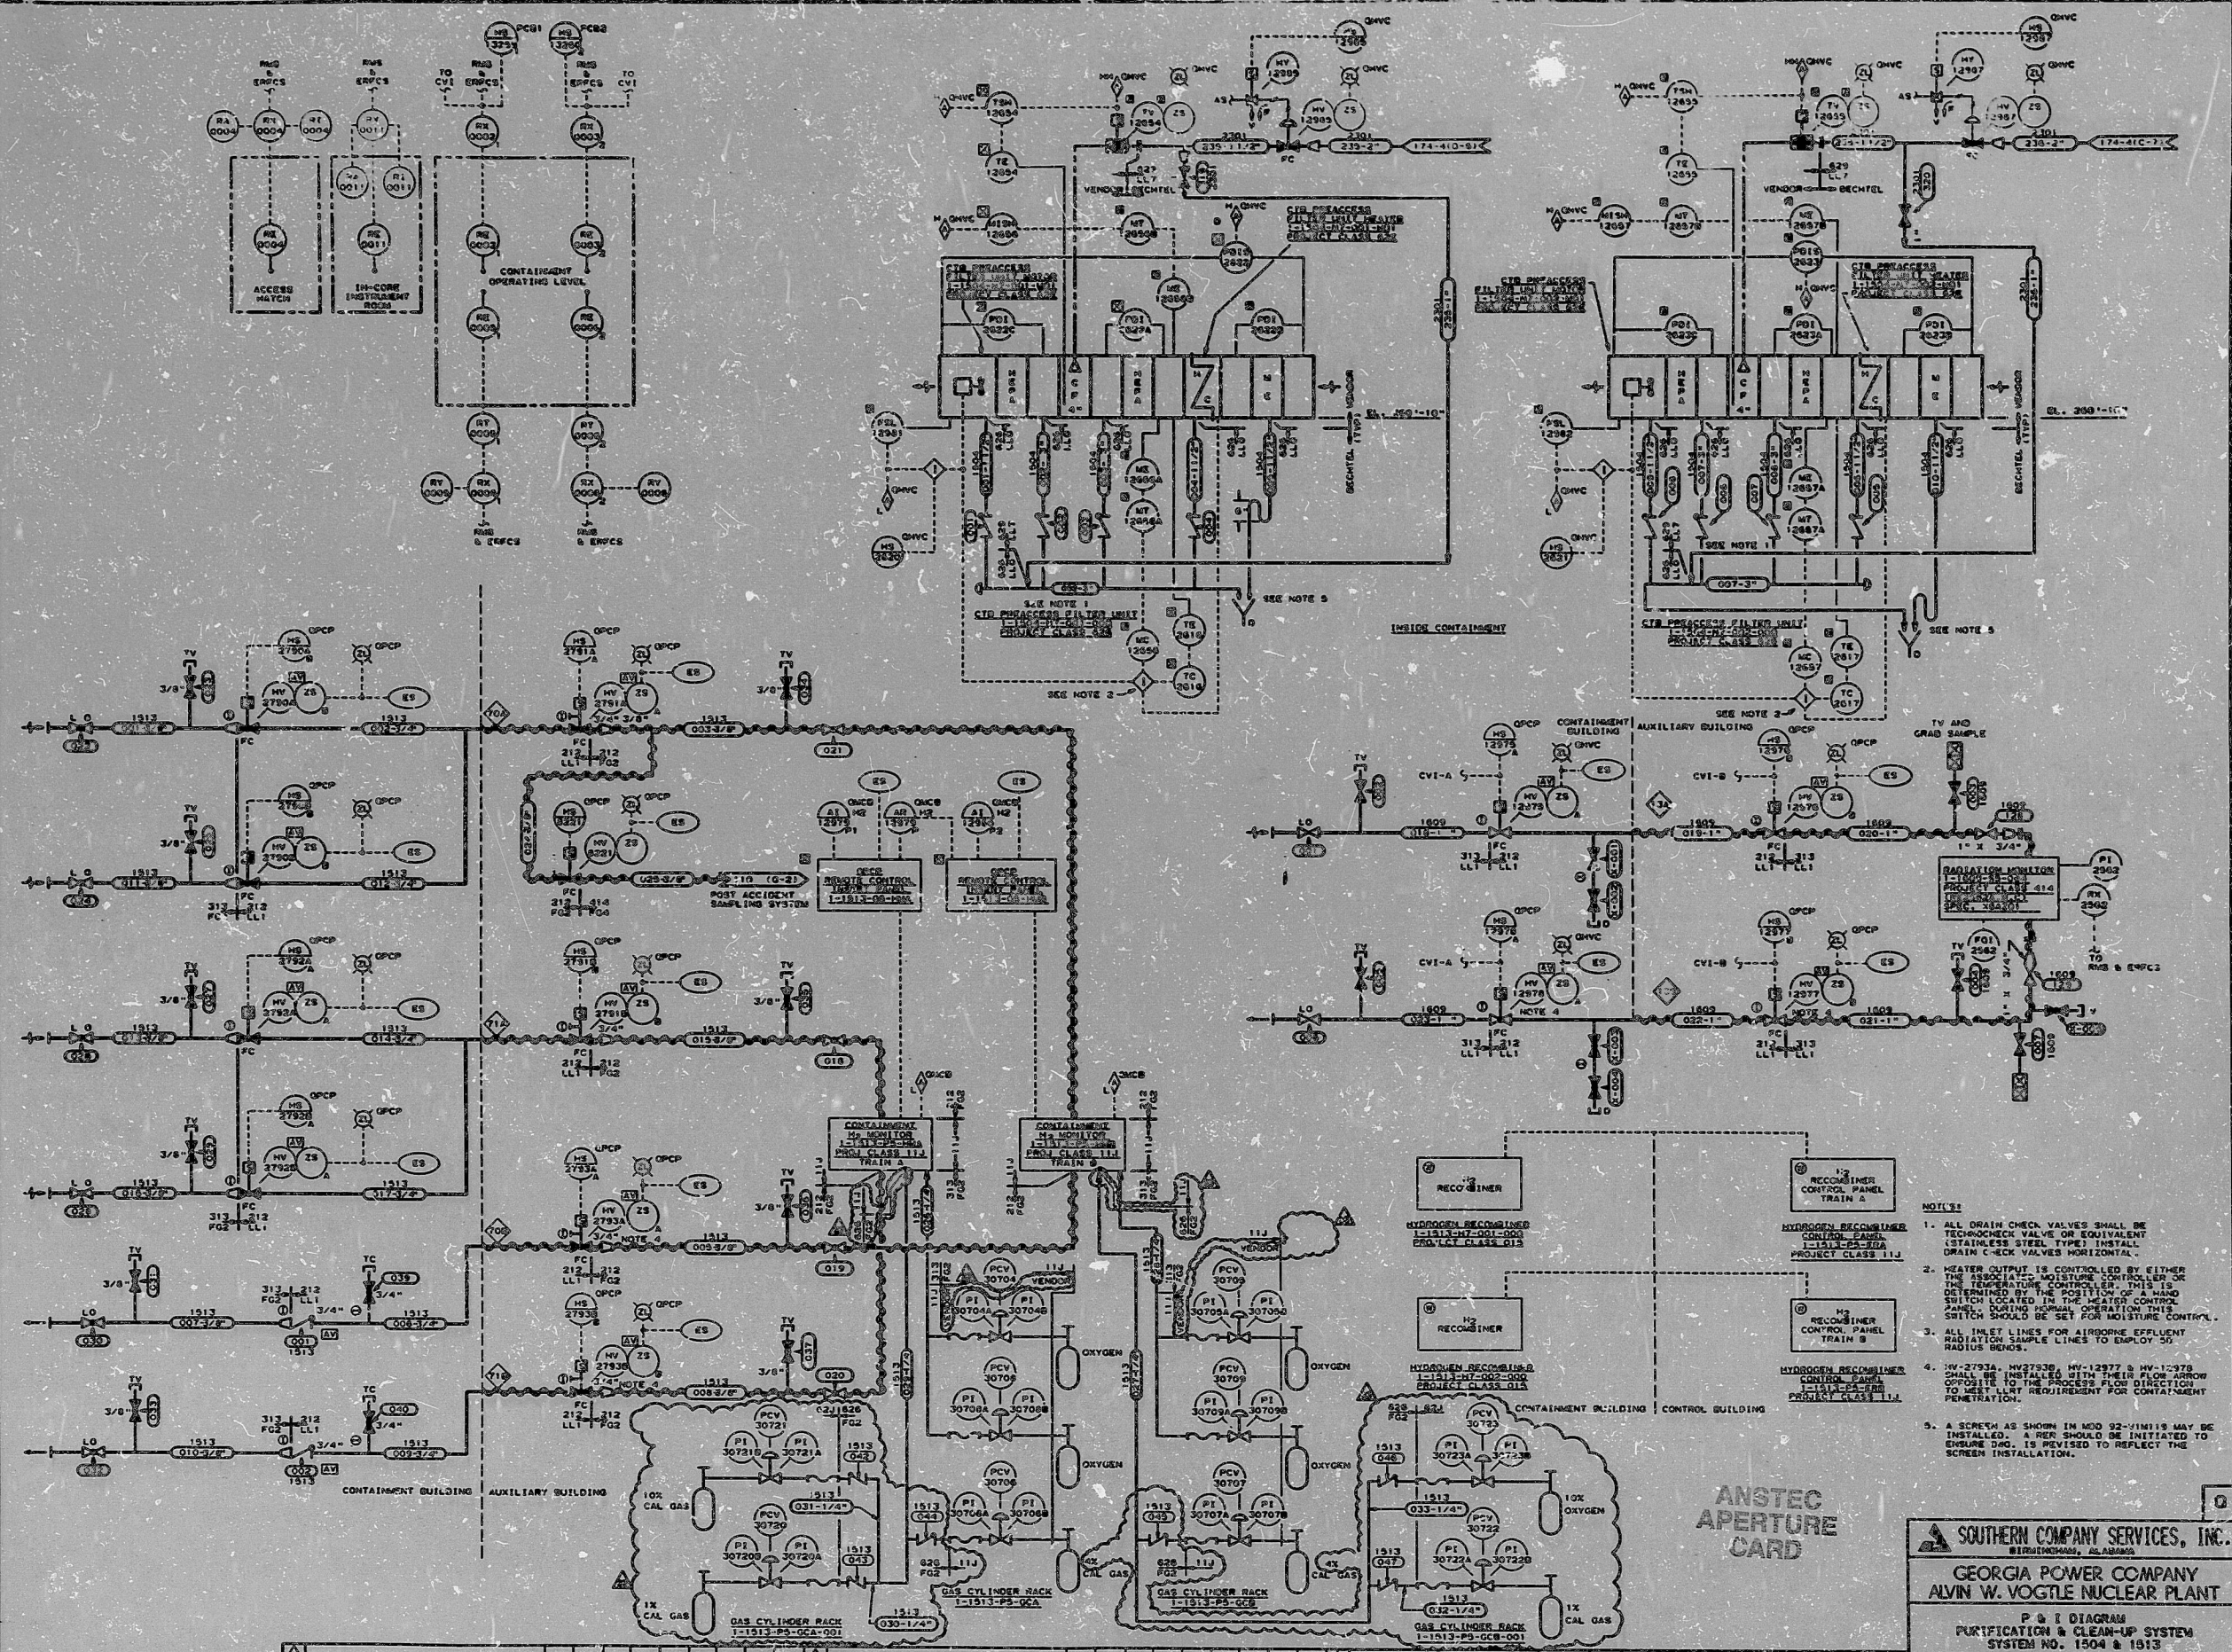

- NOTES:
1. ALL DRAIN CHECK VALVES SHALL BE TECHCHECK VALVE OR EQUIVALENT (STAINLESS STEEL TYPE) INSTALL DRAIN CHECK VALVES HORIZONTAL.
 2. HEATER OUTPUT IS CONTROLLED BY EITHER THE ASSOCIATED TEMPERATURE CONTROLLER OR THE TEMPERATURE CONTROLLER. THIS IS DETERMINED BY THE POSITION OF A HAND SWITCH LOCATED IN THE OPERATION CONTROL PANEL. DURING NORMAL OPERATION, THIS SWITCH SHOULD BE SET FOR AUTOMATIC CONTROL.
 3. ALL INLET LINES FOR AIRBORNE EFFLUENT RADIATION SAMPLE LINES TO EMPLOY 50' RADIIUS BENDS.
 4. HY-2793A, HY-2793B, HY-12977 & HY-12978 SHALL BE INSTALLED WITH THEIR FLOW ARROW OPPOSITE TO THE PROCESS FLOW DIRECTION TO MEET LWT REQUIREMENT FOR CONTAMINANT PENETRATION.
 5. A SCREEN AS SHOWN IN MOD 92-11M119 MAY BE INSTALLED. A REP SHOULD BE INITIATED TO ENSURE DRG. IS REVISED TO REFLECT THE SCREEN INSTALLATION.

ANSTEC
APERTURE
CARD

SOUTHERN COMPANY SERVICES, INC.
BIRMINGHAM, ALABAMA

GEORGIA POWER COMPANY
ALVIN W. VOGTLE NUCLEAR PLANT

P & I DIAGRAM
PURIFICATION & CLEAN-UP SYSTEM
SYSTEM NO. 1504 & 1513

REV.	DATE	BY	CHK	APP	REVISIONS
1	10/10/84	JOB	10/10/84	1X408213-2	23

PDR RIDS

9512200172

