


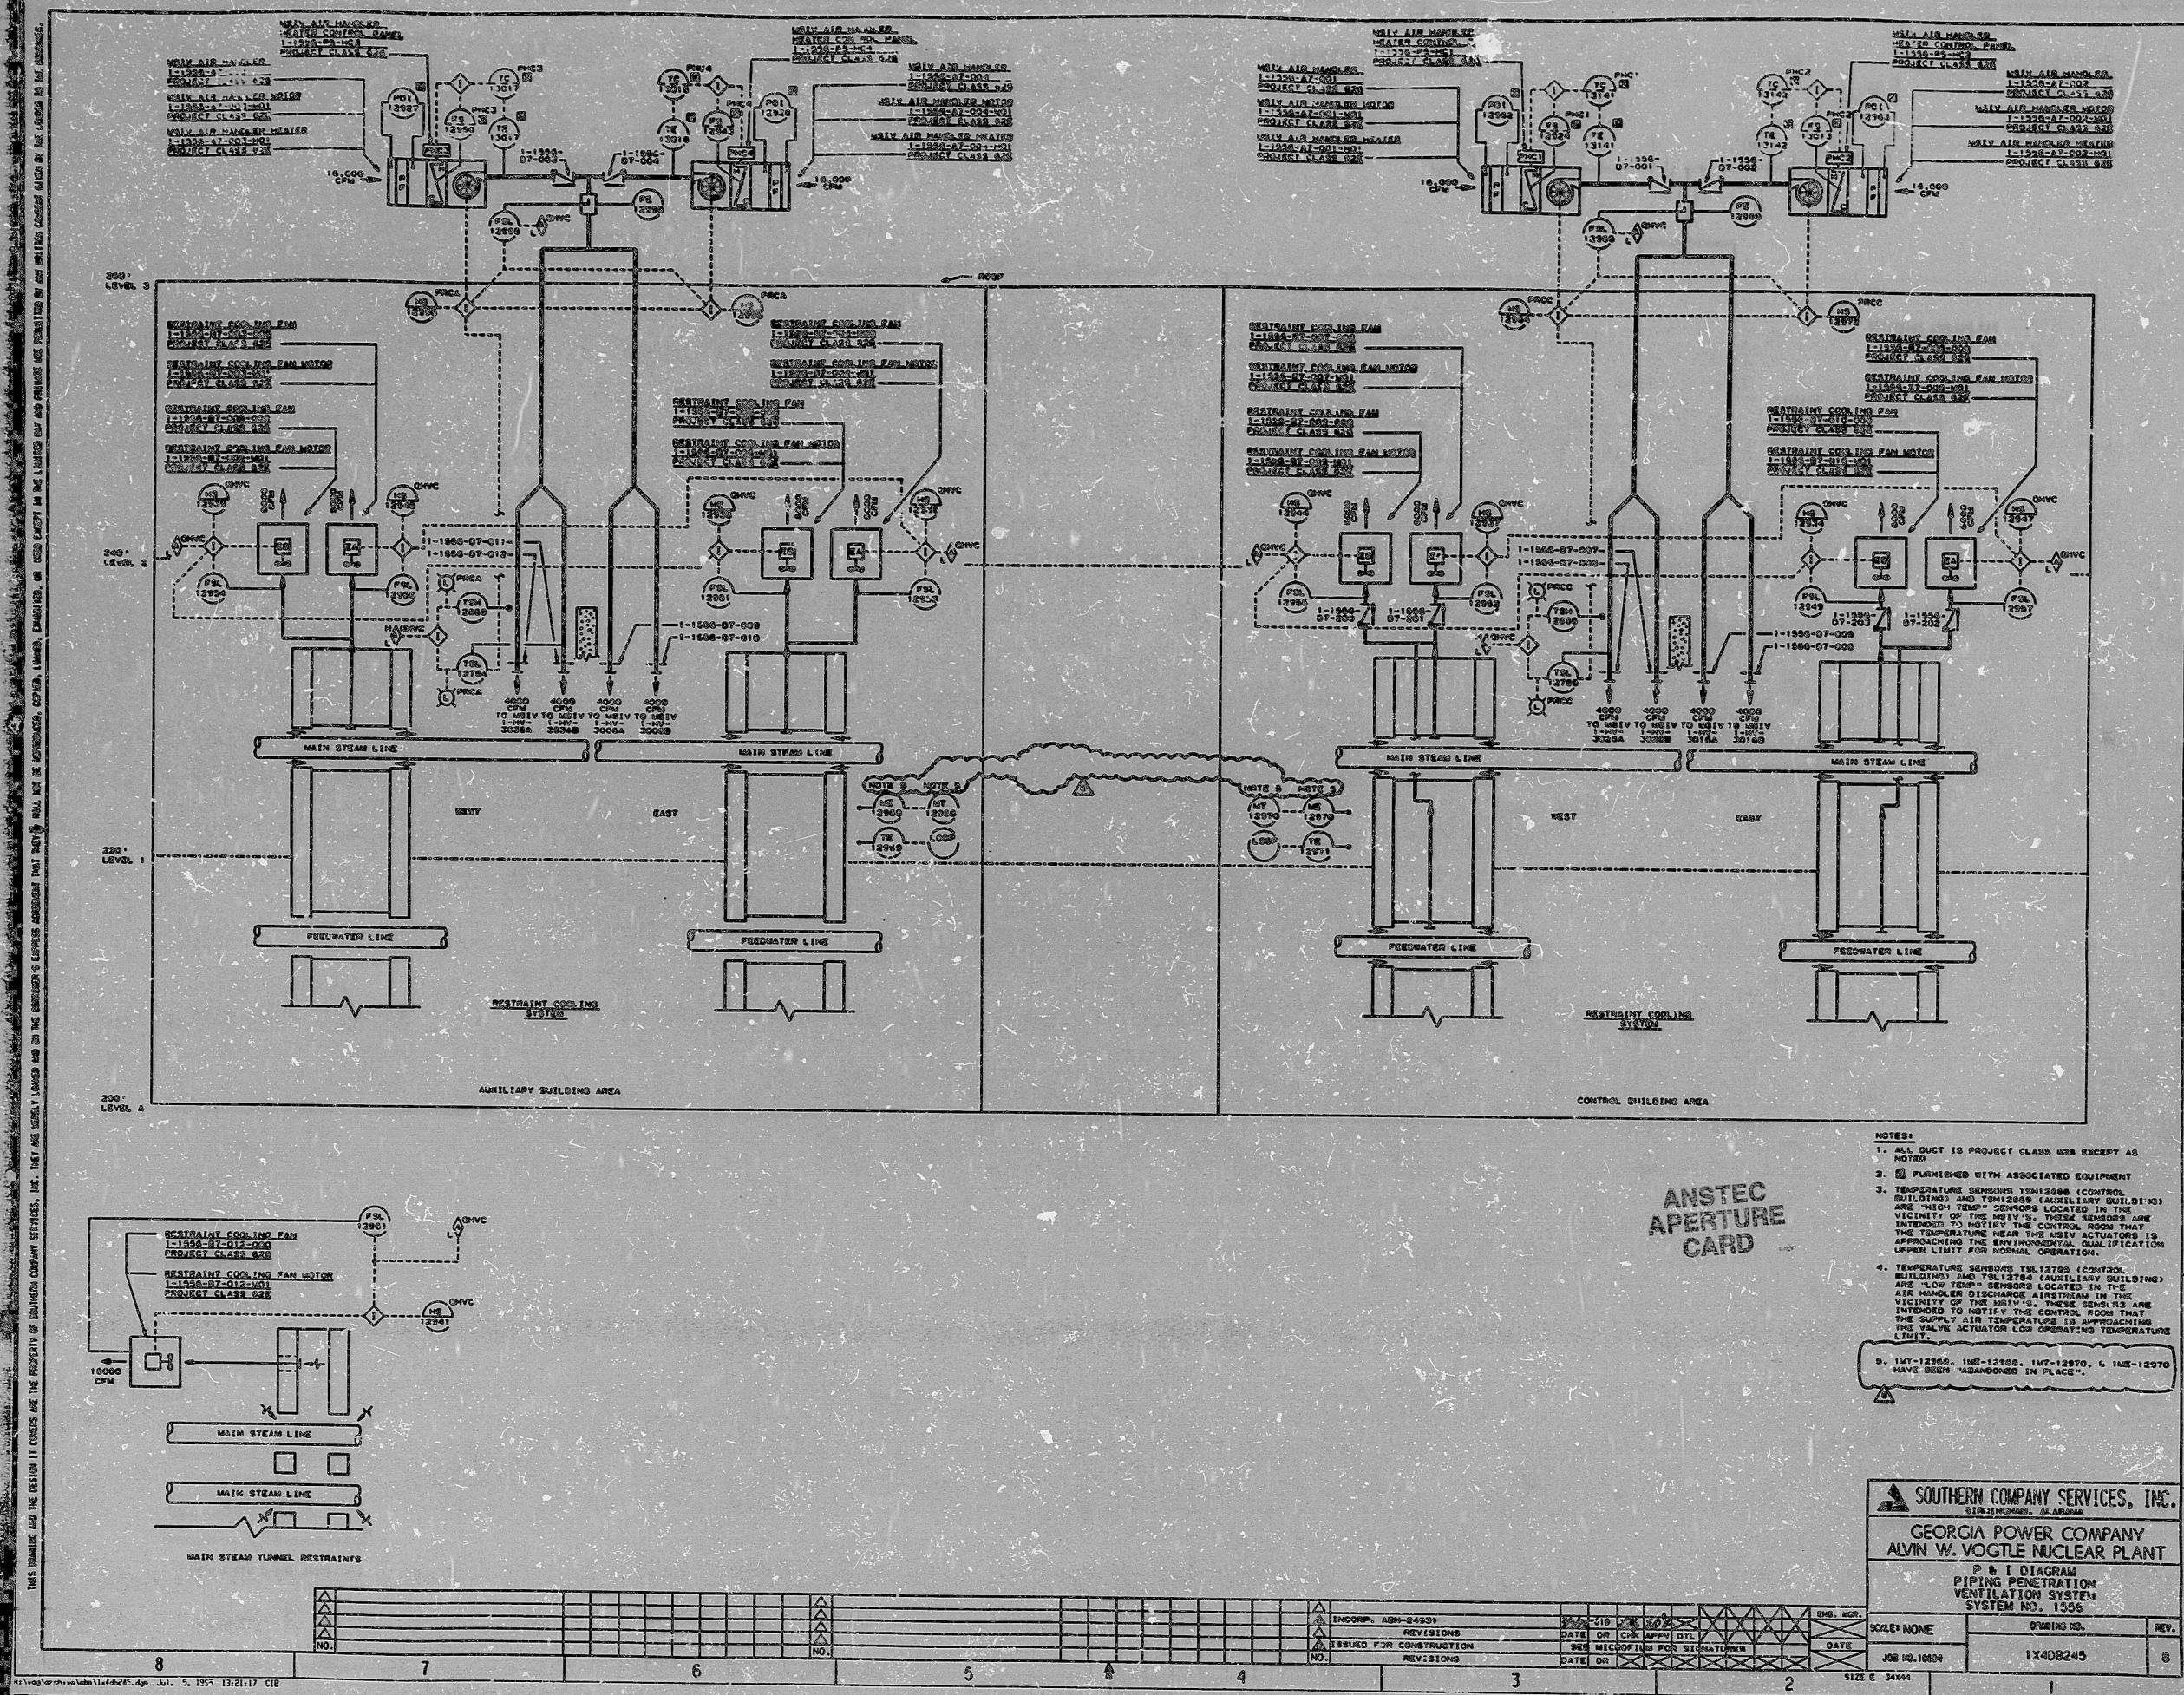

PDR RIDS

9512200199

