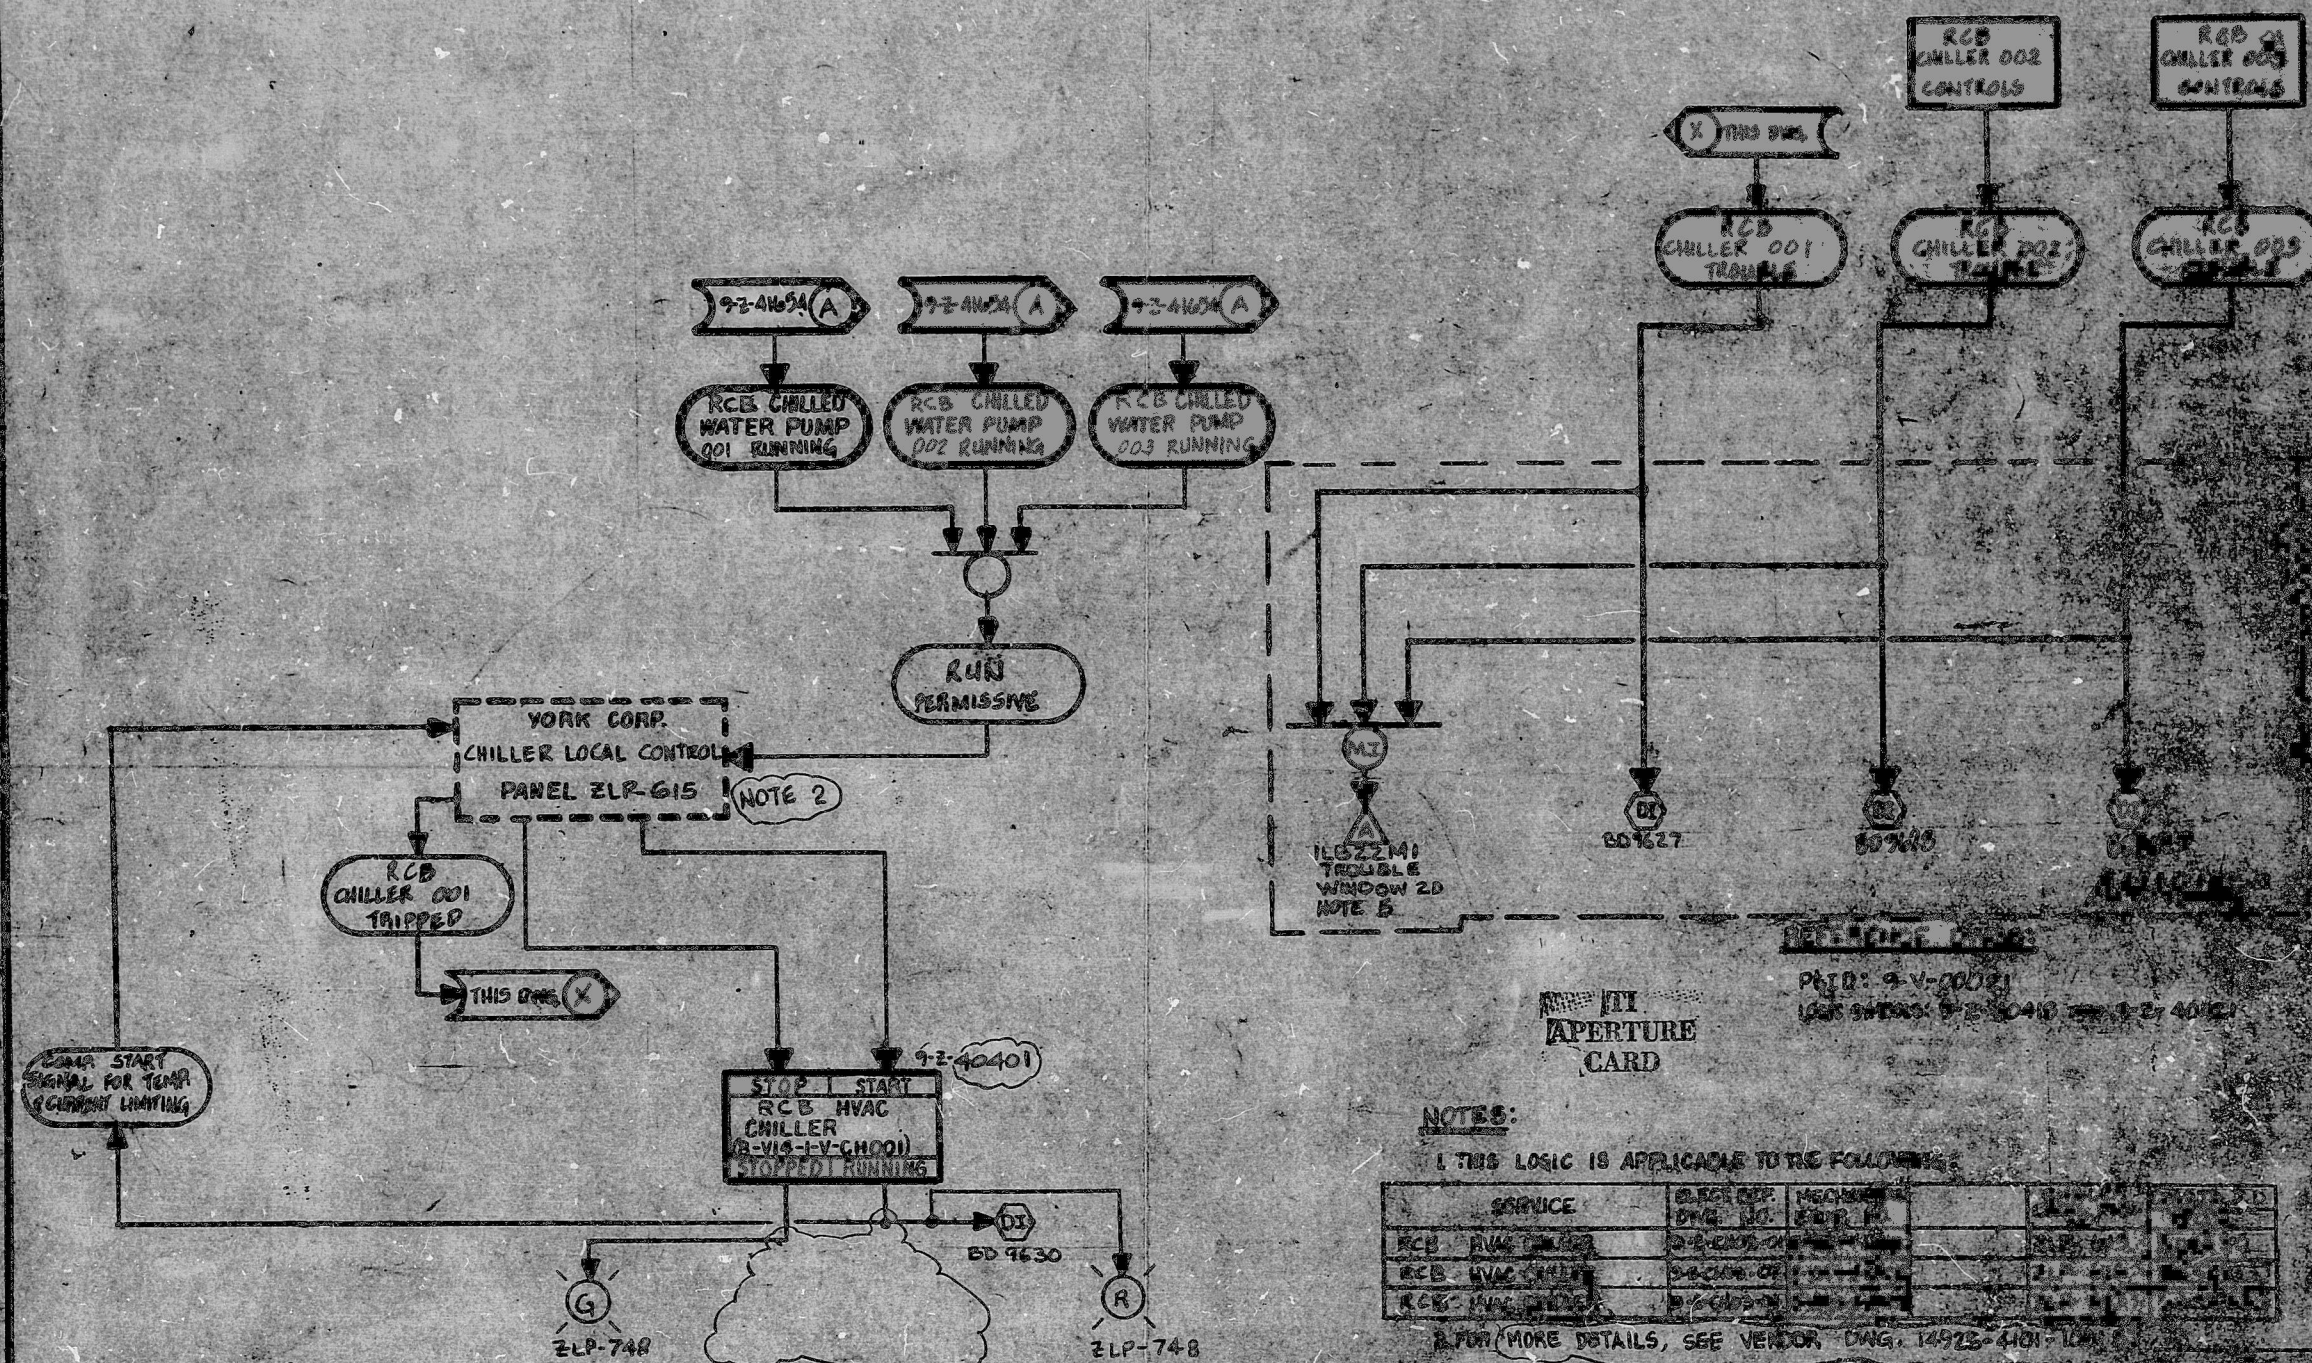


[illegible]

GENERAL NOTE:
THIS DWG REPRESENTS FUNCTIONAL REQUIREMENTS ONLY.

SERVICE	ELECT. OFF. DTC NO.	MECHANICAL DTC NO.	TEST DTC NO.	TEST DTC NO.

FOR MORE DETAILS, SEE VENDOR DING, 14925-4101-100

8. MULTIPLE INPUT AND OUTPUT WINDOW COMMANDS (10/10)

PDR RIDS

8701150481

