


J-102-0

LOGIC CABINET CC652

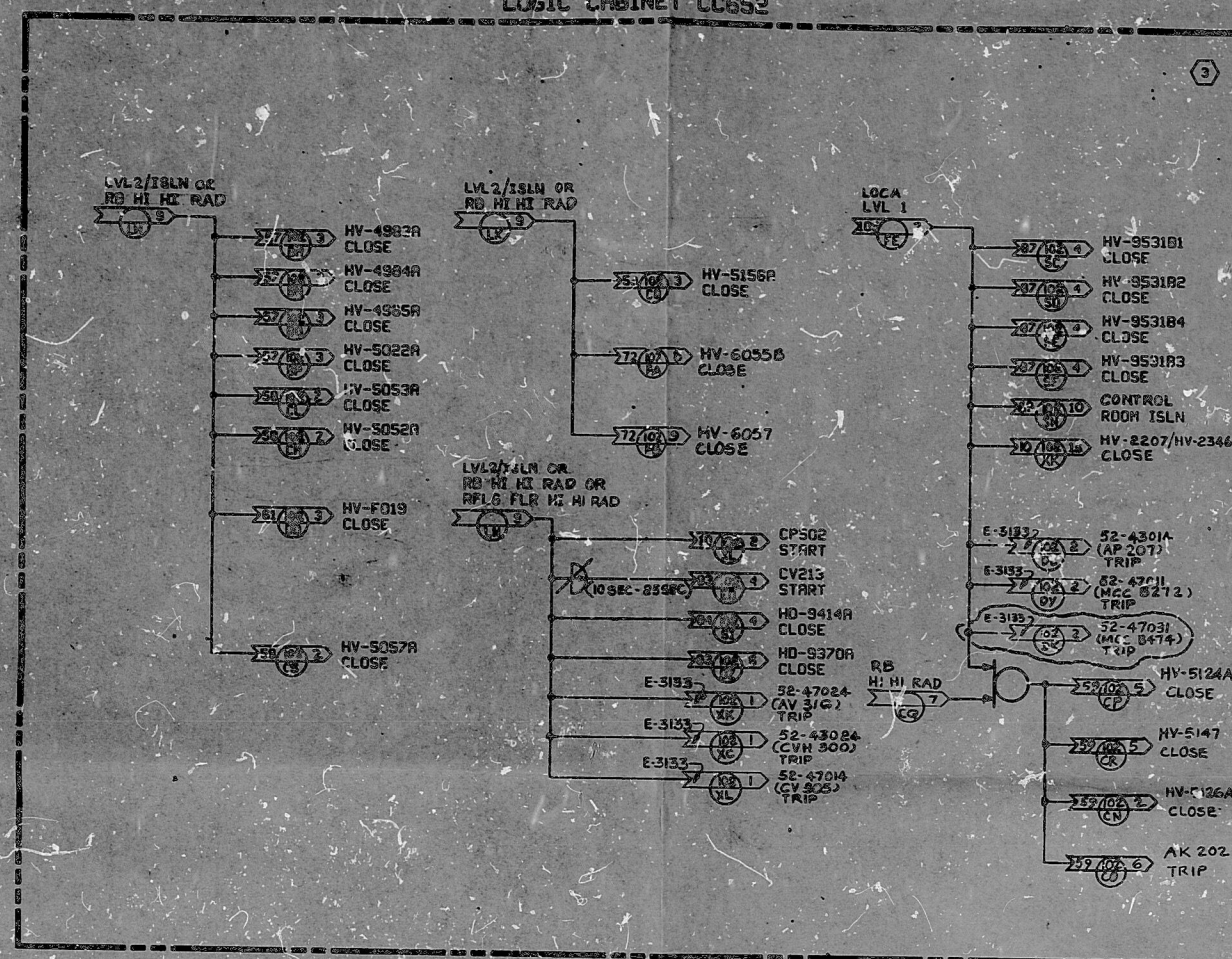

LOCA HIGH RADIATION & LVL 2/ISLN SIGNALS FANOUT
CLASS 1E CHANNEL C

This drawing and the design it covers are the property of BECHTEL. They are made to order and are not to be reproduced, copied, or used in any way without the written permission of BECHTEL.

TI
APERTURE
CARD

DATE	BY	REVISIONS	DATE	BY	REVISIONS	DATE	BY	REVISIONS	DATE	
SCALE NONE	DESIGNED SC	DESIGN CAD								
BECHTEL SAN FRANCISCO PUBLIC SERVICE ELECTRIC AND GAS COMPANY HOPE CREEK GENERATING STATION LOGIC DIAGRAM HIGH RADIATION & LOCA/ISLN SIGNALS FANOUT CHC LOCA HI RAD & LVL 2/ISLN SIGNALS FANOUT										
JOB NO.	DRAWING NO.	REV.								
10355	J-102-0	SH. 4	6							

S/U-GS, KL, HB, GB, EG, SP,
EA, GR, GU, GK, KP, SM

PDR RIDS

8512170086

