


J-50-2 SAT. 9

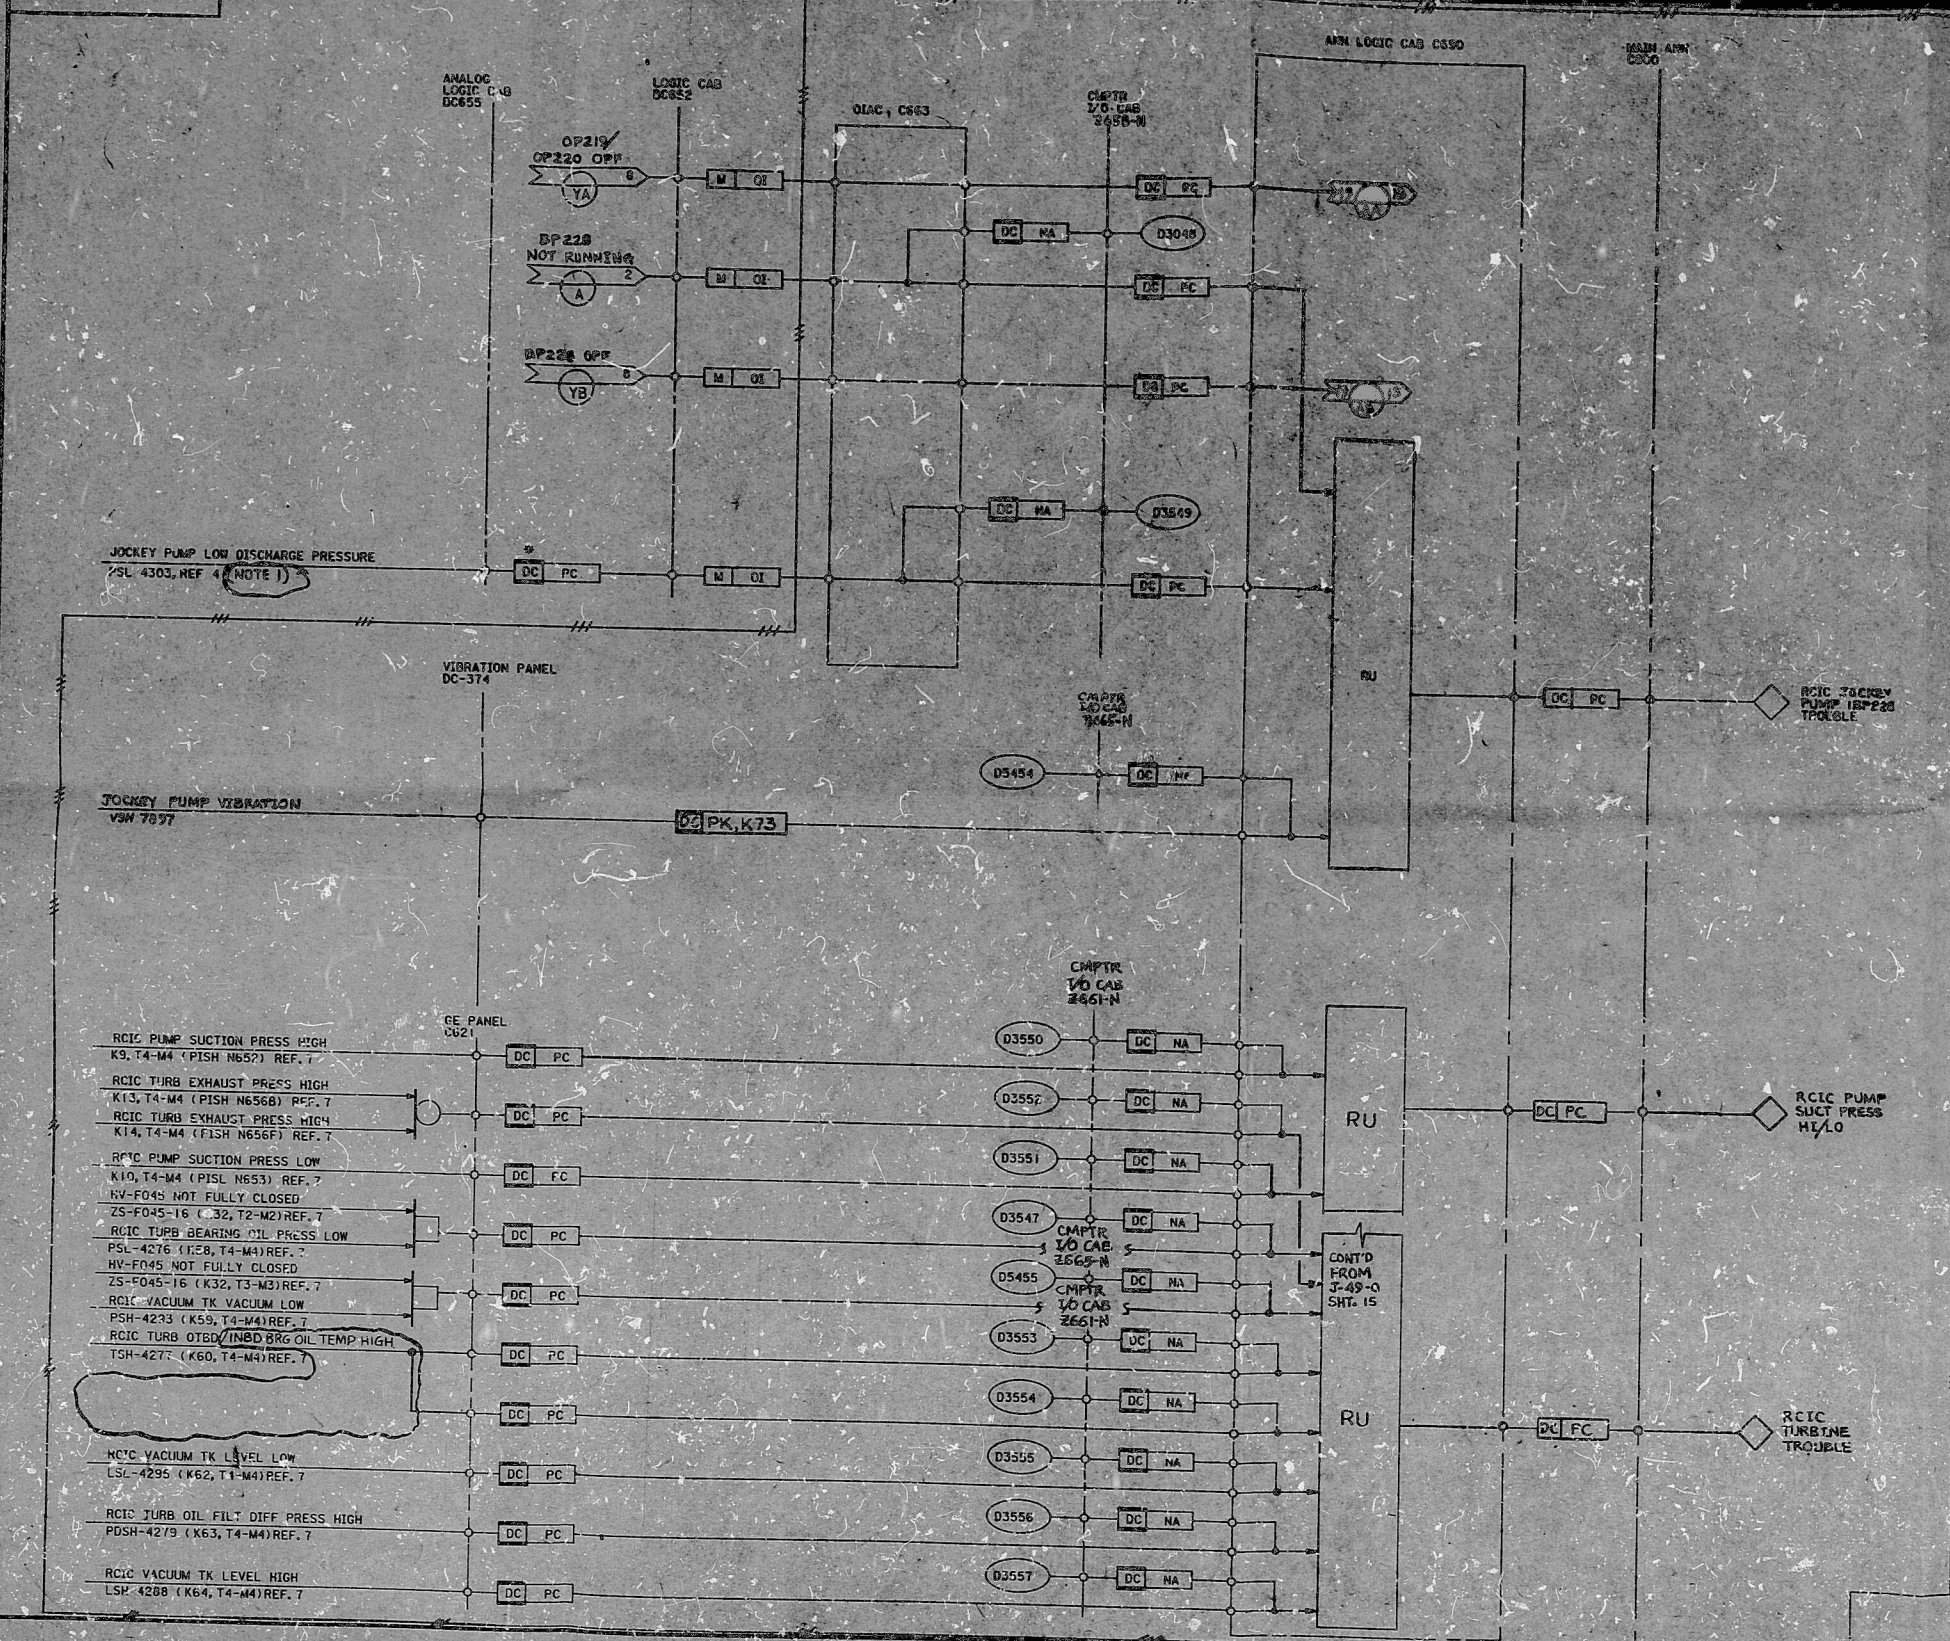

NOTES:
1. CONTACT OPENS ON CONDITION STATED

FTI
APERTURE
CARD

△	UNCL	REVISED TO INCORPORATE SCR 7-466 & FCR 7-50093	SS	AL	W	W	W	W
△	UNCL	ADDED WIRE MARKER DESIGNATOR	SS	W	W	W	W	W
△	UNCL	REVISED INPUTS & LEGENDS ON ANNUNCIATOR	W	W	W	W	W	W
△	UNCL	ISSUED FOR CONSTRUCTION DESIGN THREEZEE ISSUE	W	W	W	W	W	W
DEL	DATE	REVISIONS	BY	OTHER	DATE	DATE	DATE	DATE
ISSUE	NONE	UNCLASSIFIED	TV	THRUOUT	CAD			
DECNTEL SAN FRANCISCO PUBLIC SERVICE ELECTRIC AND GAS COMPANY HOPE CREEK GENERATING STATION LOGIC DIAGRAM RCIC PUMP TURBINE ALARMS								
	JOB NO.		DRAWING NO.			REV.		
	10855		J-50-0 SH. 9			3		0

PDR RIDS

8512170128

