


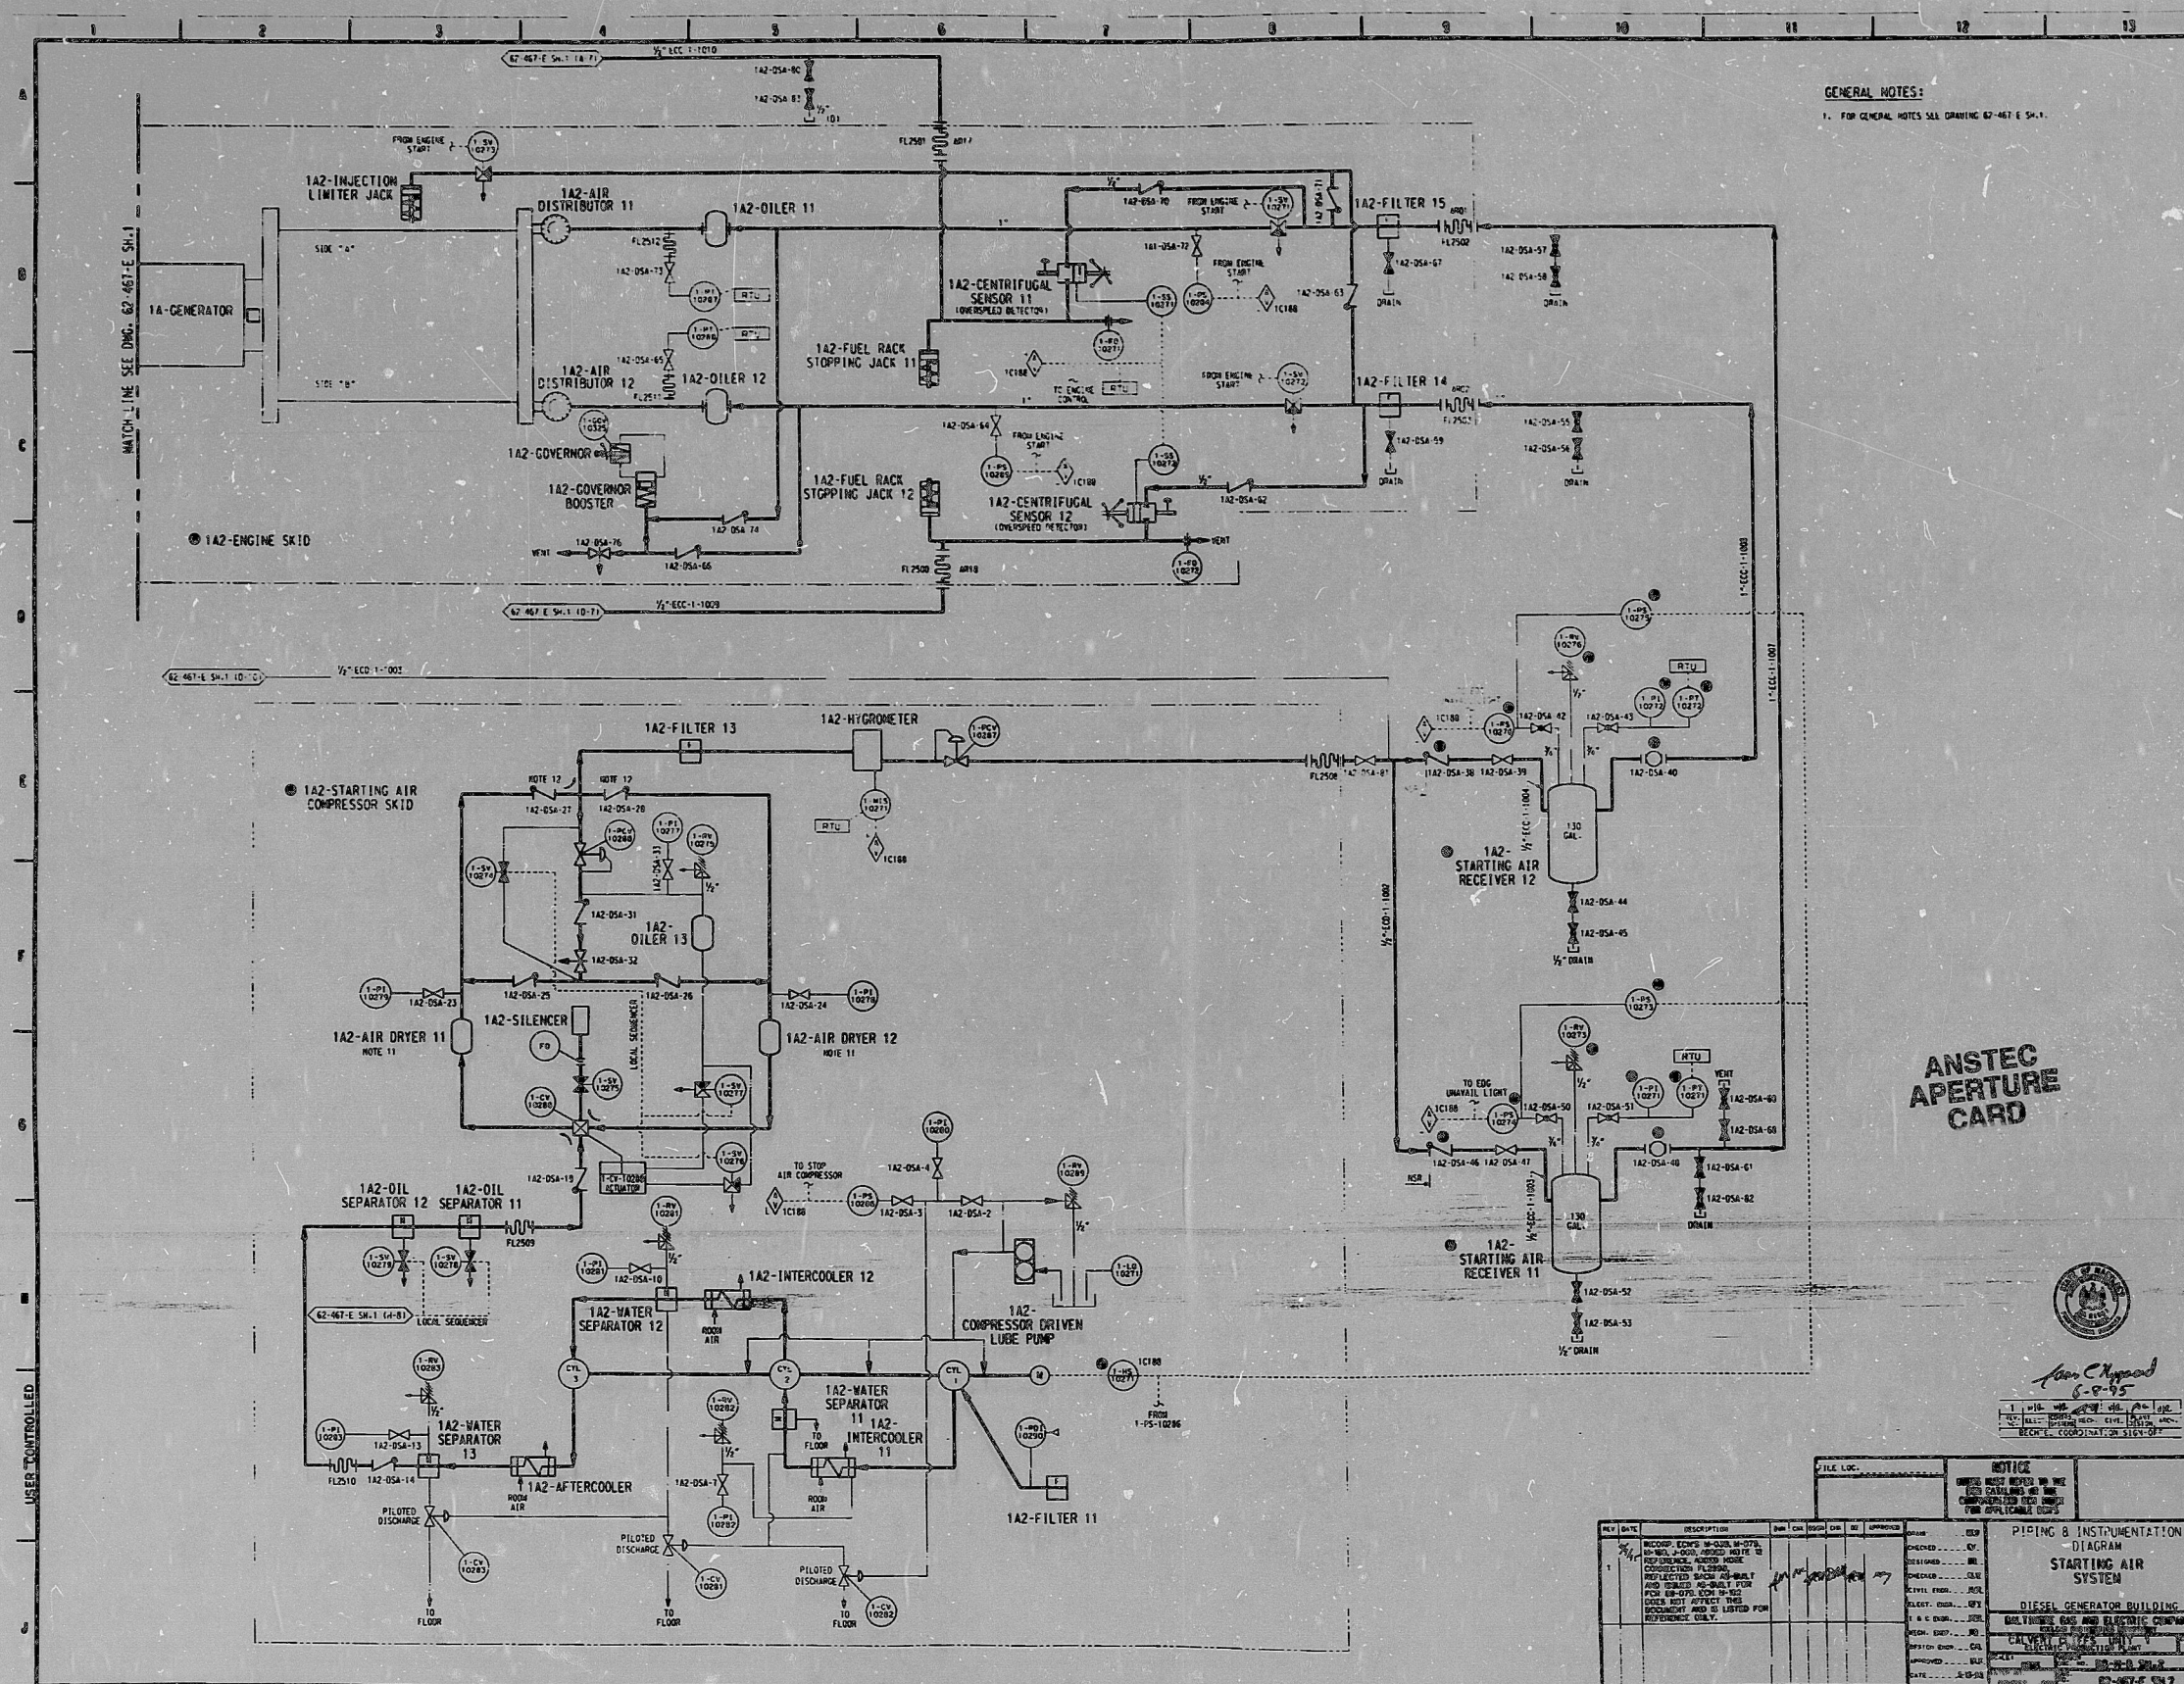

9705140044

PDR RIDS

9705140044

