


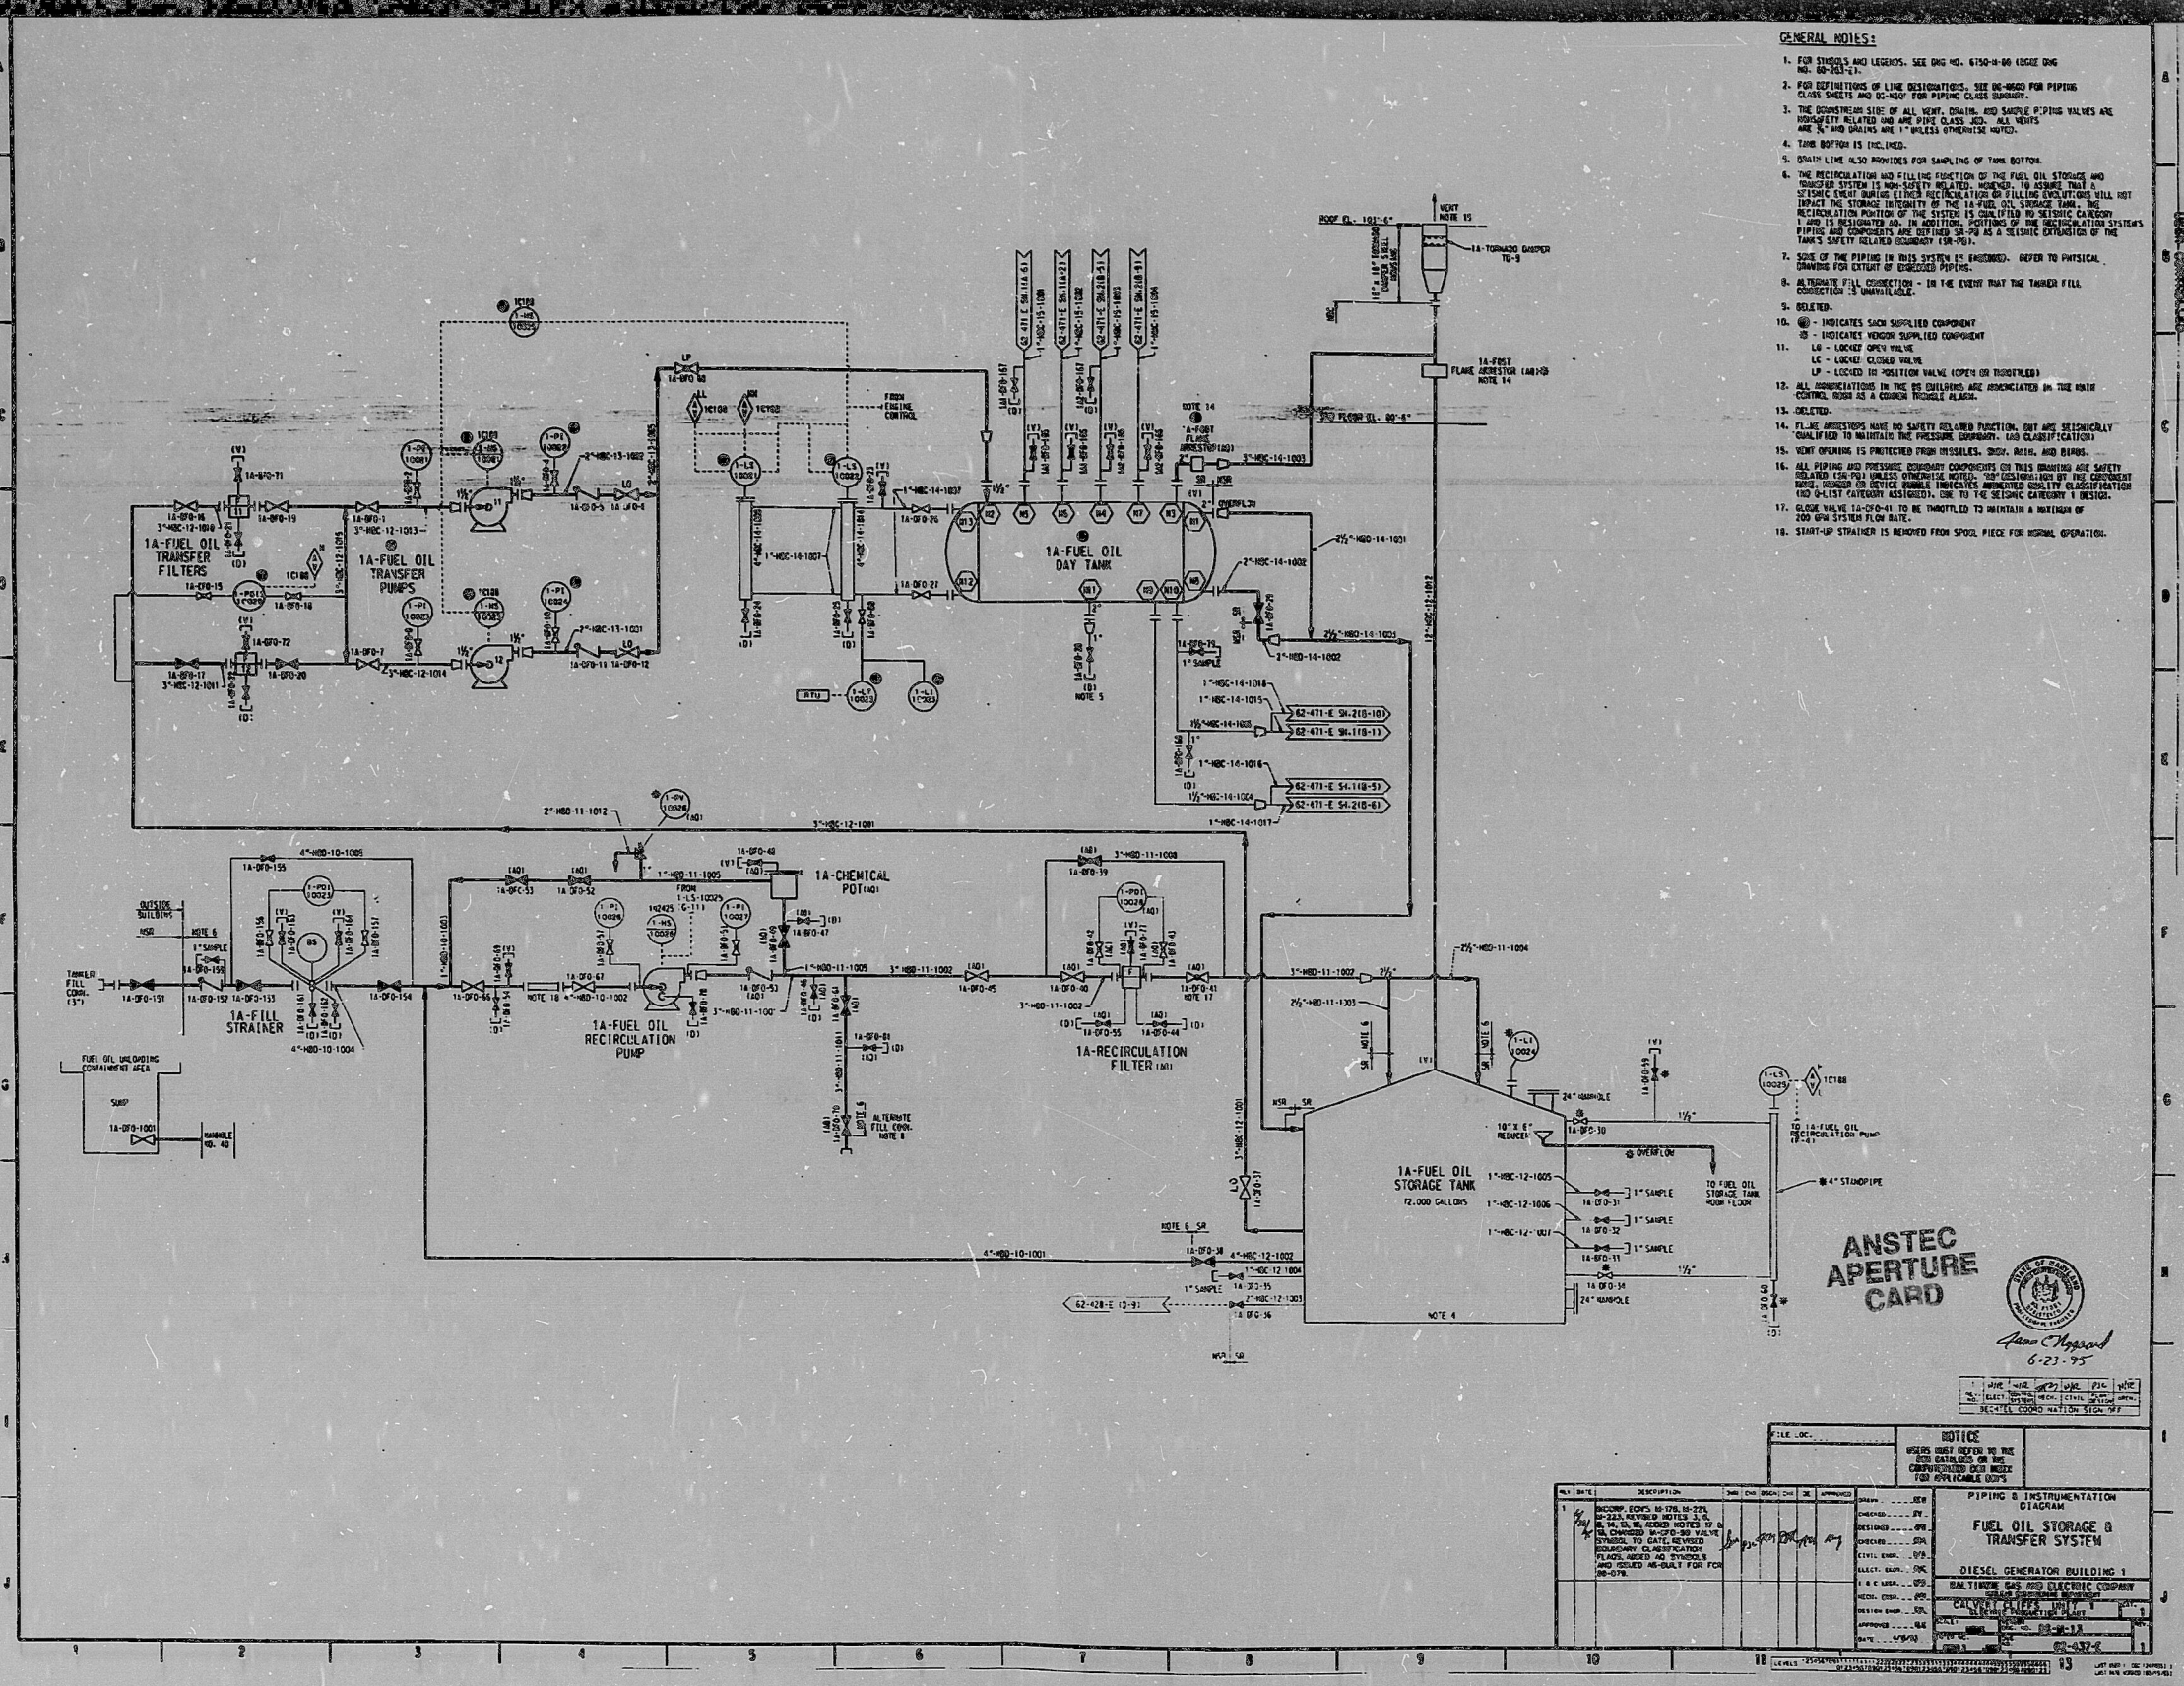

- GENERAL NOTES:**
1. FOR SYMBOLS AND LEGENDS, SEE Dwg No. 6750-H-66 (SHEET 001) AND 6750-H-66 (SHEET 002).
 2. FOR DEFINITIONS OF LINE IDENTIFICATIONS, SEE 6750-H-66 (SHEET 001).
 3. THE DOWNSTREAM SIDE OF ALL VENT, DRAIN, AND SAMPLE PIPING VALVES ARE POSITIVELY RELATED AND ARE PIPE CLASS 100. ALL VENTS ARE 1/2\"/>

ANSTEC APERTURE CARD

Ann Chappard
6-23-95

NOTICE		PIPING & INSTRUMENTATION	
GENERAL NOTE: THE Dwg NO. 6750-H-66 (SHEET 001) AND 6750-H-66 (SHEET 002) ARE THE AUTHORITY FOR THE INFORMATION CONTAINED HEREIN.		DIAGRAM	
9705140047

PDR *KLWS*

9705140047

