


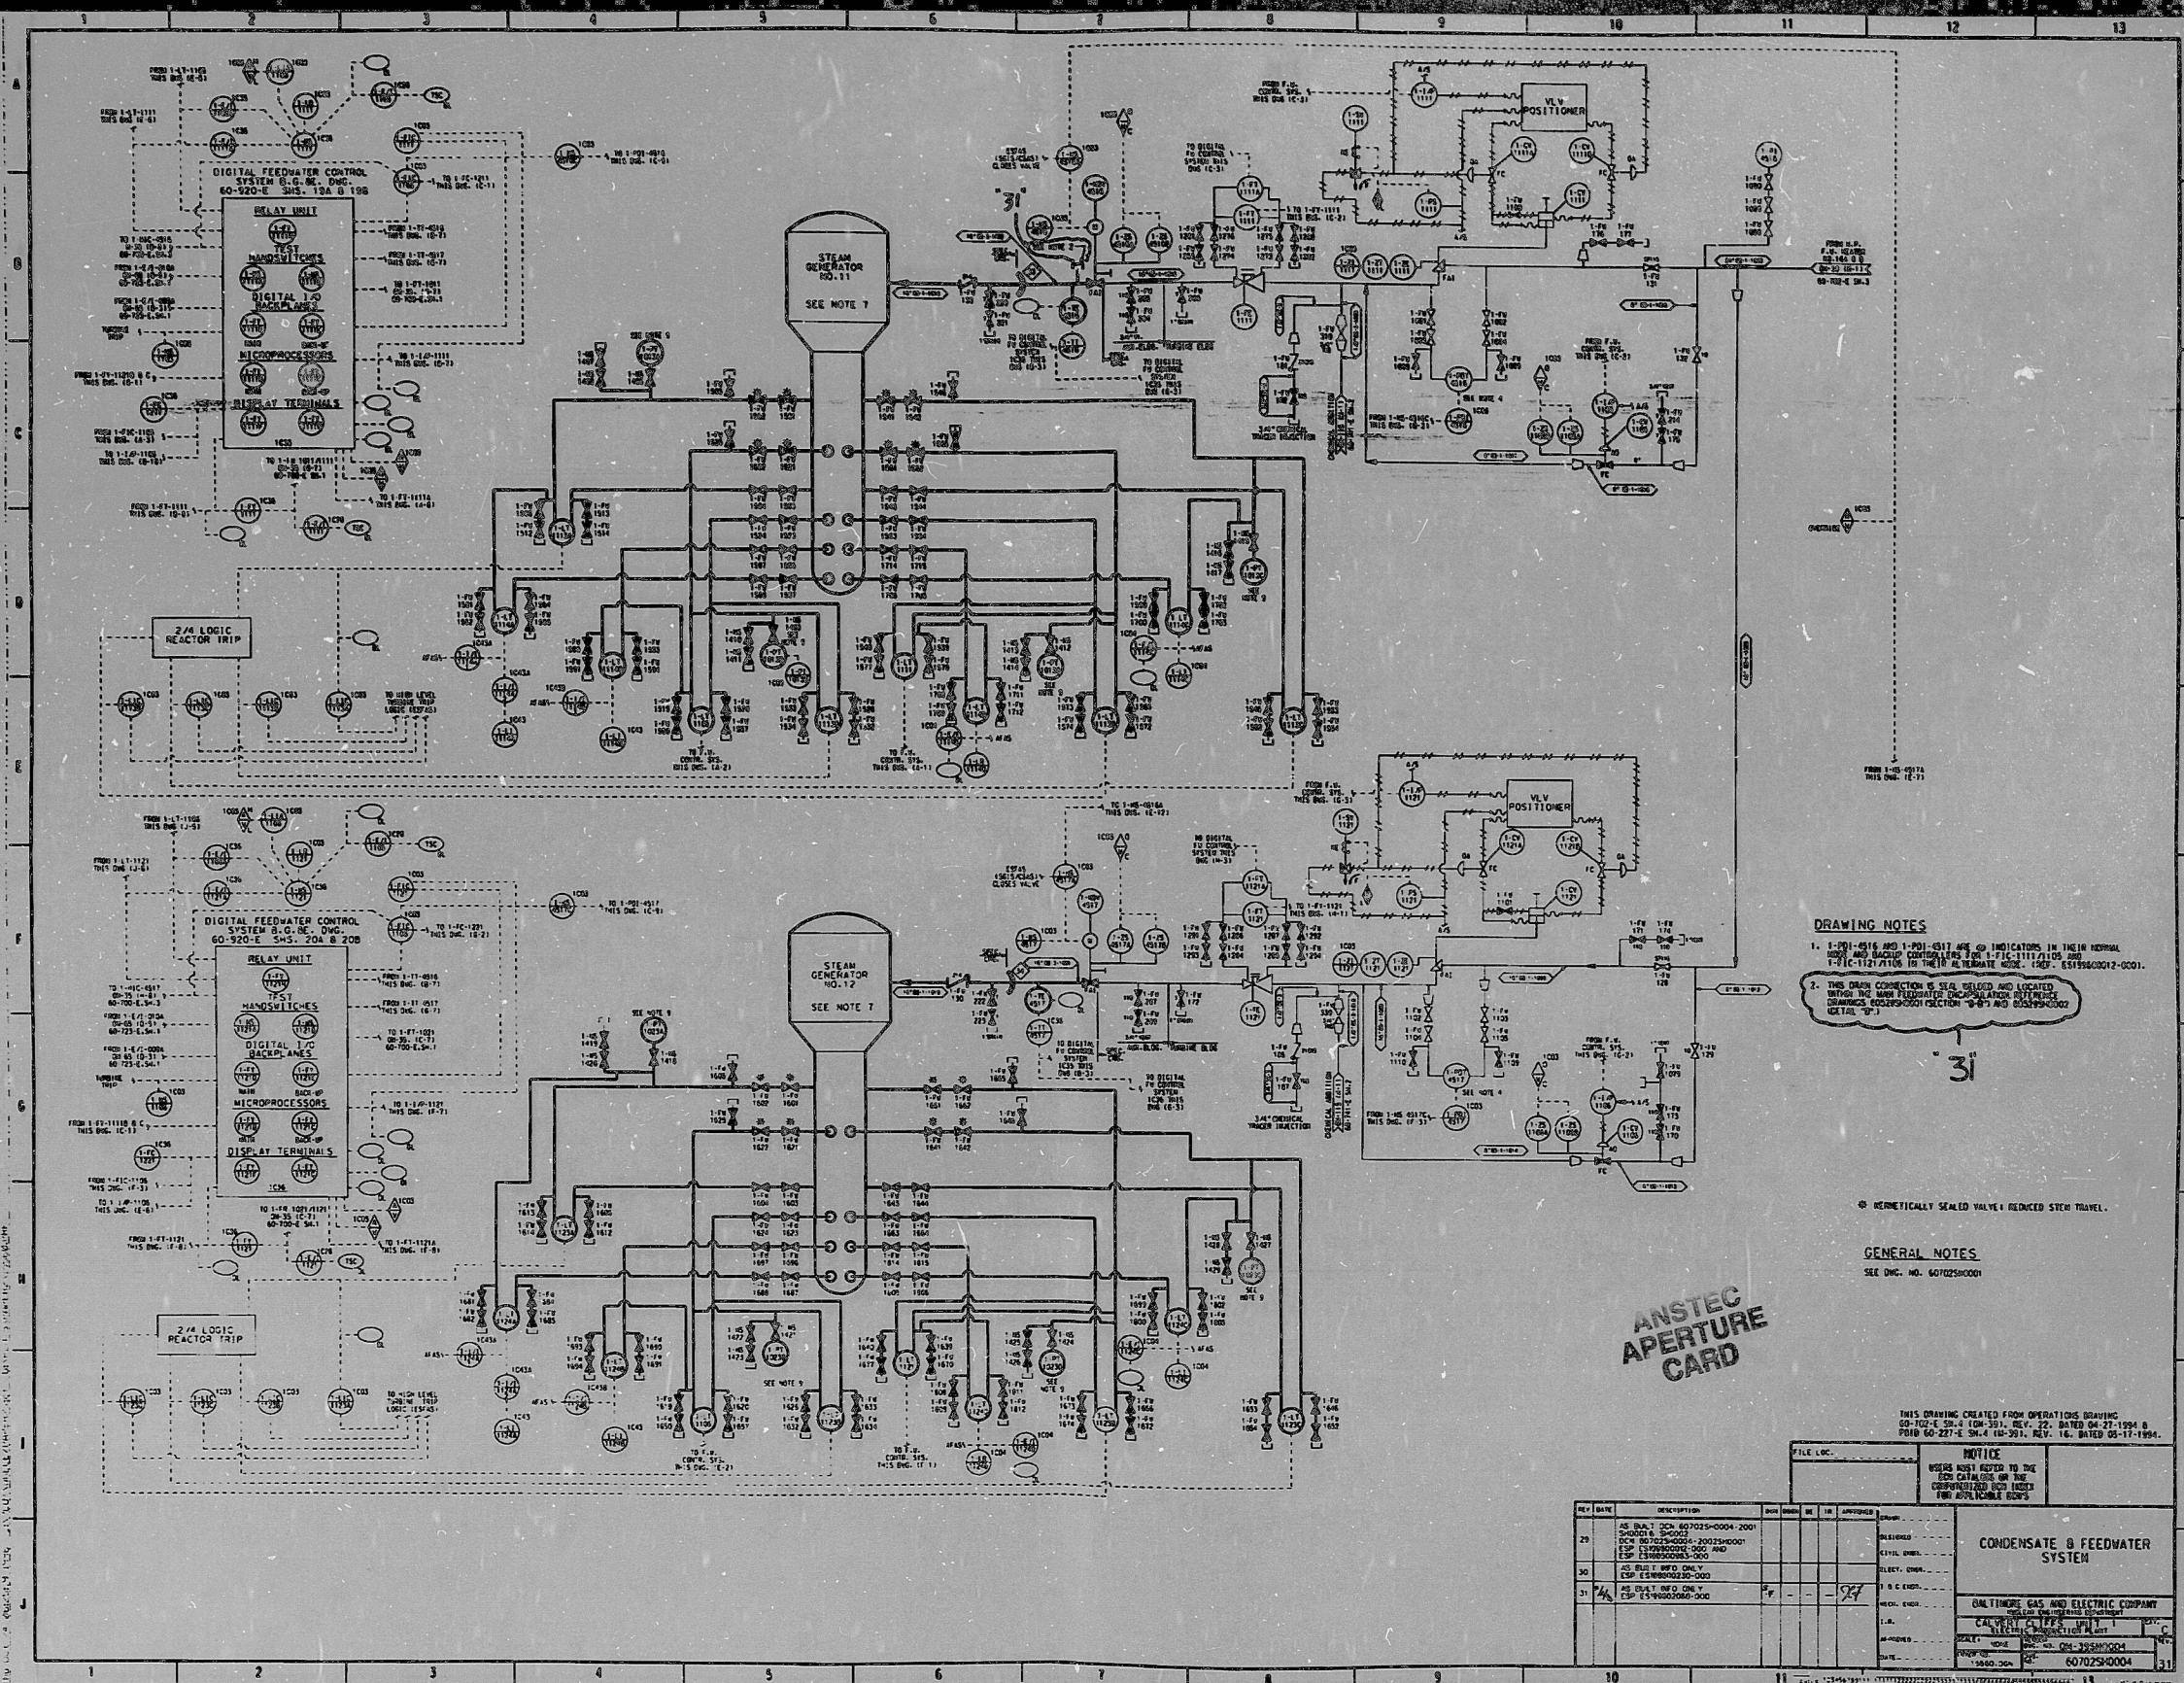



9705140058

PDR RIDS

9705140058

