


11825-FM-89B

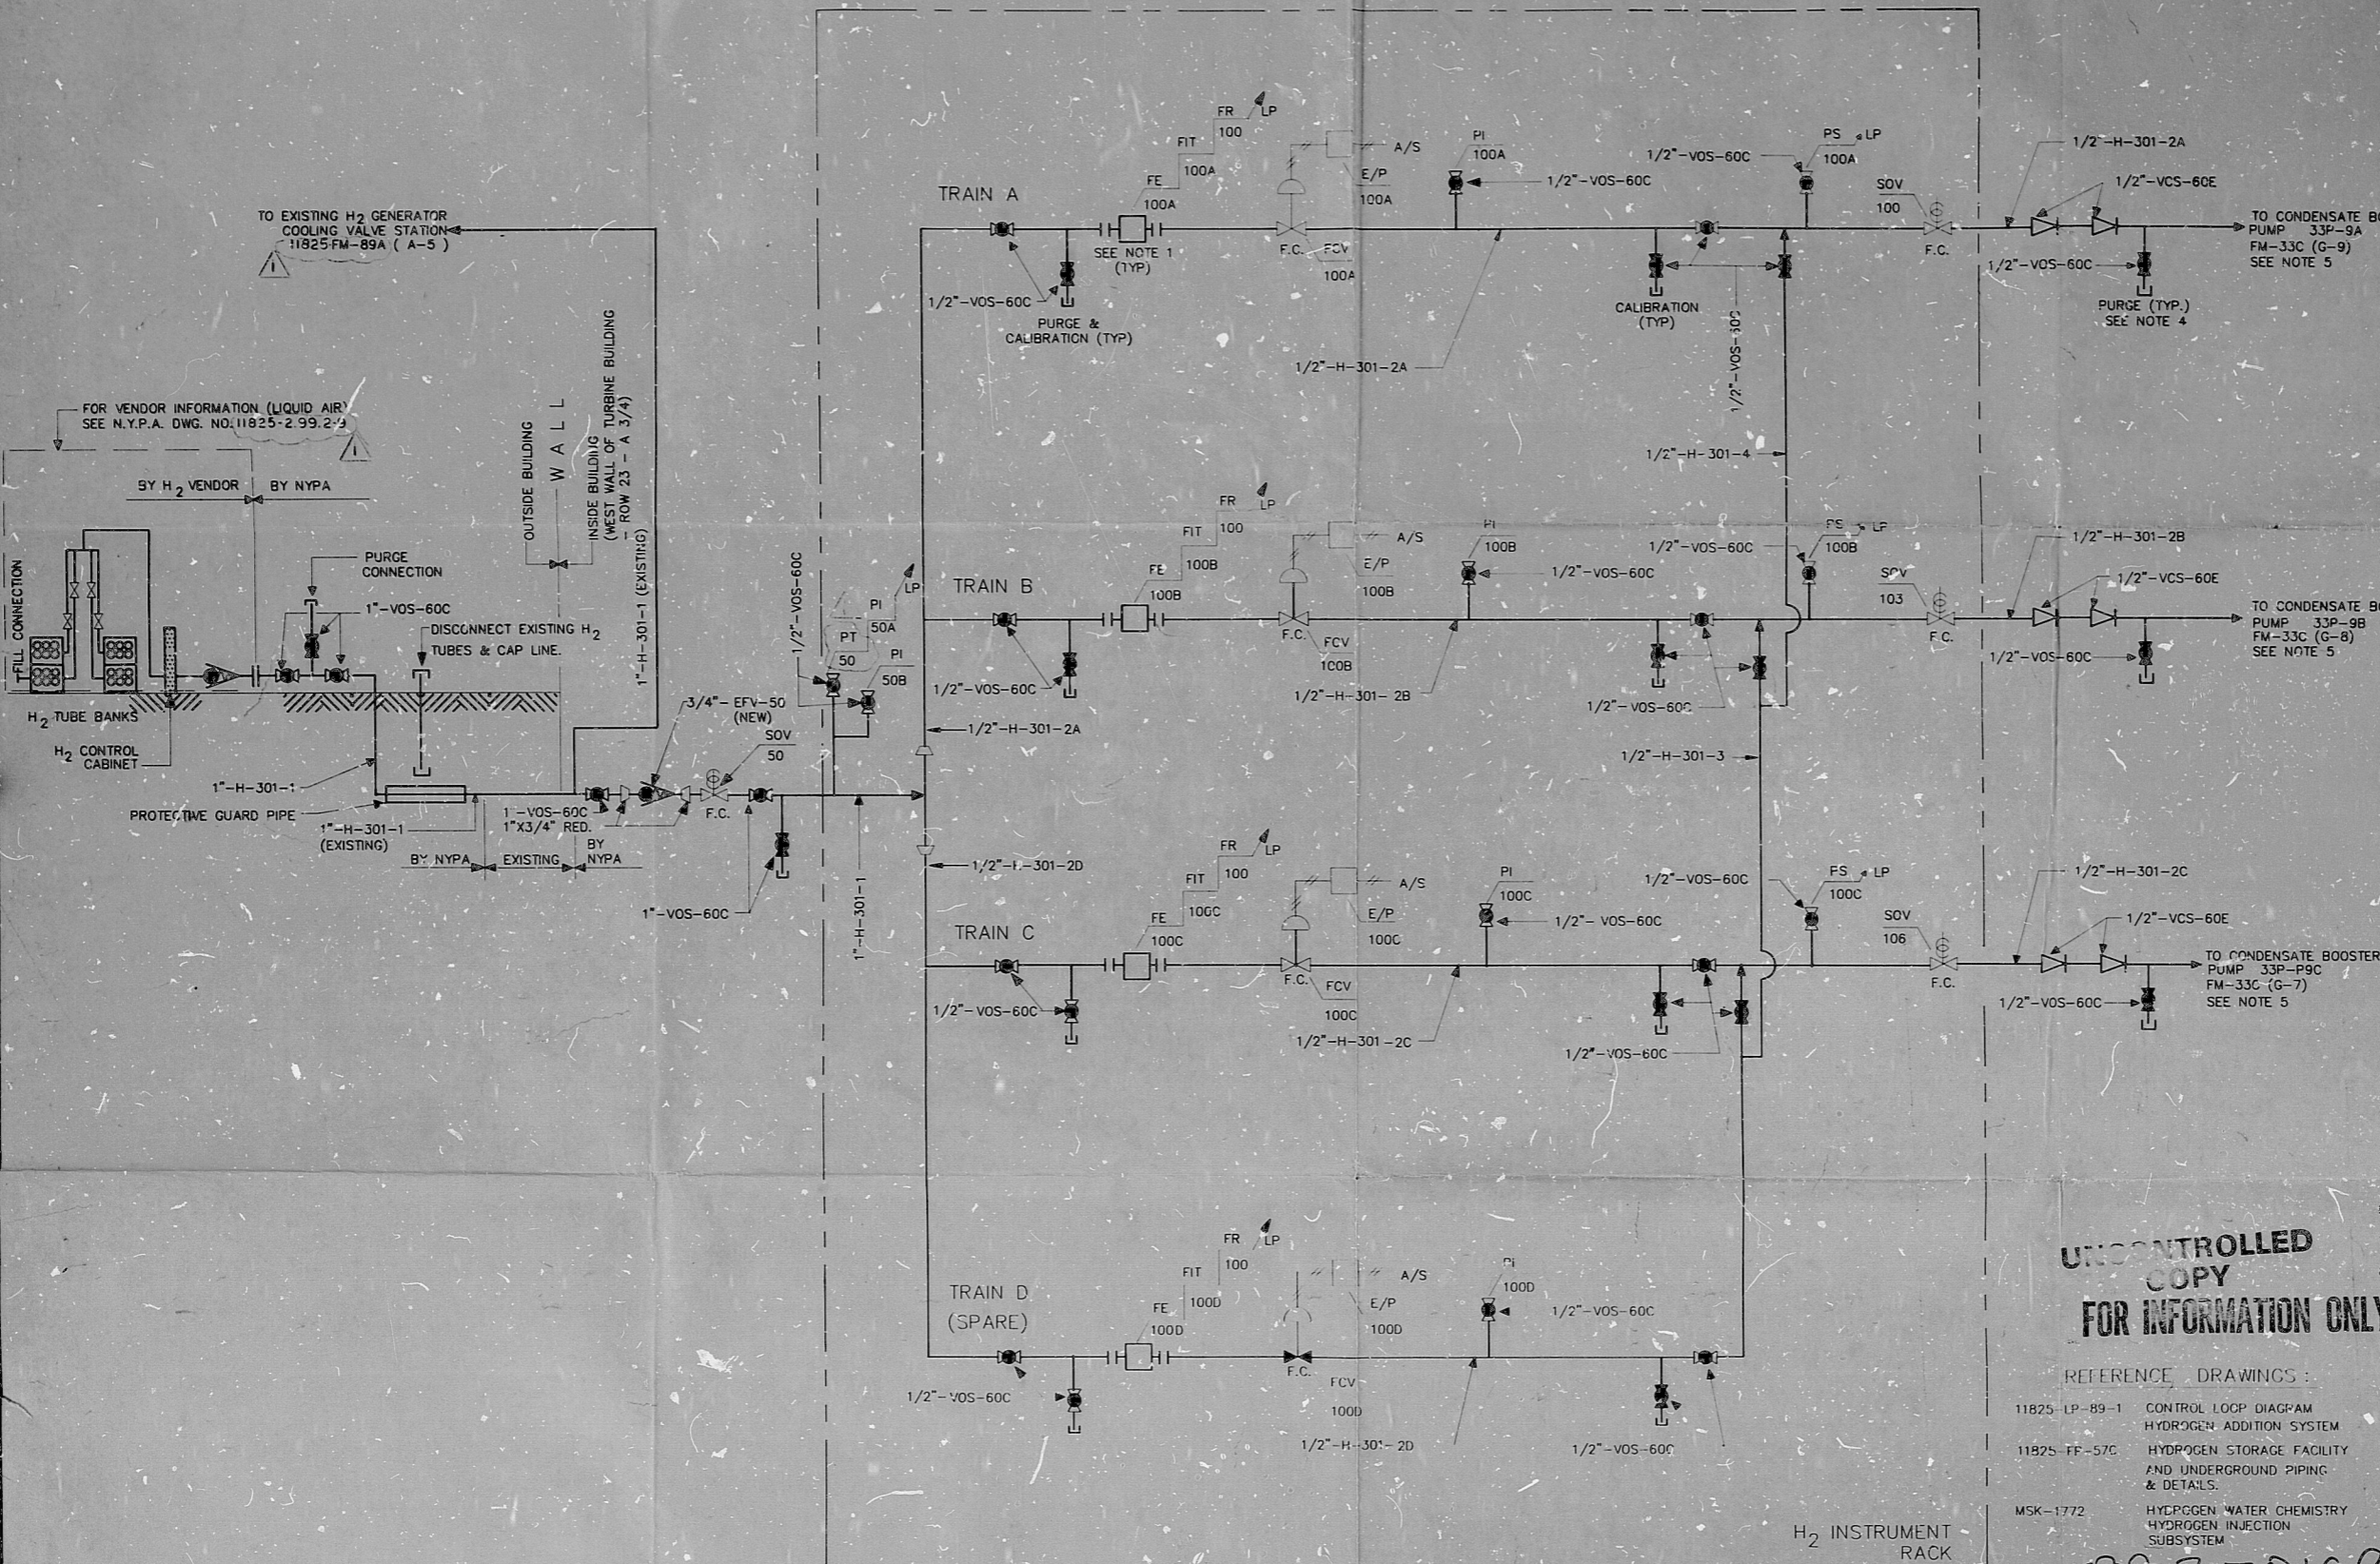

- NOTES:**
1. MASS FLOW METER
  2. F.C. - FAIL CLOSED  
F.O. - FAIL OPEN  
L.P. - LOCAL PANEL
  3. DELETED
  4. PURGE SHALL BE LOCATED NEAR THE EXISTING VALVE
  5. EXISTING TAP IMMEDIATELY DOWN-STREAM OF THE CHEMICAL CLEANING SPOOL PIECE.
  6. ALL VALVES AND INSTRUMENTS ARE SYSTEM 89
  7. 1"-GLOBE VALVES ARE BELLOW GLOBE VALVE, VOGT MODEL 5W42141B
  8. 1/2"-GLOBE VALVES ARE PACKLESS METAL DIAPHRAGM GLOBE VALVE, KEROTEST MODEL 54PSW-24C  
1/2"-CHECK VALVE ARE BONT PISTON CHECK VALVE, KEROTEST MODEL 6012-71

**UNCONTROLLED COPY FOR INFORMATION ONLY**

- REFERENCE DRAWINGS:**
- 11825-LP-89-1 CONTROL LOOP DIAGRAM HYDROGEN ADDITION SYSTEM
  - 11825-TF-57C HYDROGEN STORAGE FACILITY AND UNDERGROUND PIPING & DETAILS.
  - MSK-1772 HYDROGEN WATER CHEMISTRY HYDROGEN INJECTION SUBSYSTEM

8803170199

III APERTURE CARD

REV. FILM	REVISION	PREP. BY	CHK'D. BY	APP'D. BY	DATE	REV. FILM	REVISION
							FOR CONSTRUCTION	A.A.	E.D.S.	M.J.G.	1/11/87	A													
							REVISIED AS NOTED, ISSUED FOR CONST.	R.S.	KELCHER	M.G.	8-3-87	B													
							GENERAL REVISION	A.A.	EDS	M.J.G.	12/4/86	C													
							APPROVED FOR DESIGN	A.A.	EDS	DAS	8/22/88														
							FOR COMMENTS	A.A.	EDS	STS	7/15/86														

Q.A. CAT. II  
 MOD. NO. FI-85-102  
 CAD FILE #T-7420M001  
 STEARNS Catalytic  
 NEW YORK POWER AUTHORITY  
 JAMES A. FITZPATRICK NUCLEAR POWER PLANT  
 FLOW DIAGRAM - HYDROGEN ADDITION SYSTEM  
 HYDROGEN INJECTION SYSTEM  
 CONTRACT NO. 70420  
 Dwg. No. 11825-FM-89B  
 REV. NO. 1

PDR RIDS

8803170199

